


WASHINGTON STREET

66'

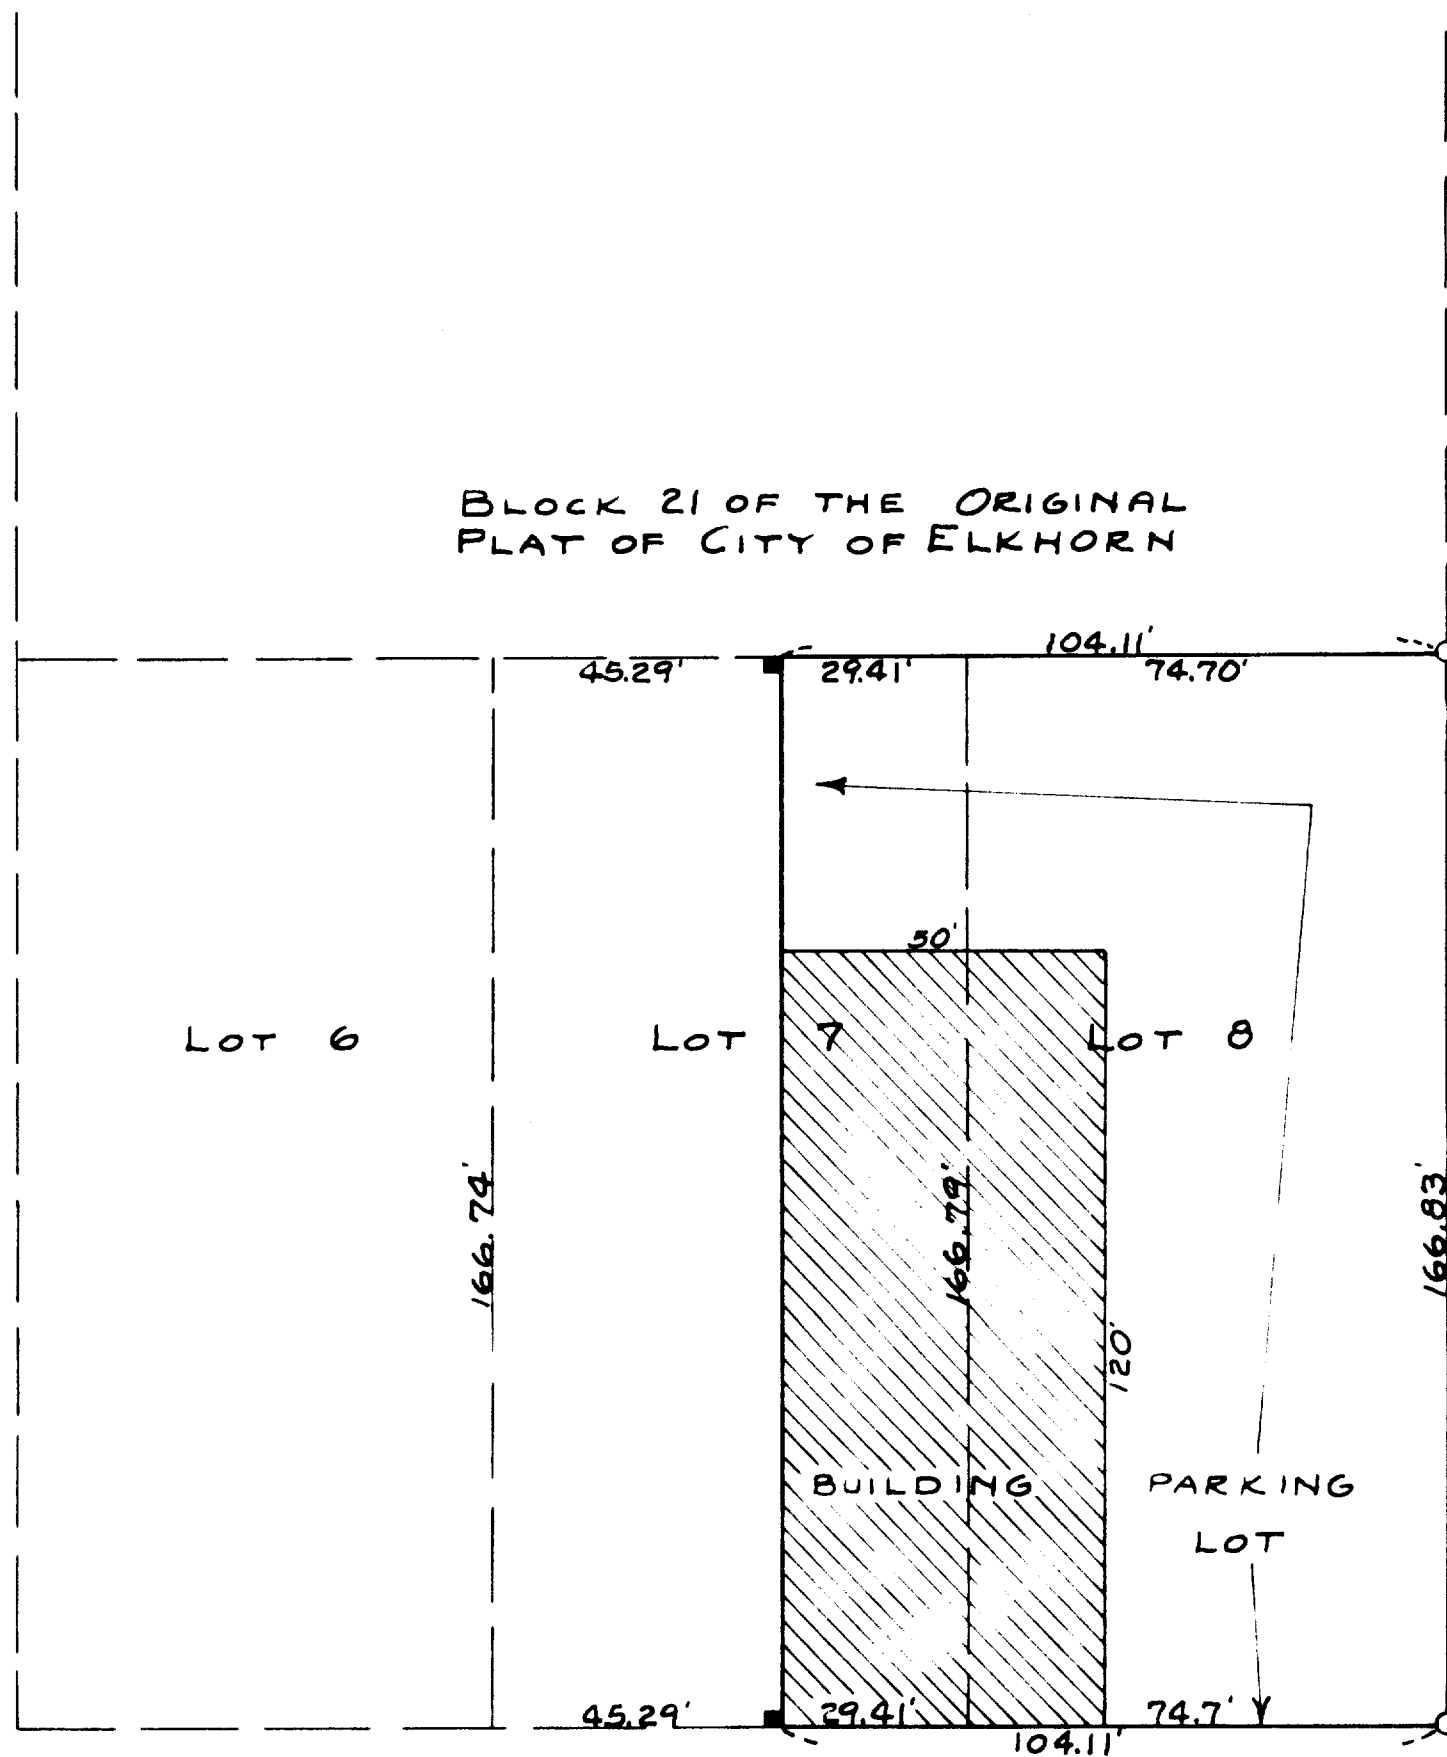

LINCOLN STREET

66'

WALWORTH STREET


STREET

100'

PLAT OF SURVEY OF LOT 7, EXCEPT THE WEST
45 FEET AND 3½ INCHES, AND LOT 8 OF BLOCK 21
OF THE ORIGINAL PLAT OF THE CITY OF
ELKHORN, WALWORTH COUNTY WISCONSIN.

OCT. 6, 1949

Lloyd L. Jensen
WALWORTH COUNTY SURVEYOR

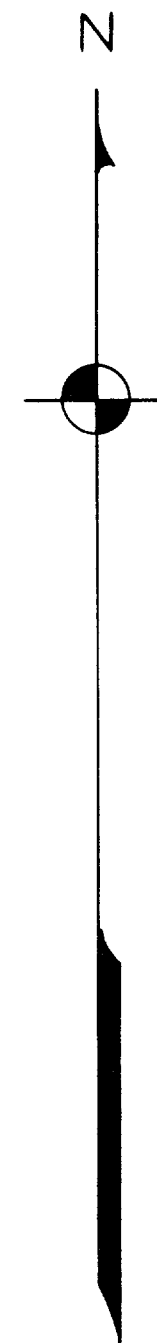

○-IRON PIPE
SCALE 1"=30'
■-CONC. MONU.