

PLAT OF SURVEY of Lot 1, Block 4, Original Plat, City of Elkhorn,
except the North 5 feet of the East 99 feet of said Lot 1, located
in the City of Elkhorn, Walworth County, Wisconsin.


May 15, 1978

Surveyed for: Richard & Marilyn Lechner
308 N. Wisconsin St. Elkhorn, Wisconsin 53121

Recorded in: Vol. 190 P. 229 & 230 Deeds.

I certify that I have surveyed the above described property and that the
plat shown hereon is an accurate survey and a true representation thereof
and correctly shows the boundary lines and all divisions thereof.

Thomas P. Jensen
Thomas P. A. Jensen S-1084
JENSEN SURVEYING & MAPPING
ELKHORN, WISCONSIN

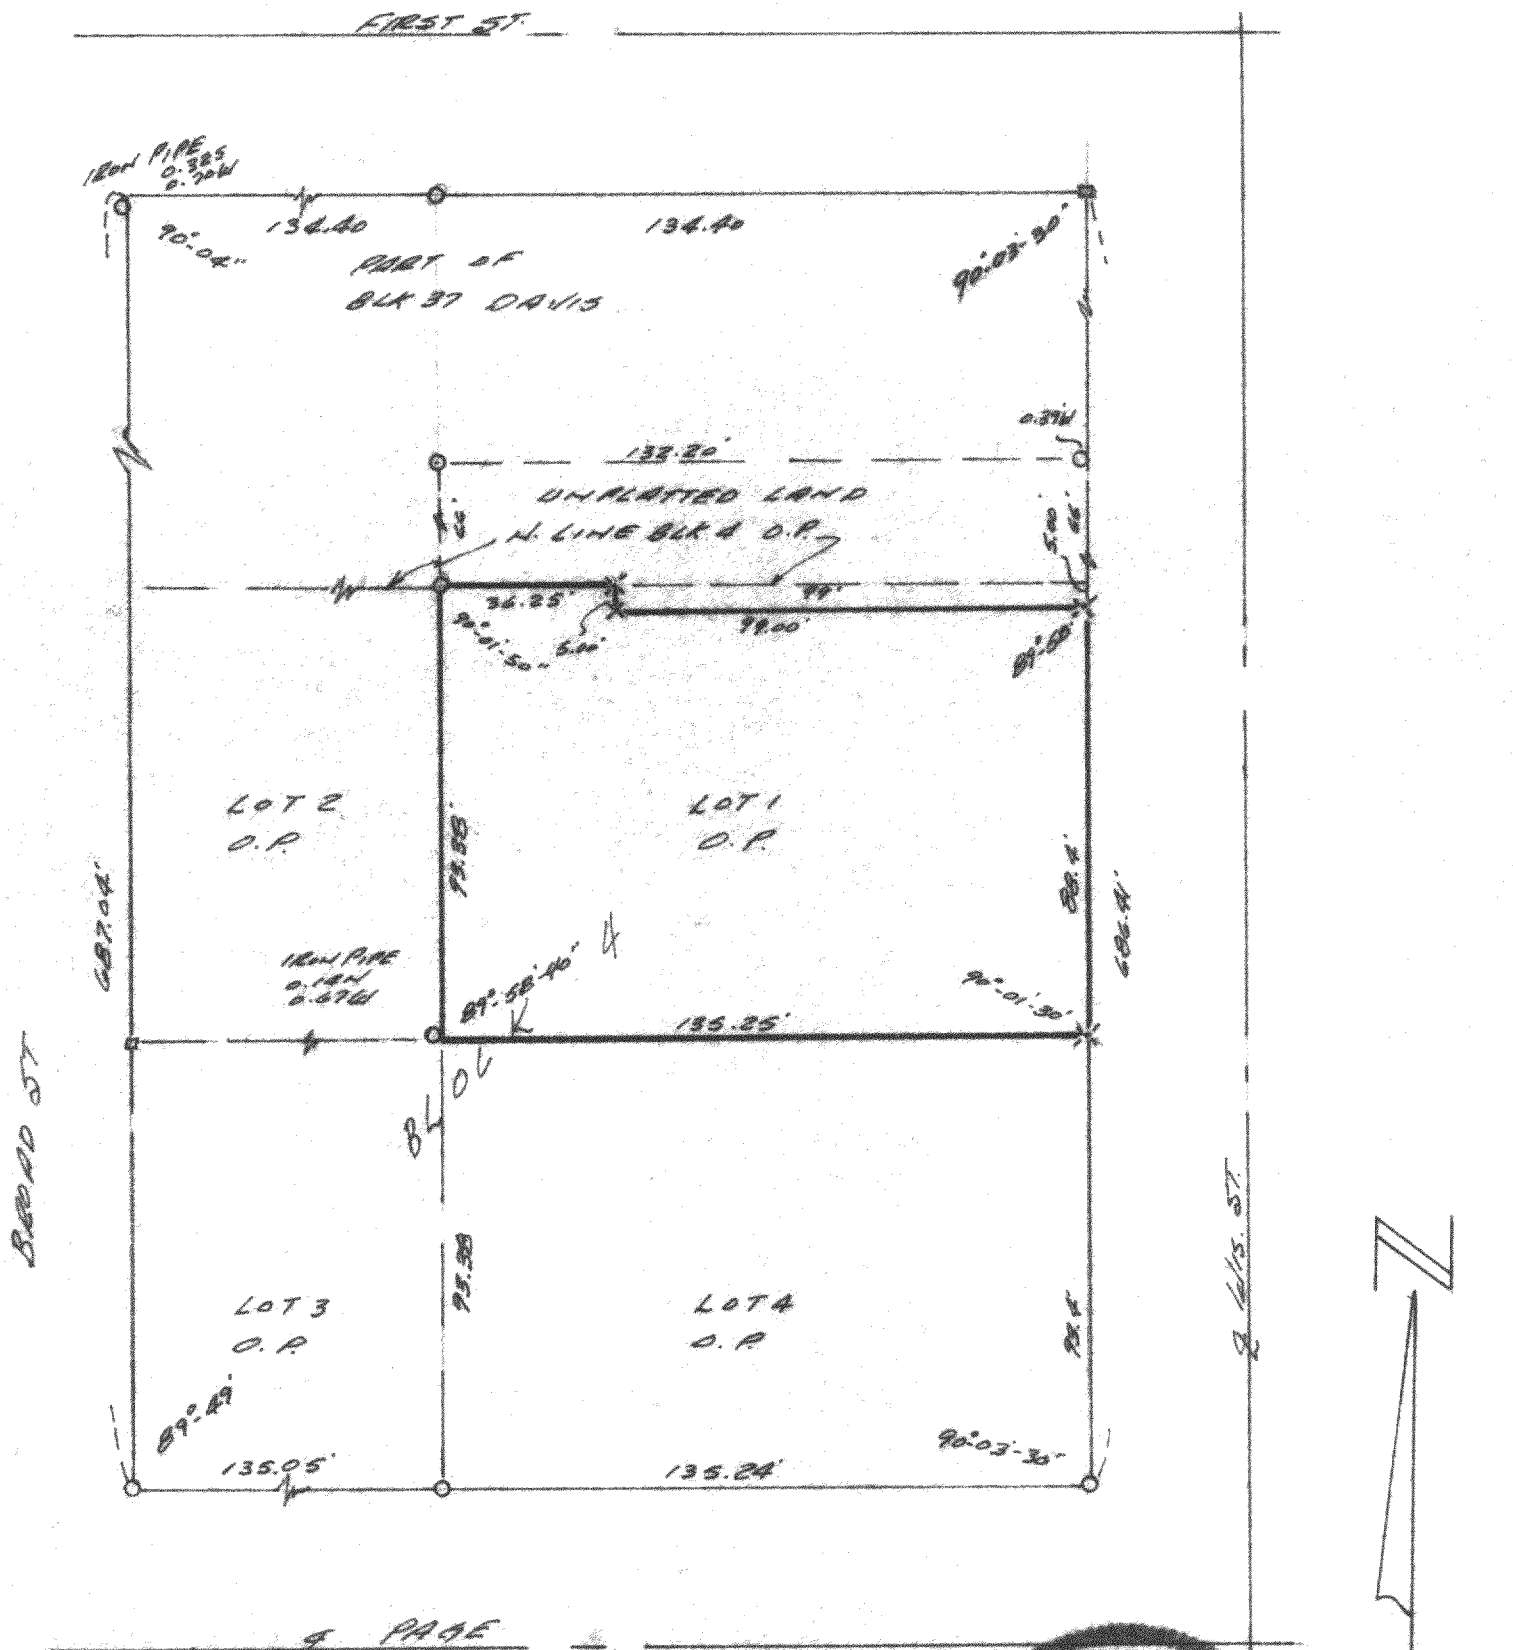

○ ~ IRON PIPE FOUND
□ ~ IRON ROD FOUND
X ~ CROSS CUT IN CONCRETE &
PAINTED

