


**Scale in Feet**  
1" = 20'

5 South Wisconsin Street | P.O. Box 322  
Elkhorn, Wisconsin. 53121  
Telephone: (262) 723-3434  
Facsimile: (262) 723-8044  
Email: [doug@olsonsurveying.com](mailto:doug@olsonsurveying.com)  
Website: [www.olsonsurveying.com](http://www.olsonsurveying.com)

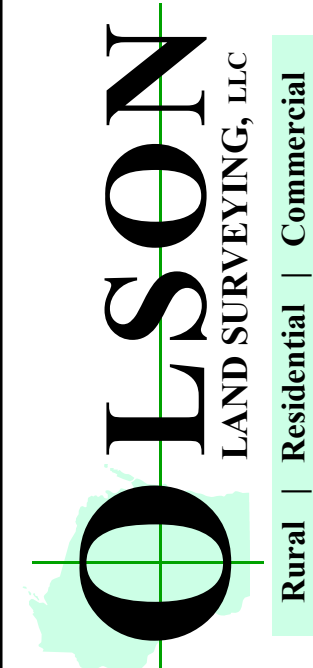

**Legend**

of Symbols & Abbreviations

Found County Section Corner  
Found Iron Pipe    Found Ciseled Cross  
Found Iron Rod    Found Railroad Spike  
Found Section Line    Found Set Wood Lath  
Recorded Information  
Utility Pole    Light Pole  
Utility Pedestal    Hydrant  
Concrete Cover    Gas Sign or Flare Optic  
Asphalt Surface    Water Valve  
Concrete Surface    Bollard  
Gravel Surface

North  
South  
East  
West  
In Bearing  
In Distance  
In Seconds  
In Feet  
In Inches  
No Number  
NE North  
SE South  
SW South  
NW North

<div> <div>2022.097</div> </div>	<div> <div>Sheet 1 of 1 Sheets</div> </div>
	<div> <div>Drawing Name:</div> </div>
	<div> <div>Job Reference Number</div> <div>2022.097</div> </div>