
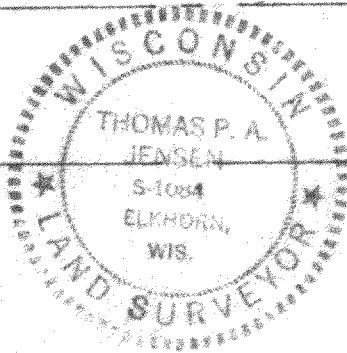


I hereby certify that I have surveyed the above described land and that the plat shown hereon is a correct representation of said survey.

Nov. 17, 1978

Surveyed for: James Jones  
Elkhorn, Wis.

*Thomas P.A. Jensen*  
Thomas P.A. Jensen S-1084  
JENSEN SURVEYING & MAPPING  
ELKHORN, WISCONSIN

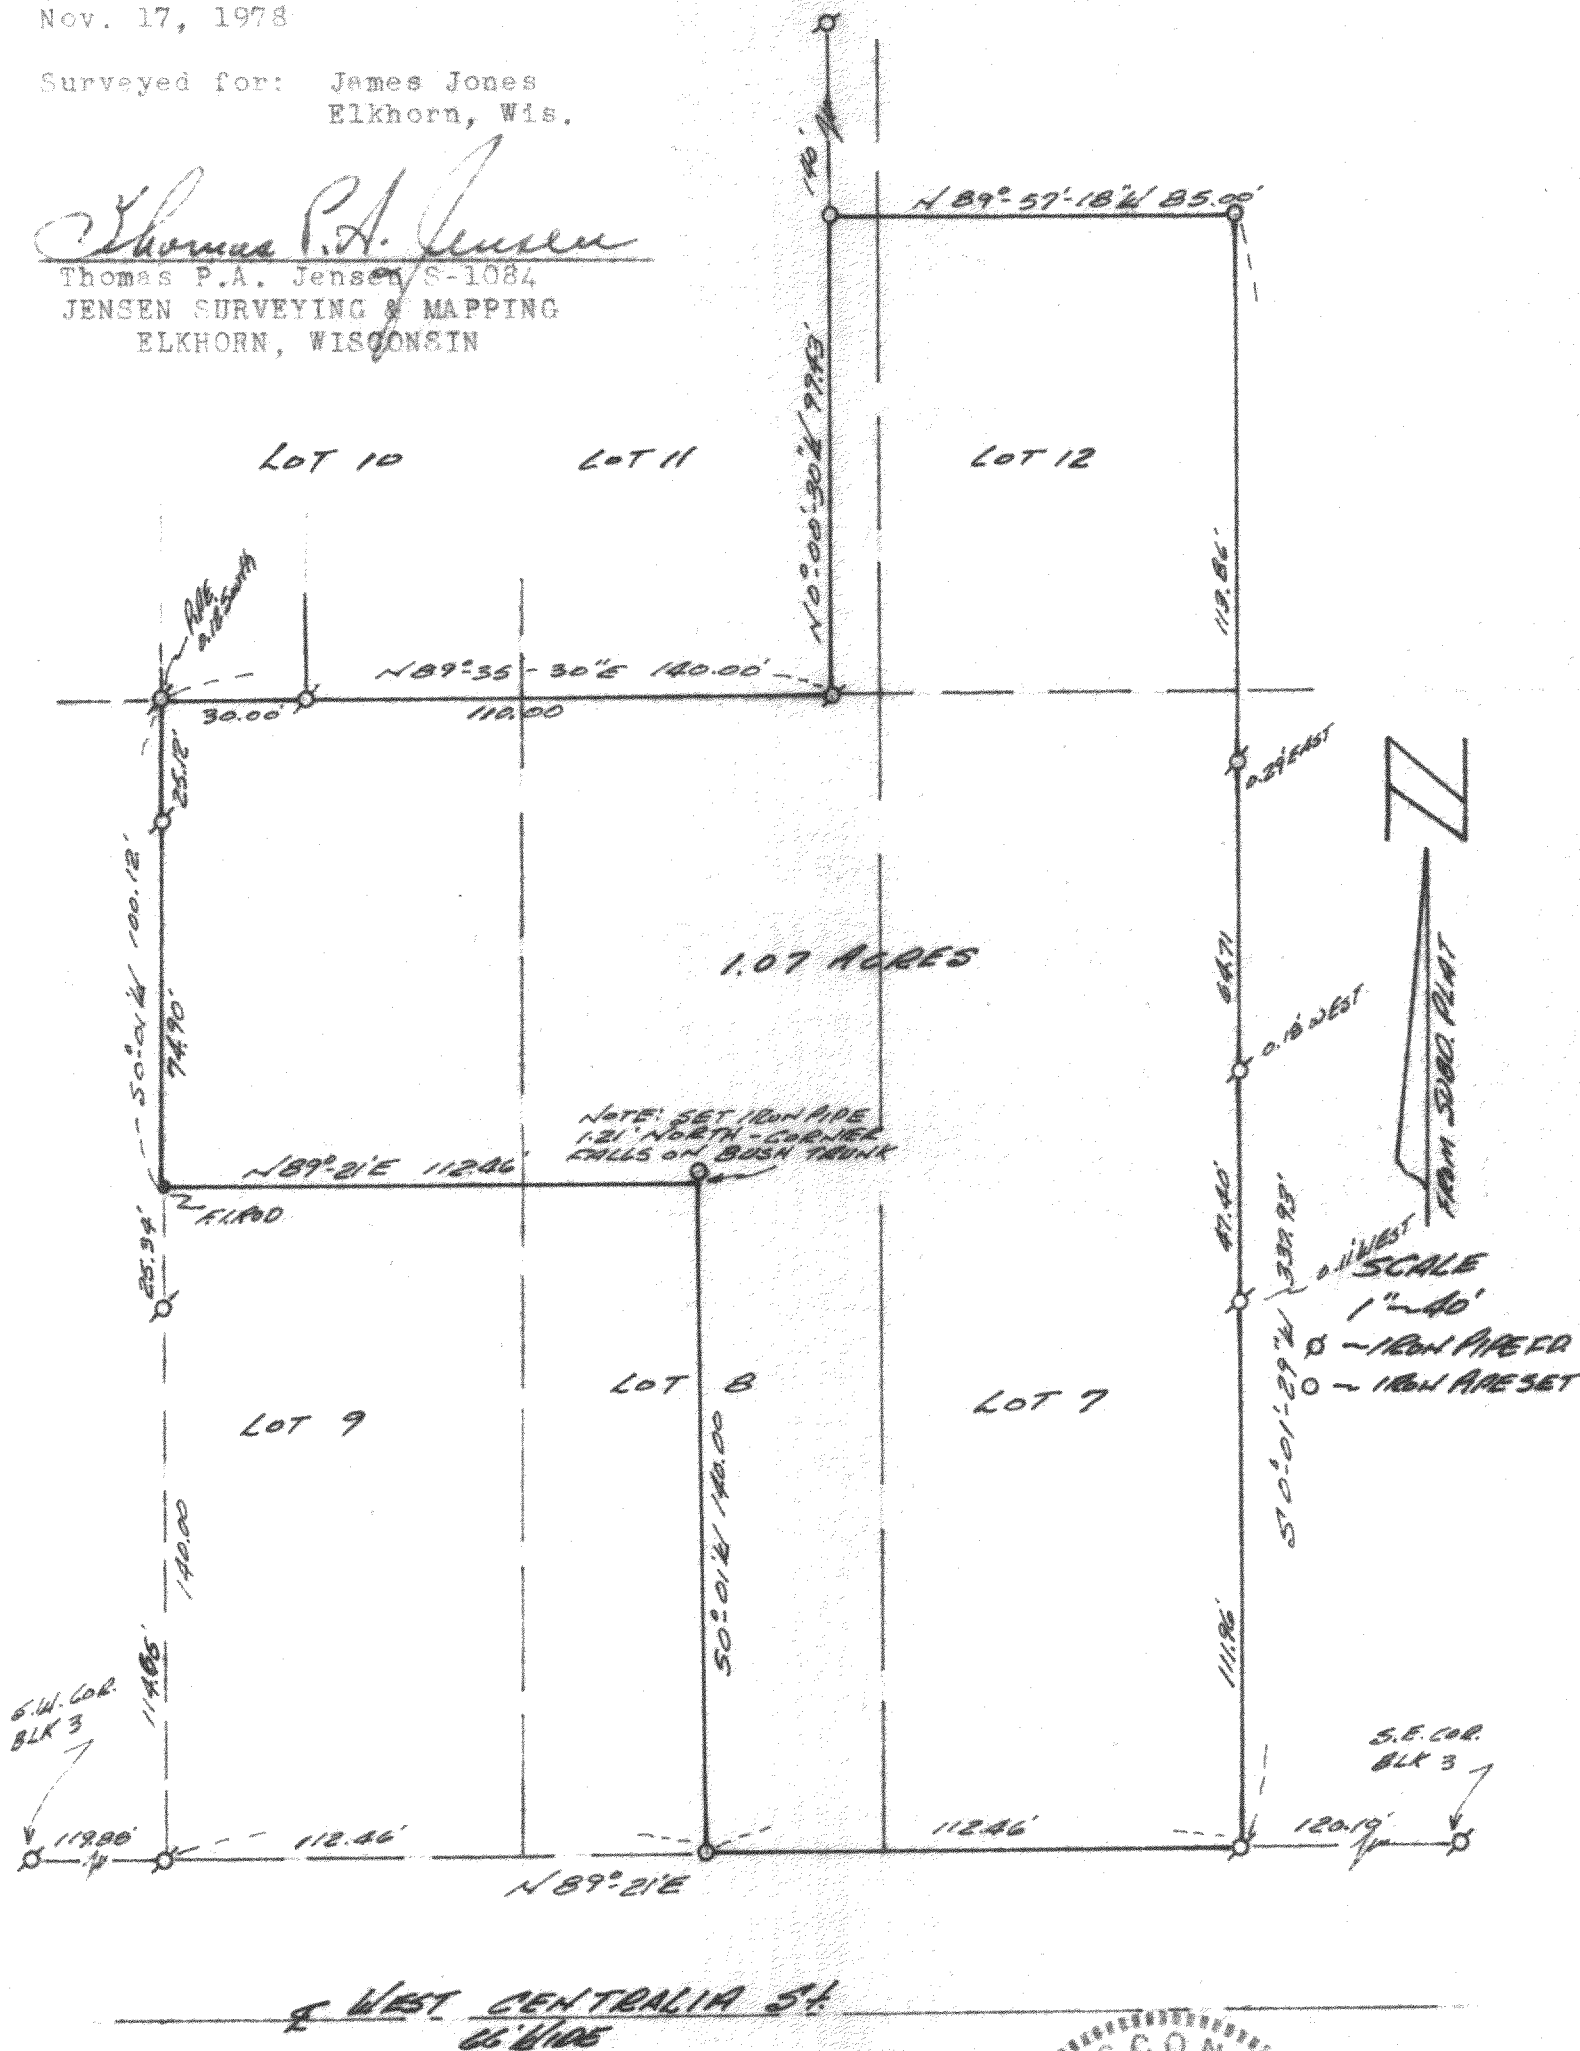

YJA2 - 38 + JA2-42  
39

4-278 J ✓