


PLAT OF SURVEY

OF LOT 8 OF EDGEWOOD ESTATES 1ST ADDITION
LOCATED IN THE NW 1/4 OF THE NE 1/4 OF SECTION 36,
T3N, R16E, WALWORTH COUNTY, WISCONSIN

RECORDED IN CAB. "B" SLIDE 24
WALWORTH COUNTY, SUBDIVISION PLATS

SURVEYED FOR: ROBT. BEHRENS
W. 4TH AVE.
ELKHORN, WIS.


JENSEN SURVEYING & MAPPING
ELKHORN, WIS.

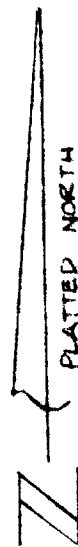

SCALE 1" = 50'

LEGEND

- - IRON PIPE 2" DIA. FOUND
- - IRON PIPE 1" DIA. FOUND
- ⊙ - IRON PIPE 1" DIA. SET

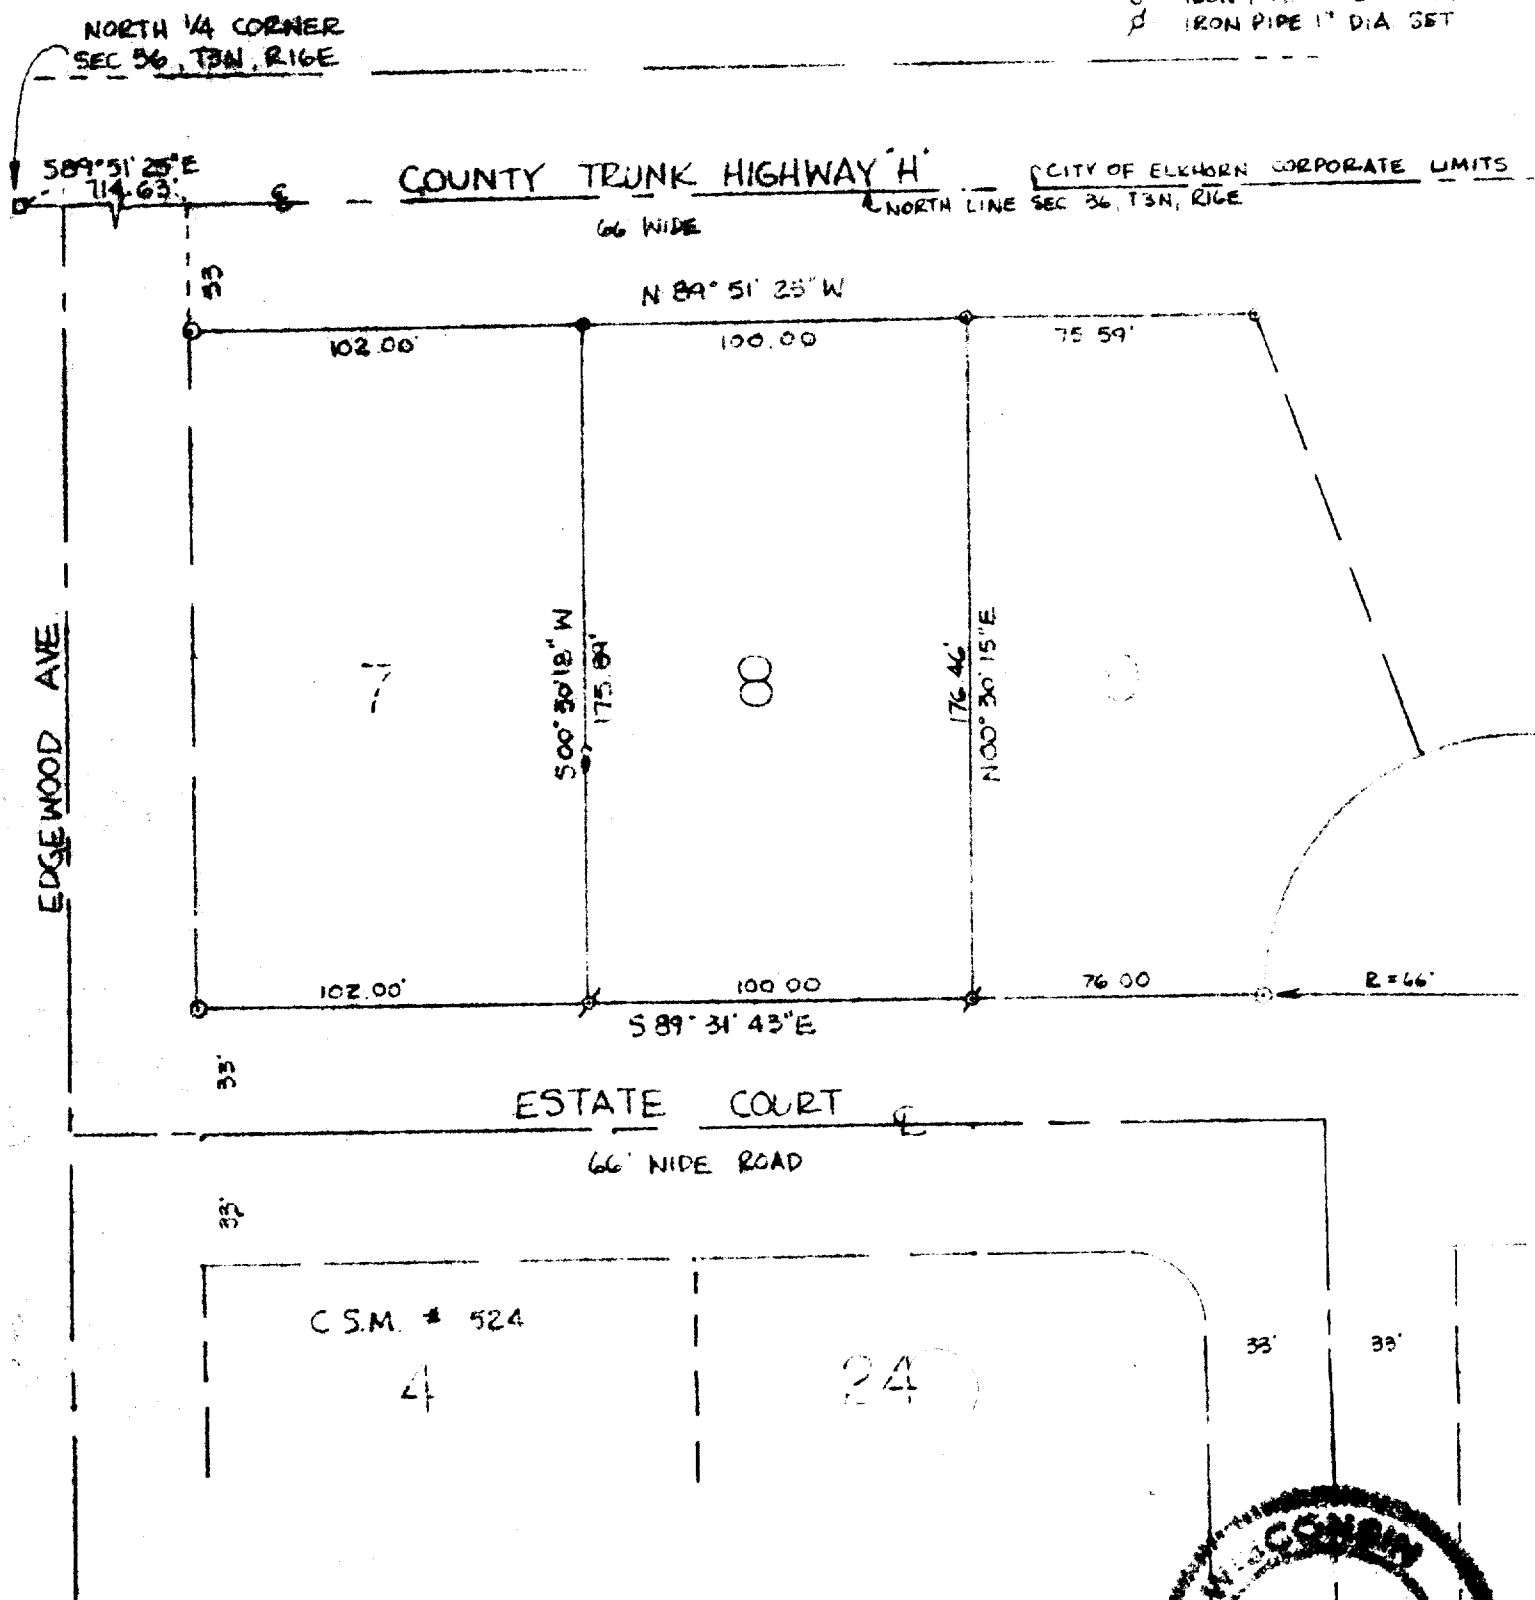

I HEREBY CERTIFY THAT THE ABOVE DESCRIBED PROPERTY HAS BEEN
SURVEYED UNDER MY DIRECTION AND THAT THE PLAT HEREON
DRAWN IS A CORRECT REPRESENTATION OF SAID SURVEY AND
CORRECTLY SHOWS THE EXTERIOR BOUNDARIES AND DIVISIONS
OF SAID PROPERTY



YDW1-2
4-297