

FARRIS, HANSEN & COOPER, INC.

ENGINEERING, SURVEYING AND LAND PLANNING

718 W. WALWORTH ST. - P.O. BOX 487 - ELKHORN, WI 53121


OFFICE: 414/783-2088

REL. ON LOT 13 SETBACK 25'

WORK ORDERED BY SCHAUDER BUILDING & REALTY


Elevations shown are relative to the south bolt, top of flange, hydrant located at the Northwest corner of intersection 4th and Edgewood recorded as 1007.18.

1007.19
RIM
D=9.2'
IE=998.0'

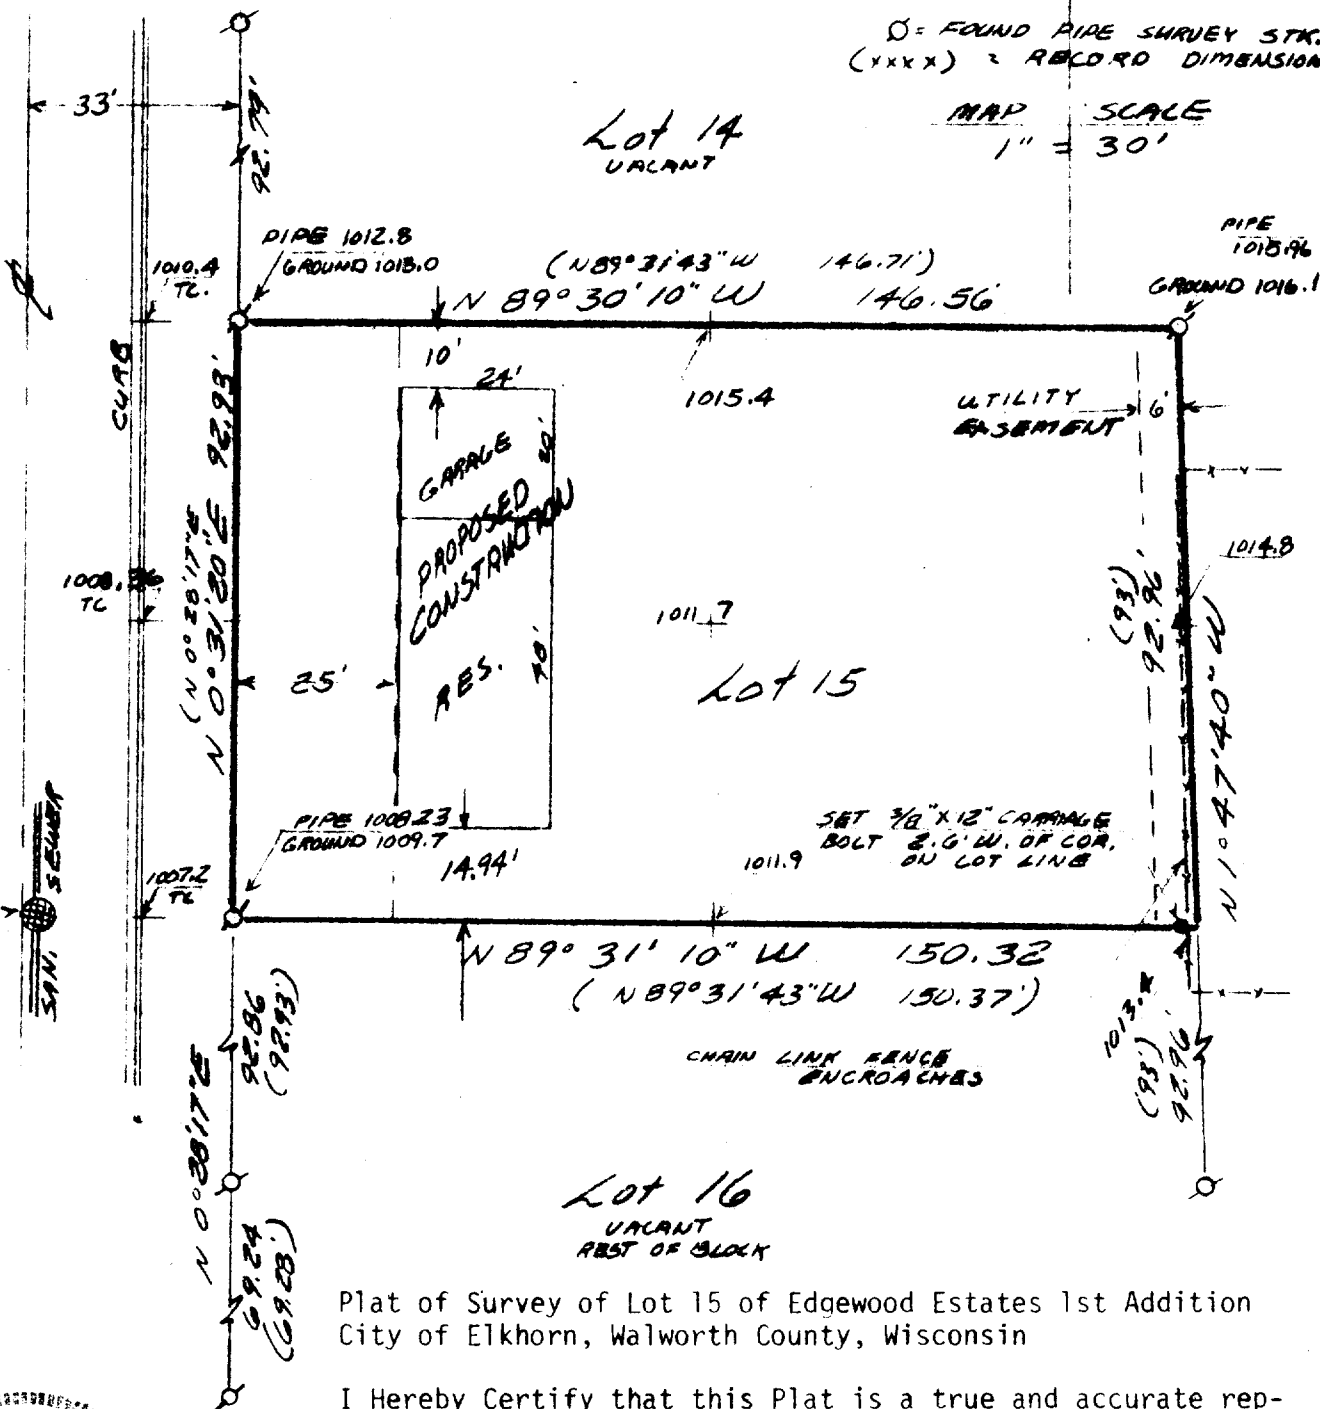

I Hereby Certify that this Plat is a true and accurate representation of the lot lines and of the elevations shown to the best of my professional knowledge and belief.

Robert A. Farris
Robert A. Farris RLS
20 Apr. 1993

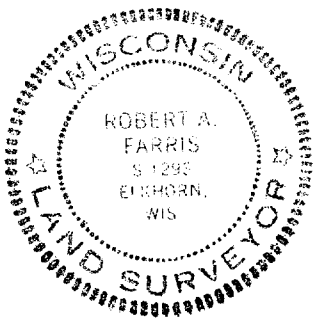

DRAWING NUMBER 2093

DW1-9

4-317-F