
## DUNHAM SURVEYING, S.C. SURVEYING & SUBDIVIDING DELAYAN, WISCONSIN 53115

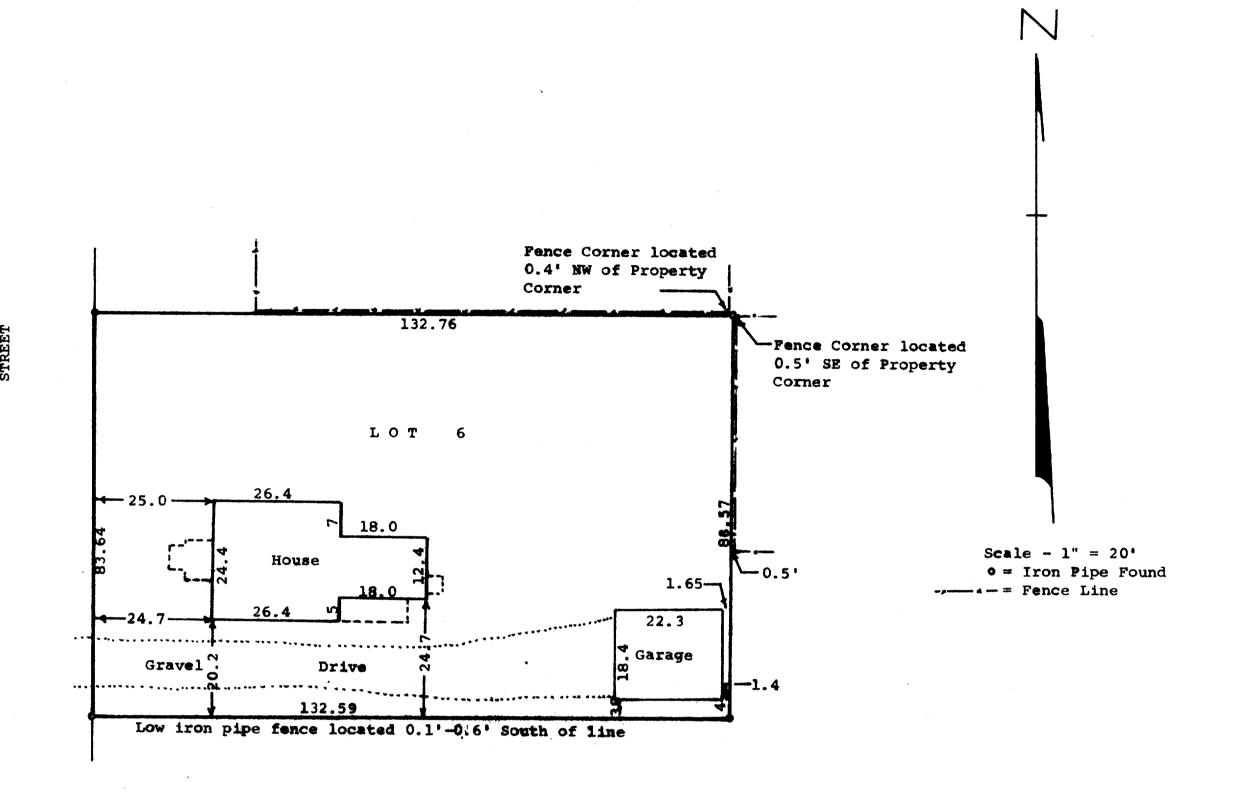

STATE OF WISCONSIN) SS COUNTY OF WALWORTH)

I, George T. Dunham, Surveyor, certify that I have surveyed the property described as follows:

Lot 6 in Block 8 of the Original Plat of the City of Elkhorn, County of Walworth, State of Wisconsin,

and that the above map is a true representation thereof and shows the size and location of the property, its exterior boundaries, the location of all visible structures and dimensions of all principal buildings thereon, boundary feaces, apparent easements, roadways and visible engroachments, if any.

This survey is made for the use of the present owners of the property, and size those who purchase, mortgage, or guarantee the title thereto within one (1) year from date hereof.

July 23, 1981

Serge T. Dunham, Surveyor



K & E 10-9135