

HOME OFFICE
109 SOUTH SPRING STREET
BURLINGTON WISCONSIN 53105
PHONE 414 763-2652
414-763-7834

ROBERS & BOYD, INC.
CONSULTING ENGINEERS
LAND SURVEYORS

BRANCH OFFICE
809 43RD STREET
KENOSHA, WISCONSIN 53140
PHONE 414-658-4488


MORTGAGE INSPECTION SURVEY
FOR
UNIVERSAL MORTGAGE
OF

Part of Lot 2, Block 9 of the original plat of the Village (now City of Elkhorn) described as follows, to-wit: The East 1/2 and the Southwest 1/4 of said Lot 2, also described as beginning at a point 43.94 feet South of the Northwest corner of said Lot 2, thence continue South 43.94 feet to the Southwest corner of said lot; thence East along the South line of said lot 135.04 feet to the Southeast corner of said lot; thence North along the East line of said lot 87.88 feet to the Northeast corner of said lot; thence West along the North line of said lot 67.60 feet to the midpoint in the North line of said lot; thence South 43.94 feet; thence West 67.56 feet to the point of beginning.

The above description taken from deed recorded March 17, 1976 in Volume 154, Page 670.

Said lands being in the City of Elkhorn, County of Walworth and State of Wisconsin.

Owner: Edward Smith
221 N. Broad Street
Elkhorn, WI

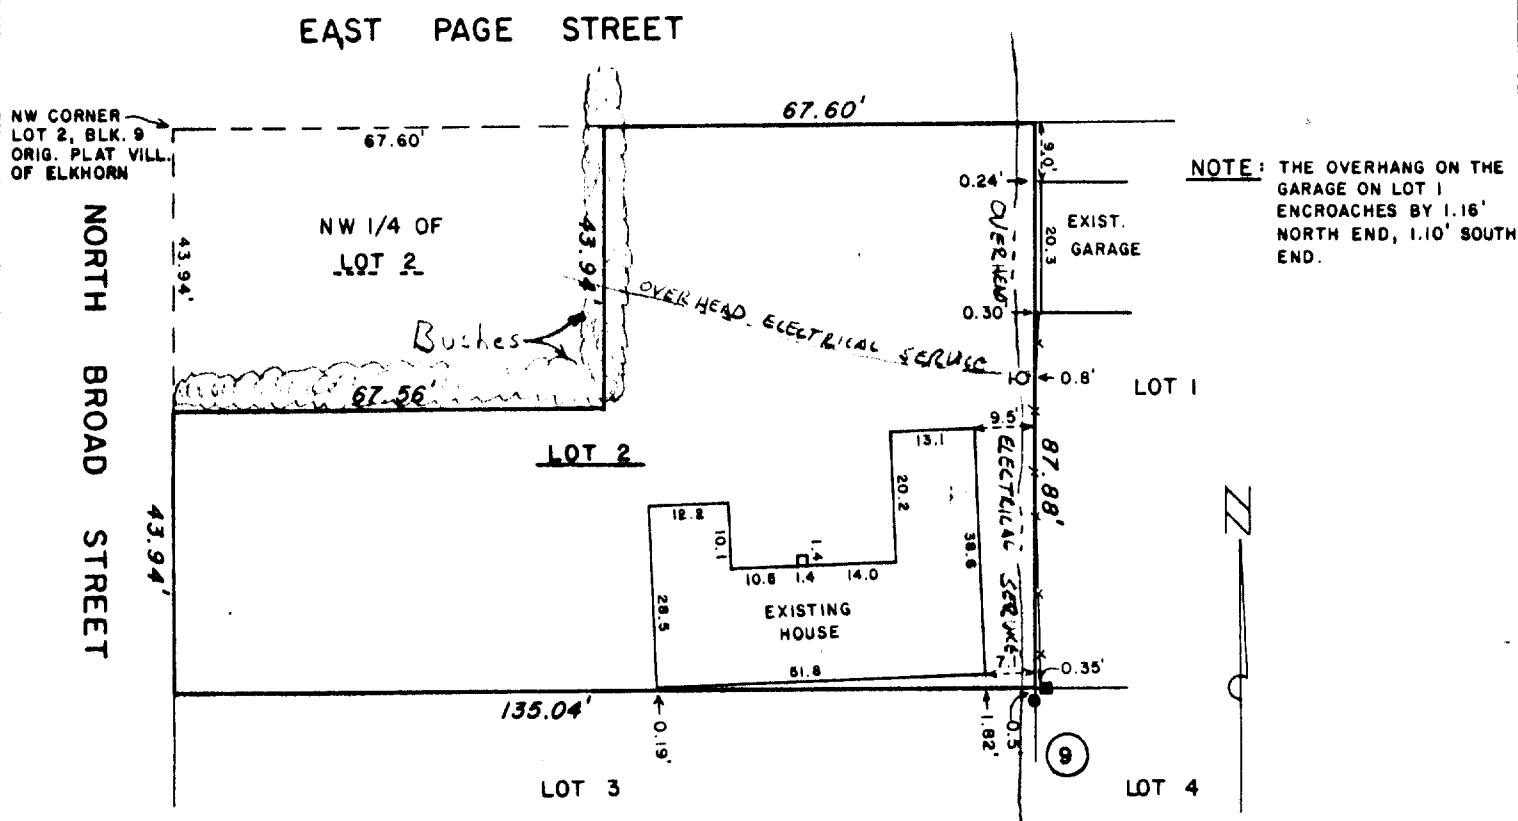

I CERTIFY THAT I HAVE SURVEYED THE ABOVE DESCRIBED PROPERTY AND THAT THE ABOVE PLAT IS AN ACCURATE SURVEY AND A TRUE REPRESENTATION THEREOF AND CORRECTLY SHOWS THE EXTERIOR BOUNDARY LINES AND LOCATION OF BUILDINGS ON SAID PROPERTY AND THE CORRECT MEASUREMENTS THEREOF.

THIS SURVEY IS MADE FOR THE EXCLUSIVE USE OF THE PRESENT OWNERS OF THE PROPERTY ALSO THOSE WHO PURCHASE MORTGAGE OR GUARANTEE THE TITLE THERETO WITHIN ONE YEAR FROM DATE HEREOF AND TO THEM I WARRANT THE ACCURACY OF SAID SURVEY AND MAP.



Kenneth R. Reesman
WISCONSIN REGISTERED LAND SURVEYOR

3-6-80
DATE

80028
JOB NUMBER

POP-39

3-20, pg 76

4-2319