


NOTE: THIS SEC. LINE RECORDED AS S89°51'20"E FOR LAND LOCATED TO THE NORTH  
 N 89° 51' 20" E 442.77'

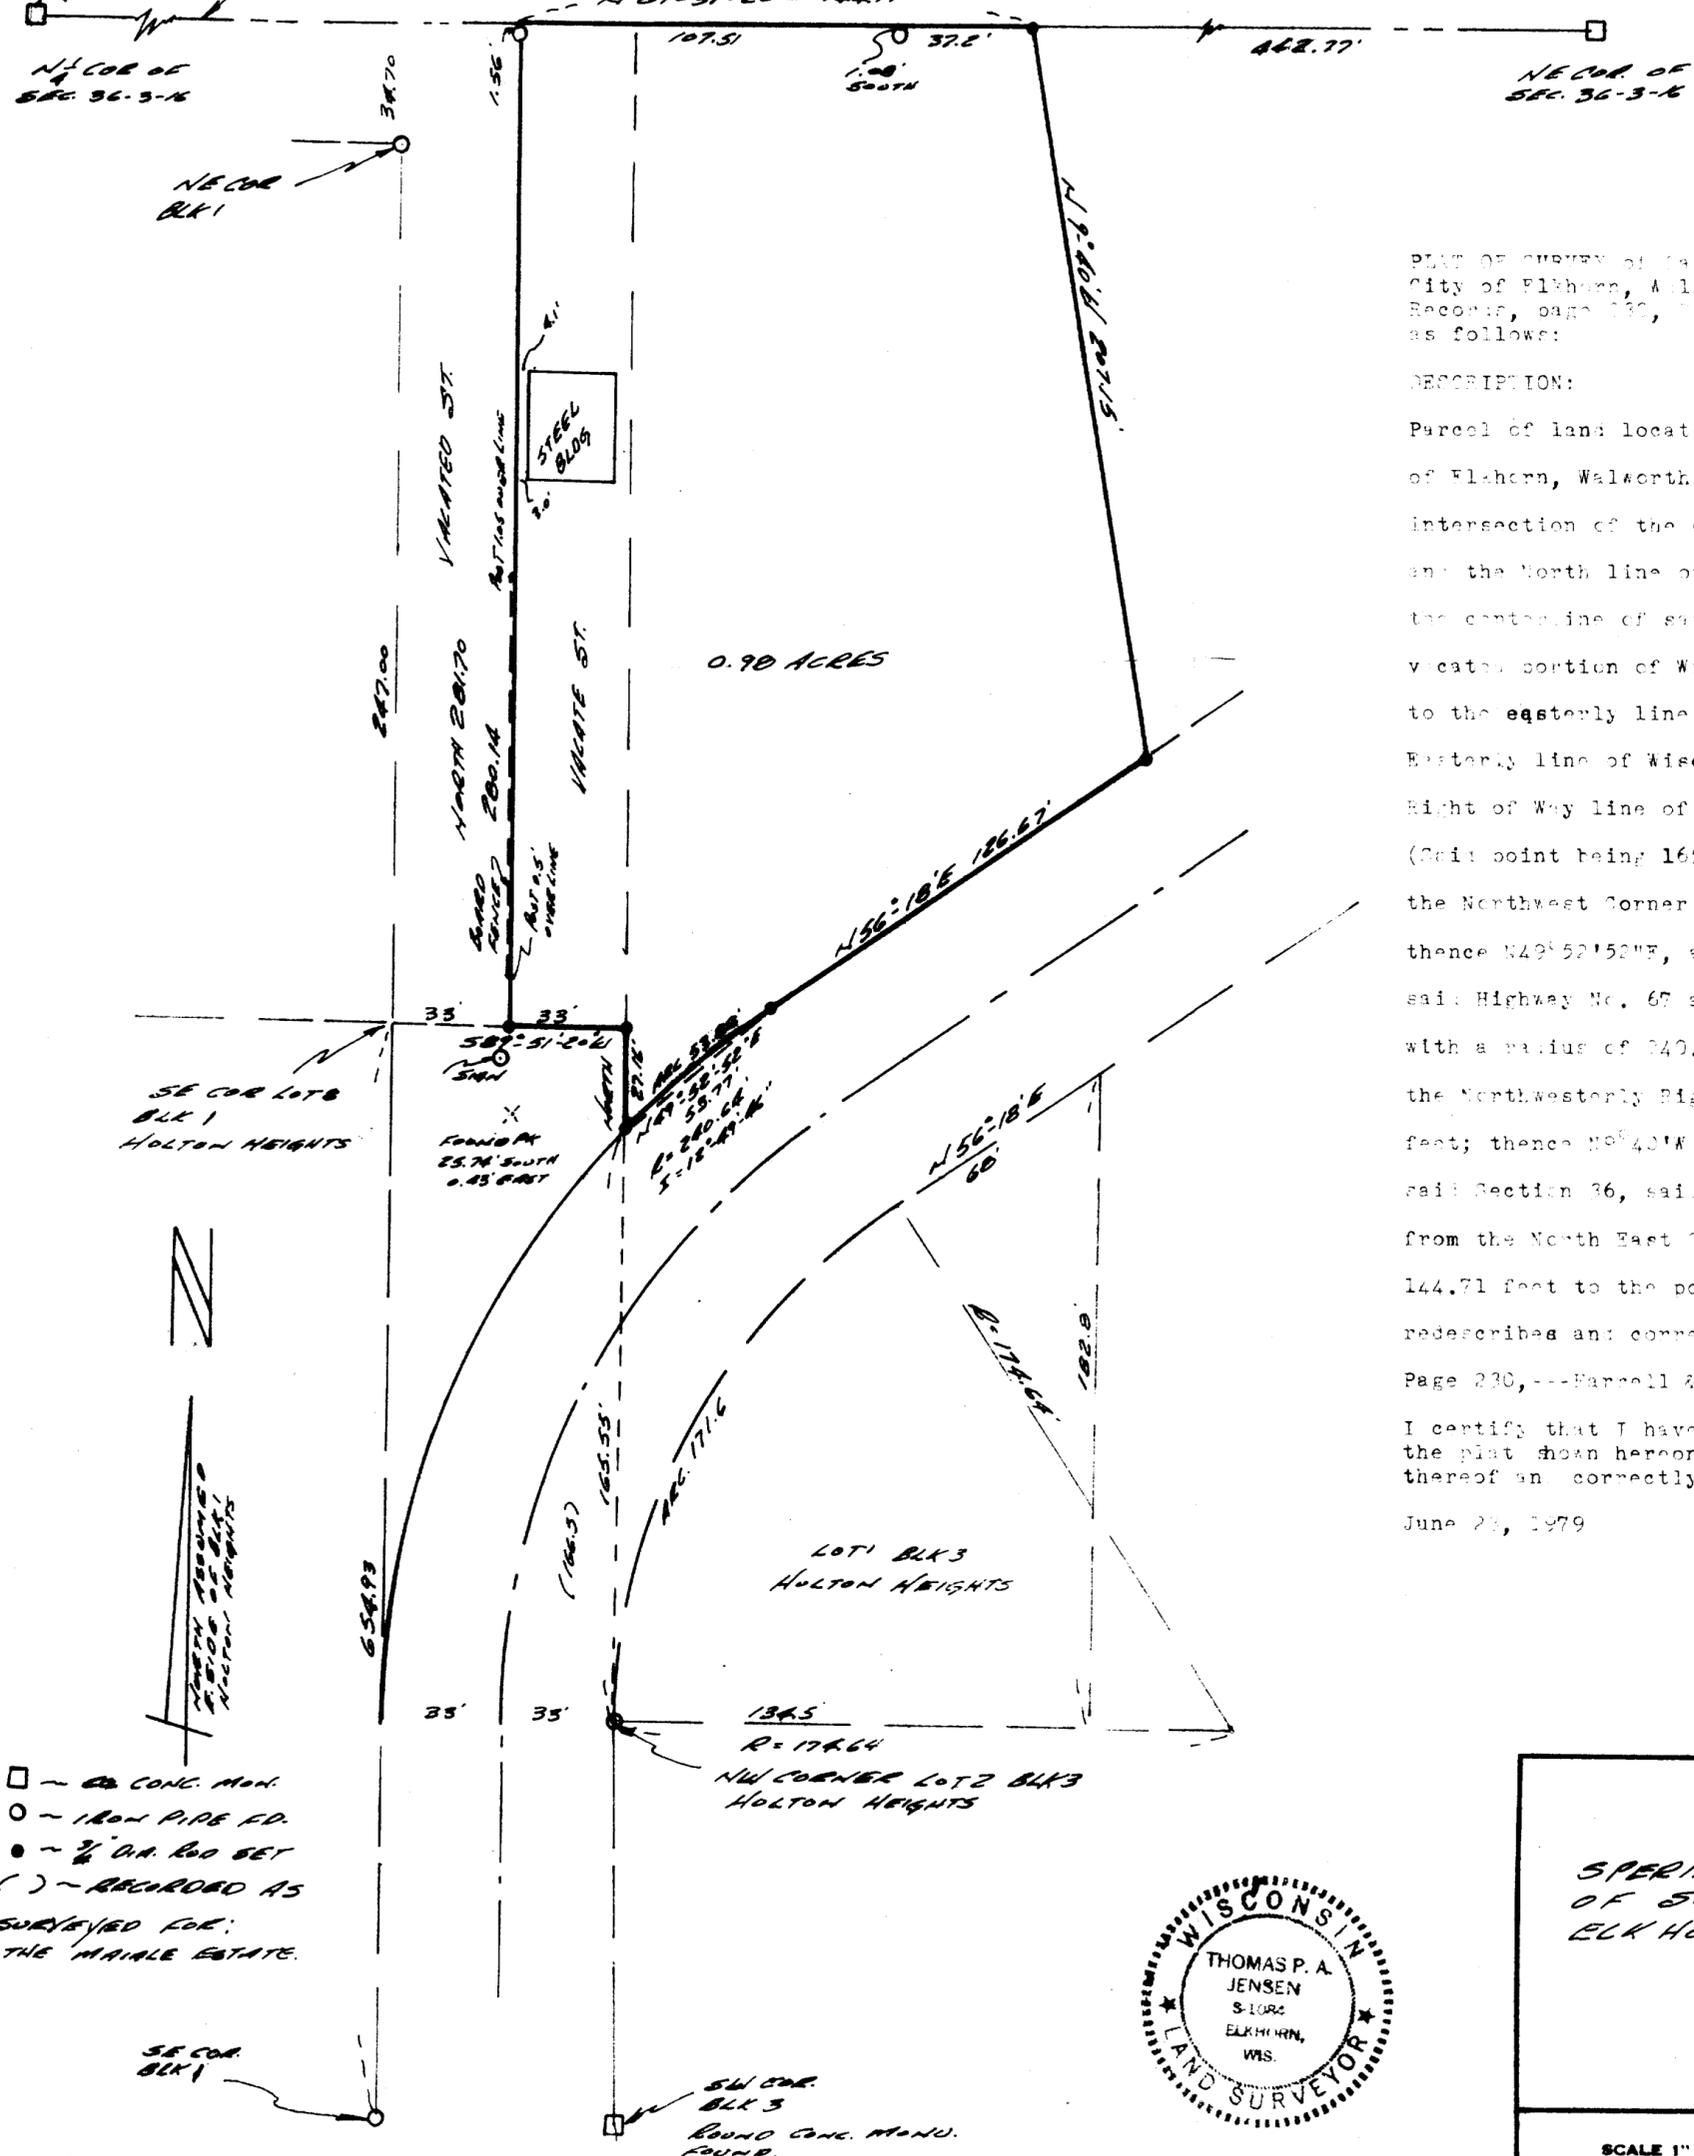

PLAT OF SURVEY of land located in the NE 1/4 of Section 36, T3N R16E, City of Elkhorn, Walworth County, Wisconsin and recorded in Vol. 7 Records, page 230, Rec. #612616 and redescribed more particularly as follows:

DESCRIPTION:  
 Parcel of land located in the NE 1/4 of Section 36, T3N R16E, City of Elkhorn, Walworth County, Wisconsin; begin at a point of intersection of the centerline of North Wisconsin St. (now vacated) and the North line of Section 36, T3N R16E; thence South, along the centerline of said Street, 281.70 feet to the end of the vacated portion of Wisconsin Street, thence N89°51'20"E 33.00 feet to the easterly line of Wisconsin Street; thence South, along the Easterly line of Wisconsin Street, 27.16 feet to the Northwesterly Right of Way line of St. Highway No. 67 (formerly U.S. Hwy 412) (said point being 165.55 feet, recorded as 166.5 feet, North of the Northwest Corner of Lot 2 Block 3 of Holton Heights Add.) thence N49°52'52"E, along the Northwesterly Right of Way line of said Highway No. 67 and along the chord of a curve to the right, with a radius of 240.64 feet, 53.77 feet; thence N56°18'E, along the Northwesterly Right of Way line of said highway No. 67, 126.67 feet; thence N89°40'W 207.15 feet to a point on the North line of said Section 36, said point being located S89°51'20"W 442.77 feet from the North East Corner of said Section 36; thence S89°51'20"W 144.71 feet to the point of beginning; the above description redescribes and corrects the description recorded in Vol. 7 Records Page 230, ---Farrell & Farrell to Maiale & Maiale.

I certify that I have surveyed the above described land and that the plat shown hereon is an accurate survey and a true representation thereof and correctly shows the boundary line of said property.

June 23, 1979

*Thomas P.A. Jensen*  
 Thomas P.A. Jensen C-1084  
 JENSEN SURVEYING & MAPPING  
 ELKHORN, WISCONSIN



**PLAT OF SURVEY**  
 OF  
 SPERINOS LOCATED IN THE NE 1/4  
 OF SEC. 36, T3N R16E, CITY OF  
 ELKHORN, WAL. CO. WIS.

*Thomas P.A. Jensen*  
 SURVEYOR

SCALE 1" = 40'  
 DATE June 23, 1979

- ~ CONG. MARK
- ~ IRON PIPE PD.
- ~ 3/4" DIA. ROD SET
- ( ) ~ RECORDED AS SURVEYED FOR: THE MAIALE ESTATE.