



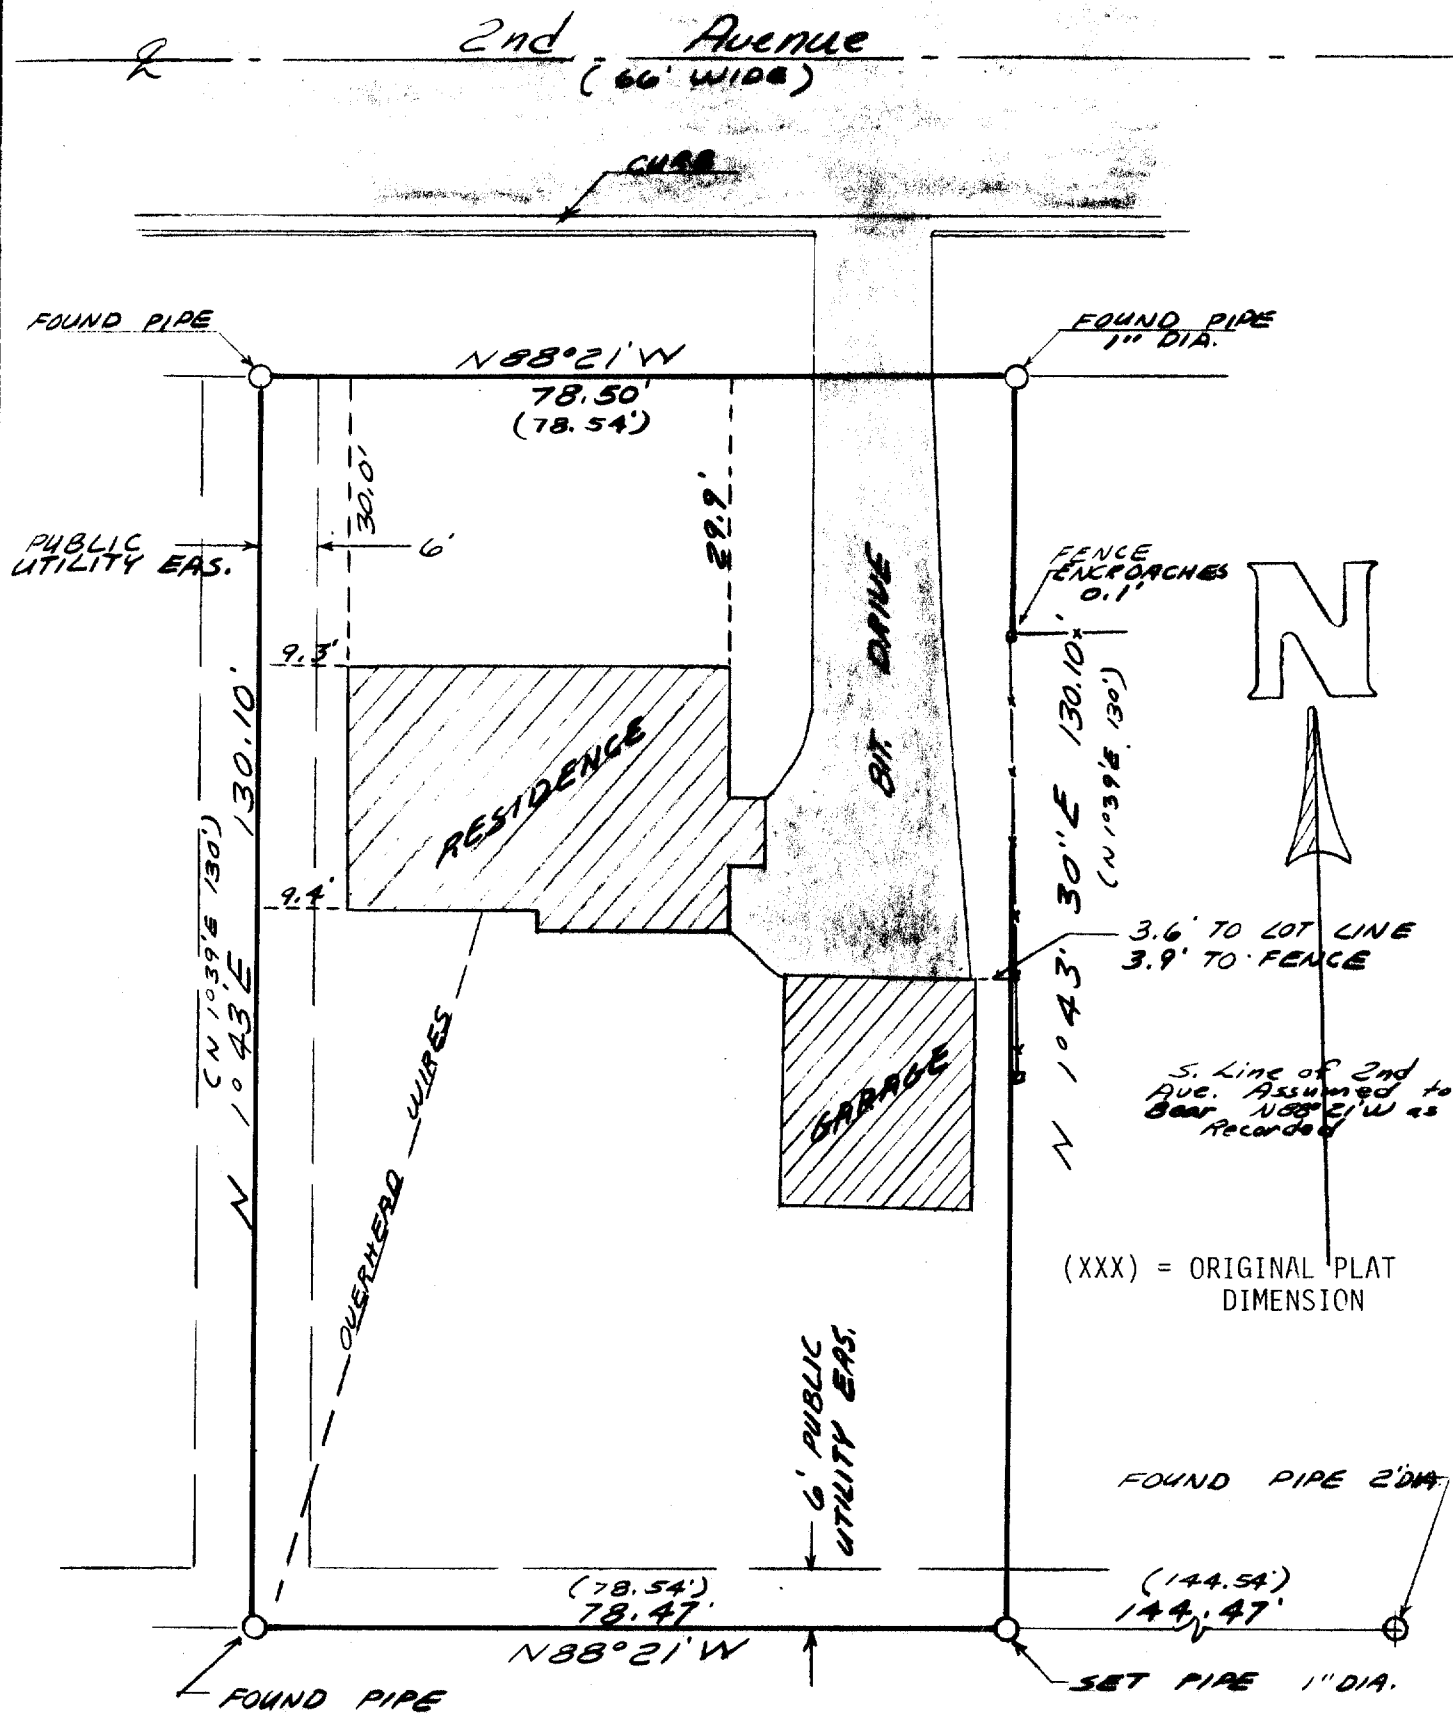

PLAT OF SURVEY OF LOT 2 OF BLOCK 3 OF EDGEWOOD SUBDIVISION IN THE CITY OF ELKHORN, WALWORTH COUNTY, WISCONSIN

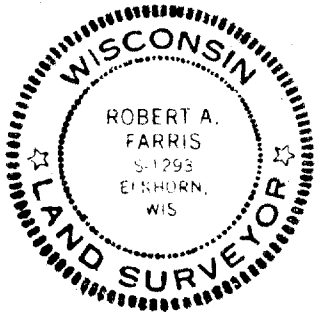

I hereby certify that the property shown hereon has been surveyed under my direction and that this plat is a true and accurate representation of the lot lines, building location, and any encroachments to the best of my professional knowledge and belief.

Dated this 17th day of August, 1983

Robert A. Farris
Robert A. Farris, RLS

Work Ordered by: Jim Hay

Farris, Hansen & Associates, Inc.
P.O. Box 487, 715 W. Walworth St.
Elkhorn, Wis. 53121

Project No.

2146

4-338-FV

YE-8