


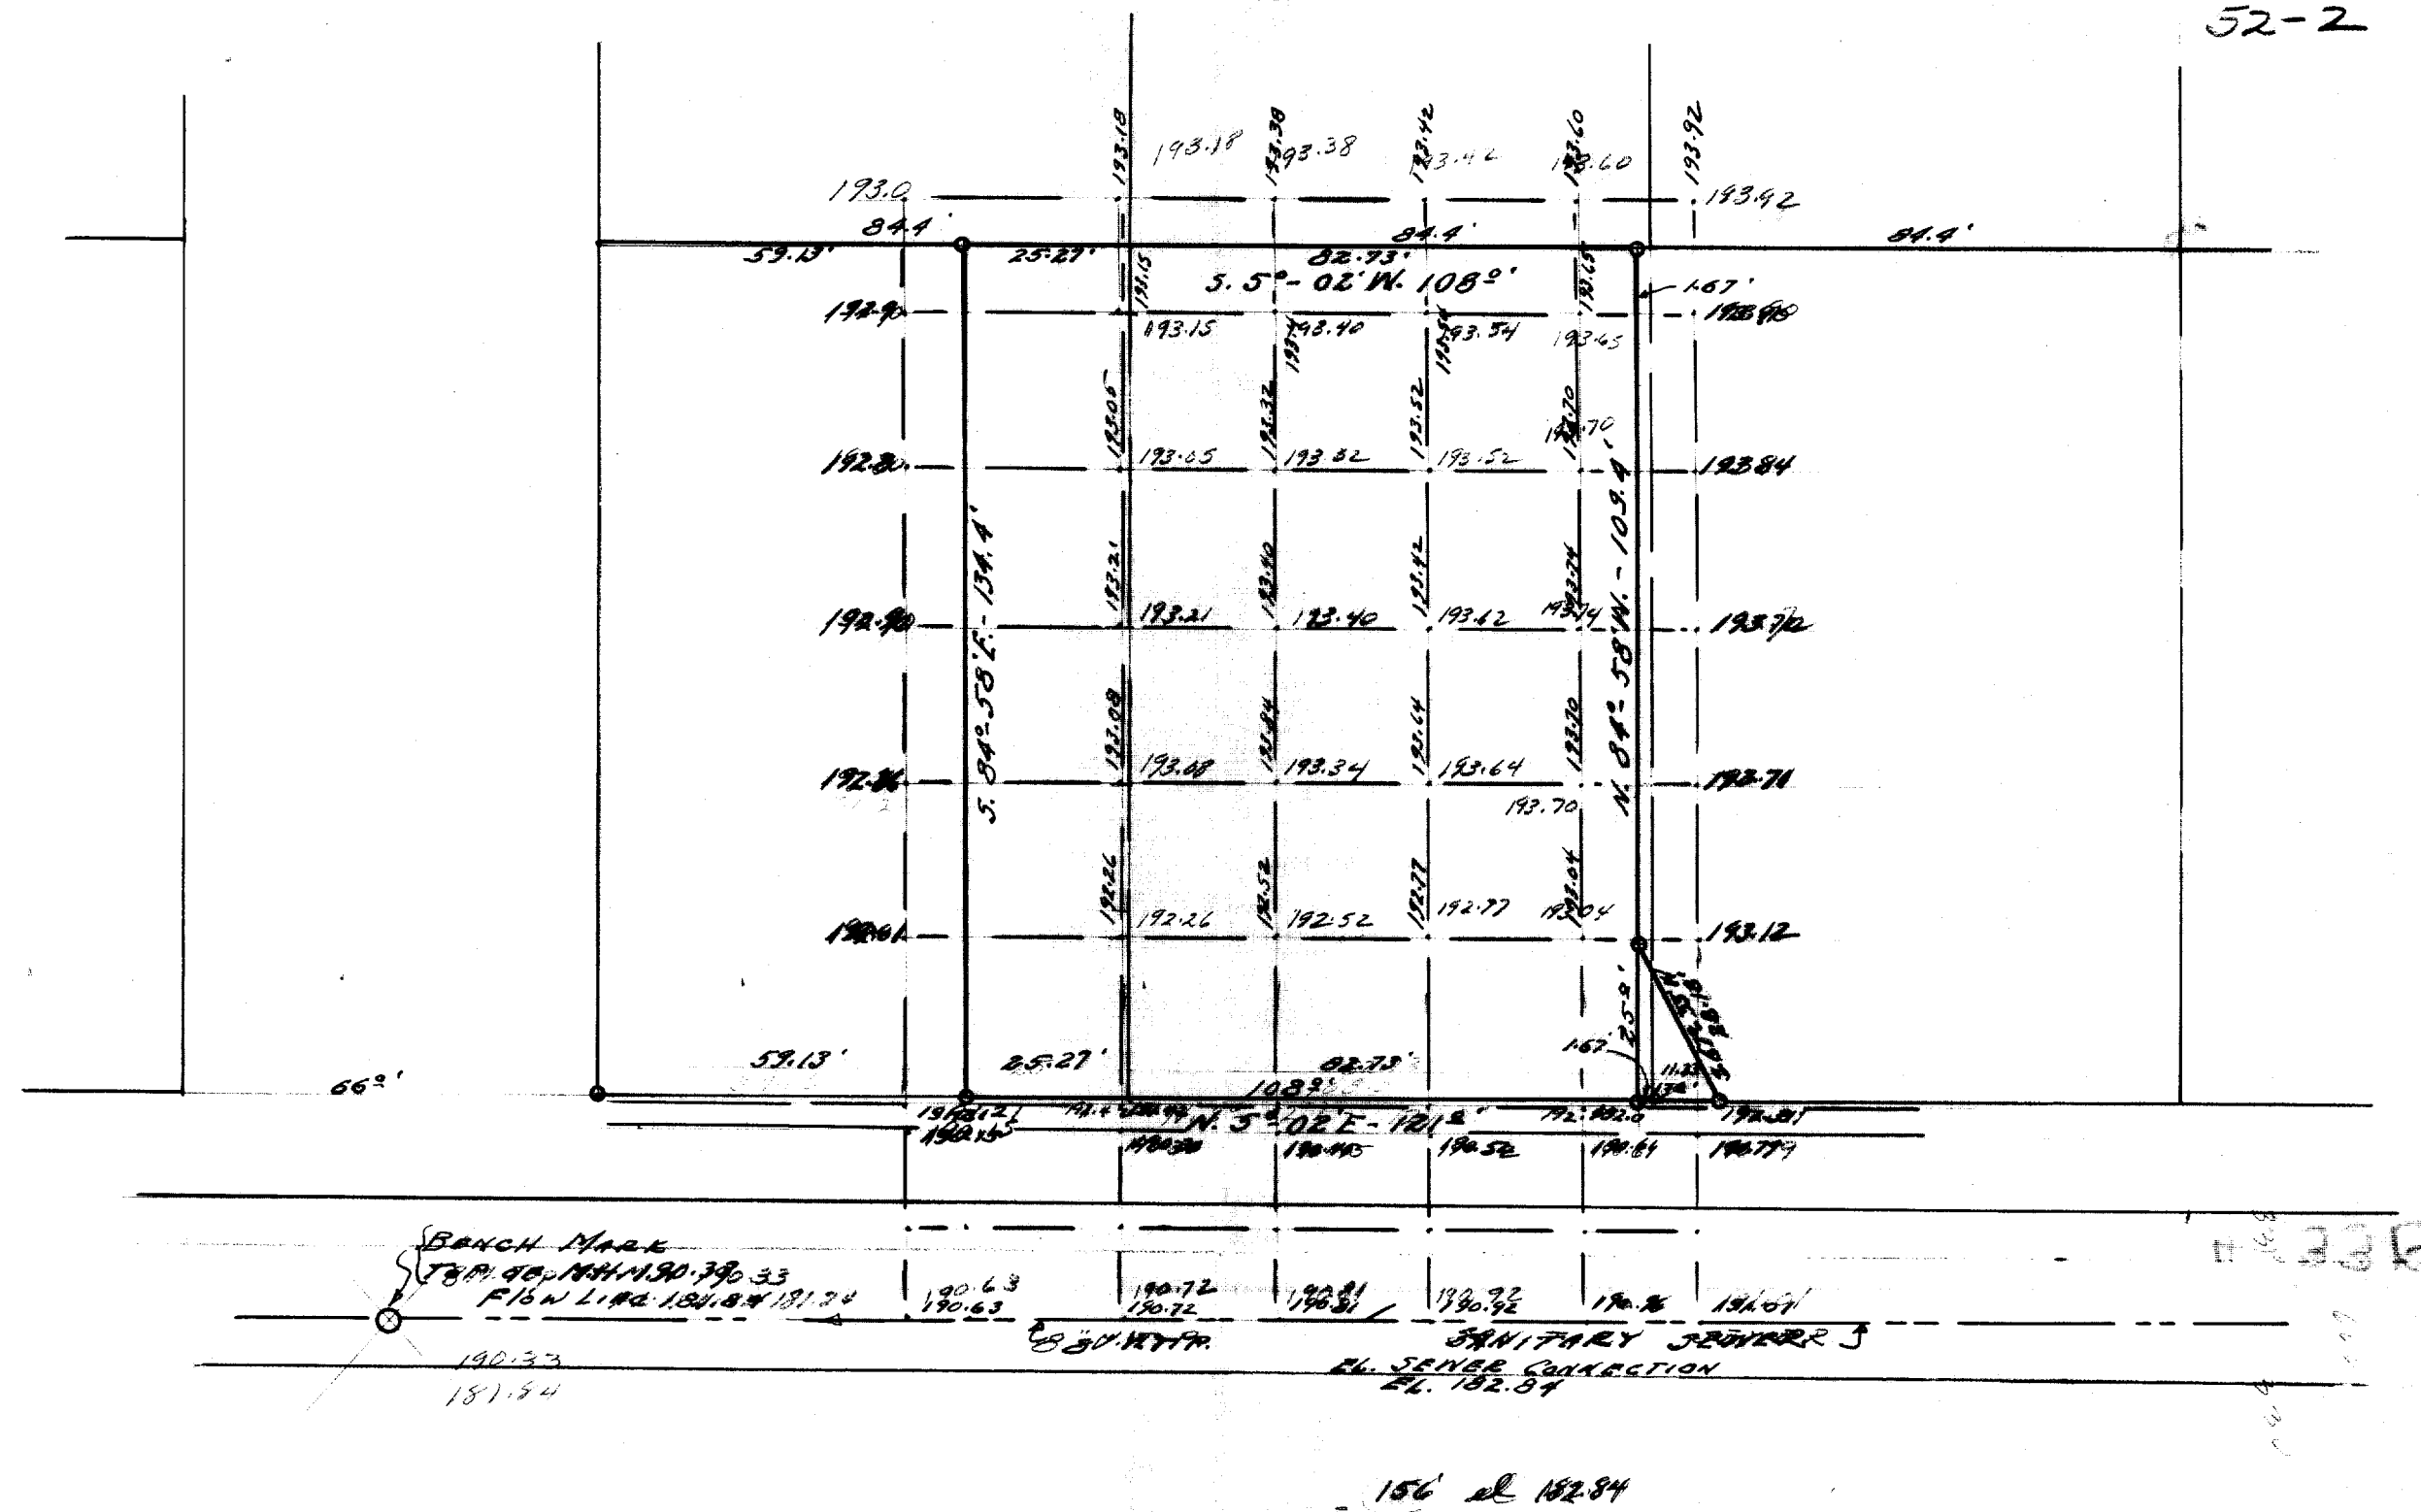

Lot 3 Blk 41 River area

Epstein

Y* MISC
YA-938-2

4-34B