
PLAT OF SURVEY

Lot 8, Block 10 of the Original Plat to the City of Elkhorn, Walworth County, Wisconsin

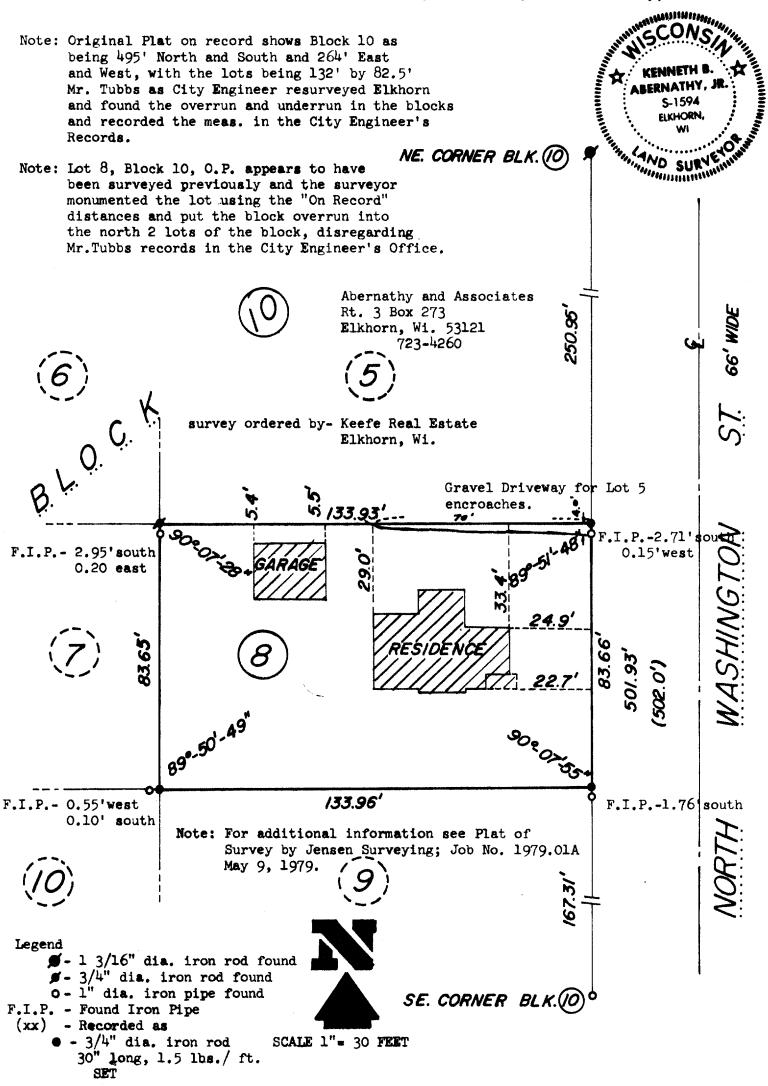

I, Kenneth B. Abernathy Jr., do hereby certify that I have surveyed the above described property and that the plat shown hereon is an accurate survey, a true representation thereof, correctly shows the exterior boundaries of said property and all the buildings thereon.

Dated: December 5, 1984

enneth B. Abernath Jr. 4-366