



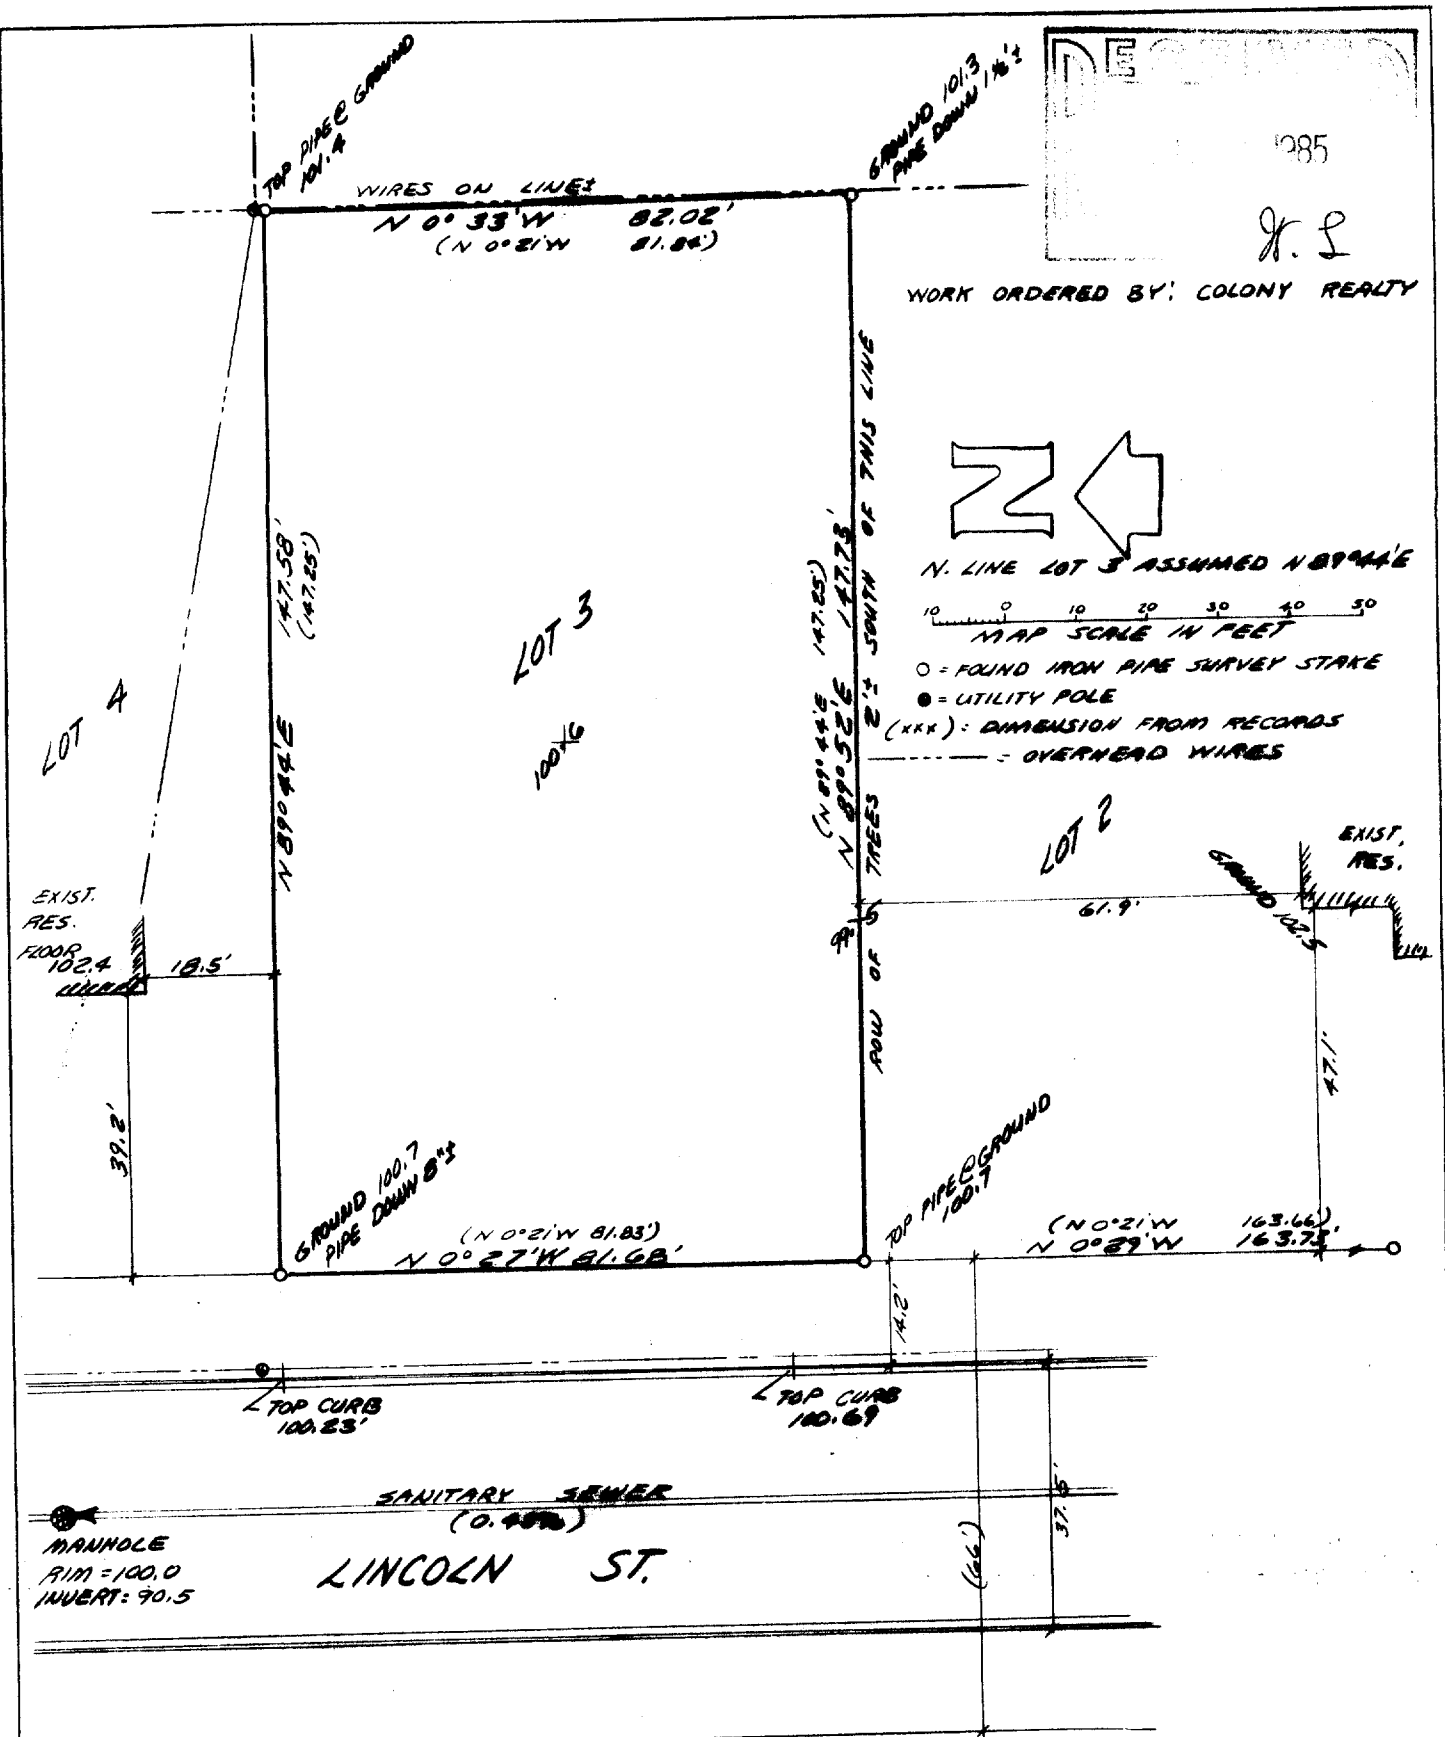

PLAT OF SURVEY OF LOT 3, BLOCK 1 OF TREETOWN'S SUBDIVISION
LOCATED IN NW 1/4 OF SEC. 31, T.3N., R. 17E. CITY OF ELKHORN,
WALWORTH COUNTY, WISCONSIN

I hereby certify that I have surveyed the above
described property and that the above map is a true
representation thereof and shows the size and
location of the property, its exterior boundaries,
the location of all visible structures and
dimensions of all principal buildings thereon,
boundary fences, apparent easements, roadways and
visible encroachments, if any.
This survey is made for the use of the present
owners of the property, and also those who purchase,
mortgage, or guarantee the title thereto within one
(1) year from the date hereof.

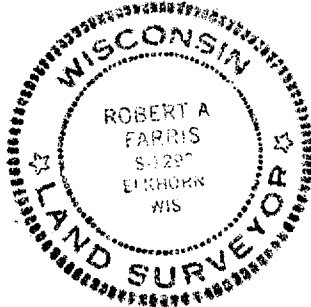

ERRIS, HUGHES & ASSOCIATES, INC.
1 Midway Court - P.O. Box 487
Elkhorn, Wisconsin
414-722-2000

DATED 7/8/85

PROJ. # 2432

4-368-F