


Wisconsin Registered Land Surveyor S-1594

Rt. 3, Box 273
Elkhorn, Wisconsin 53121
Phone: (414) 723-4260 (office)
(414) 723-4813 (residence)

LEGAL DESCRIPTION:

The West 66 feet of Lot 4, Block 3 of the Original Plat of the City of Elkhorn and the East 47 feet of Lot 3, Block 3 of the Original Plat of the City of Elkhorn, Walworth County, Wisconsin.

SURVEYED FOR: Kurt Peters
6 E. Park St.
Elkhorn, WI. 53121

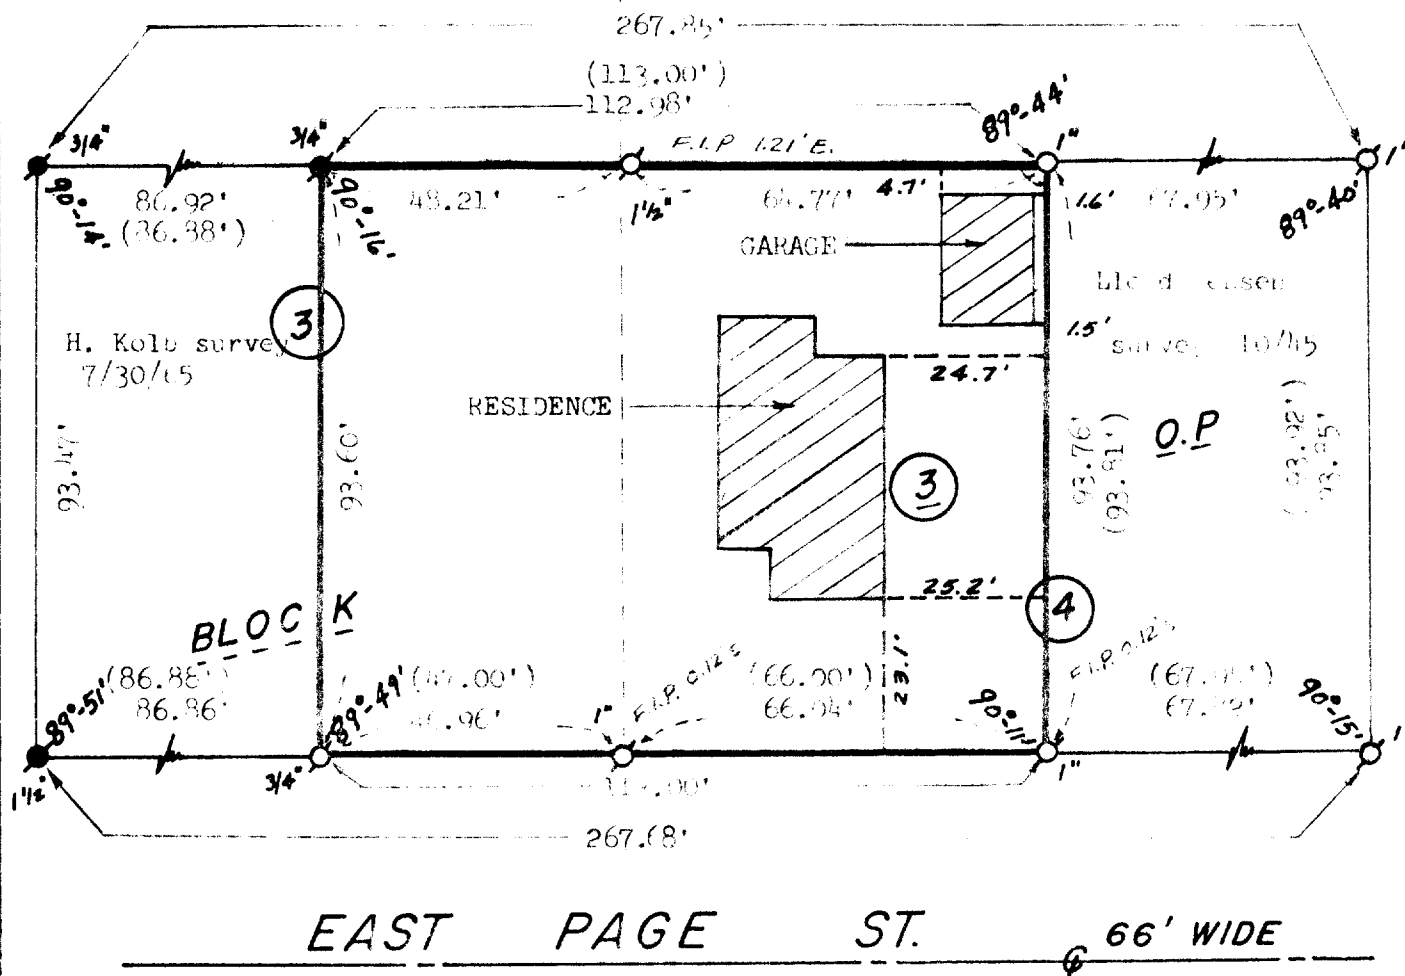

Note: Found 1" dia. iron pipe at Northeast corner of Property and set and set a 1" dia. iron pipe 24" long using record distance and line.

Legend

-  FOUND IRON PIPE
 FOUND IRON ROD
 FOUND BRASS CAPPED MONUMENT
 FOUND CONCRETE MONUMENT
 CHISEL CUT IN CONCRETE
 SET IRON ROD, 24" LONG, WEIGHING
1.5 LBS./LINEAL FT., 3/4" DIA.
 SET IRON ROD, 30" LONG, WEIGHING
4.5 LBS./LINEAL FT., 1-11/16" DIA.
 (xx) RECORDED AS DIMENSION
 —x—x— EXISTING FENCE


SCALE: 1" = 30 FEET

"I hereby certify that I have surveyed the above described property and that the above map is a true representation thereof and shows the size and location of the property, its exterior boundaries, the location of all visible structures ~~and dimensions of the parcels and their boundaries~~, boundary fences, apparent easements, roadways and visible encroachments, if any."

"This survey is made for the use of the present owners of the property, and also those who purchase, mortgage, or guarantee the title thereto within one year from date hereof."

Kenneth B. Abernathy
KENNETH B. ABERNATHY, JR.
WISCONSIN REGISTERED LAND SURVEYOR,
S-1594

Date: MAY 16, 1985 Job No. 1985 501

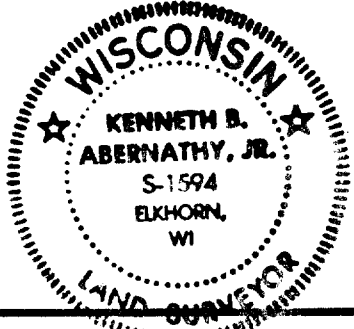

4,0 P-5

4-375^v