


BENCH MARK
MH
RIM
1007.19
E=998.0

FARRIS, HANSEN & ASSOCIATES, INC.
7 Ridgeway Ct.
Elkhorn, WI 53121

RECEIVED
AUG 25 1986
DJP

LOT 16

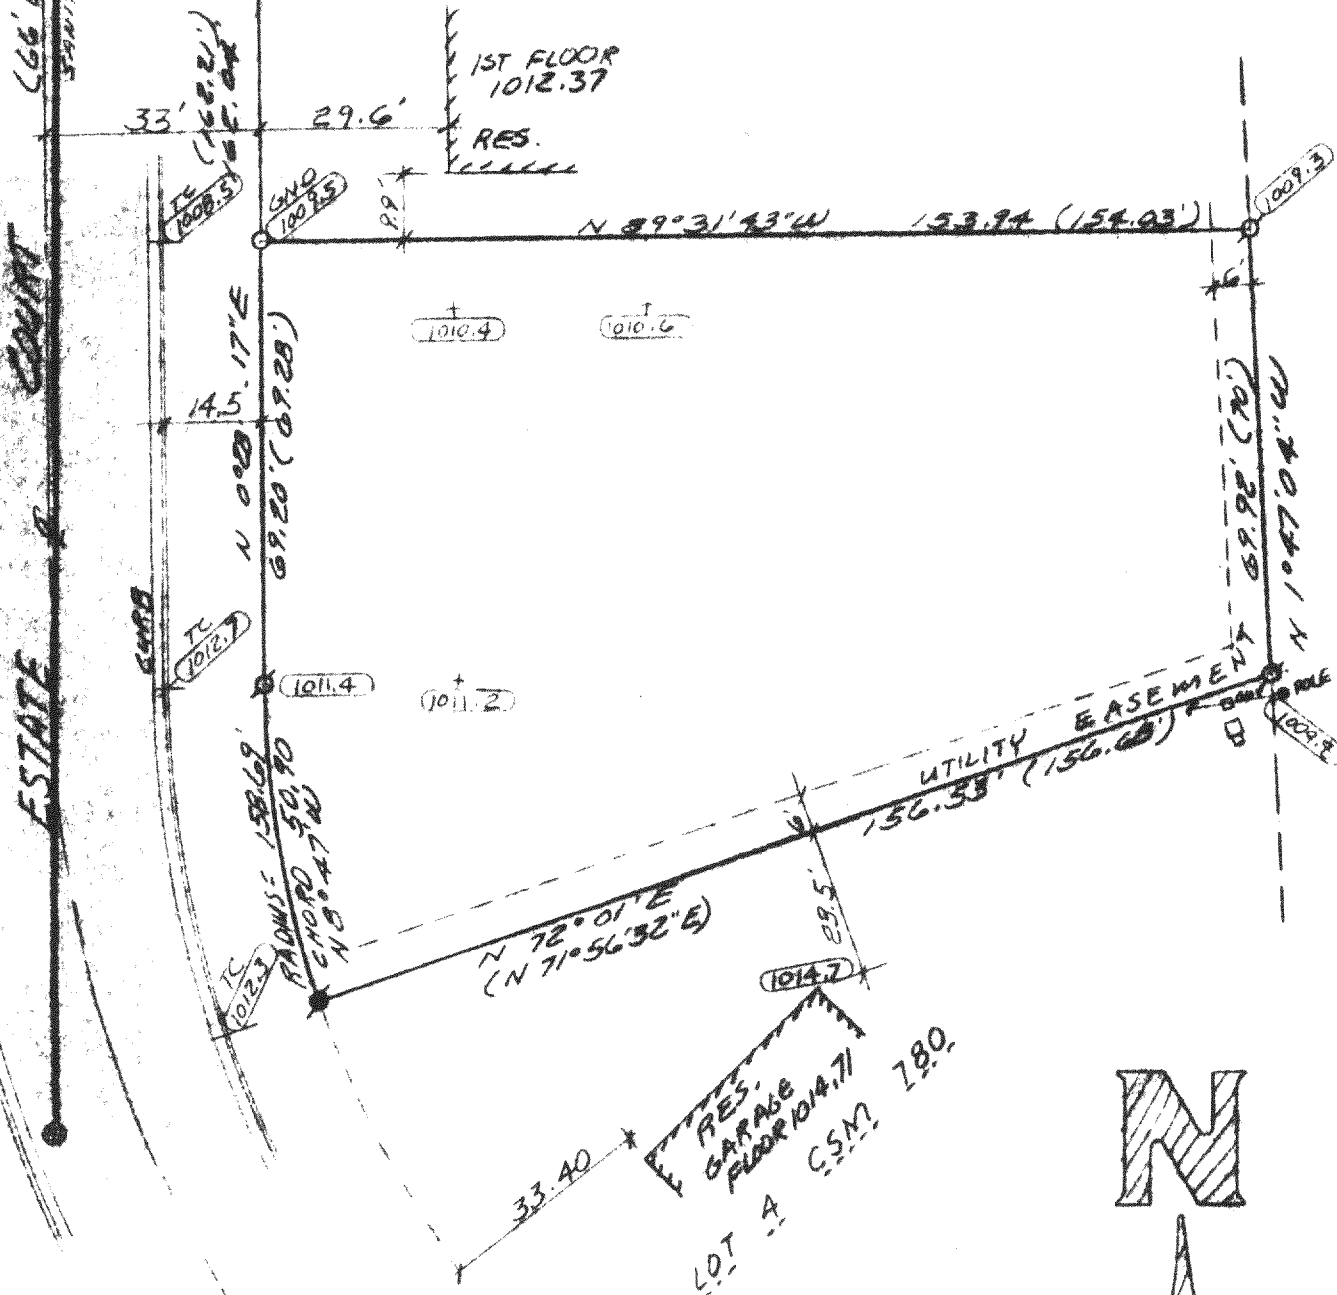


PLAT OF SURVEY LOT 17 OF EDGEWOOD
ESTATES 1ST ADDITION, CITY OF ELKHORN,
WALWORTH COUNTY, WISCONSIN
FOR

ERSKINE CONSTRUCTION
D=IRON PIPE FOUND O=PIPE SET
P=IRON BAR FOUND

I hereby certify that I have surveyed the above
described property and that the above map is a true
and correct representation thereof and show the size and
location of the property, its exterior boundaries,
the location of all visible structures and
dimensions of all principal buildings thereon,
boundary lines, easements, roadways and
other encumbrances, if any.
This survey is made for the use of the present
owners of the property, and also those who purchase,
lease, or otherwise acquire the title thereto within one
year from the date hereof.

Robert A. Farris
08/21/86

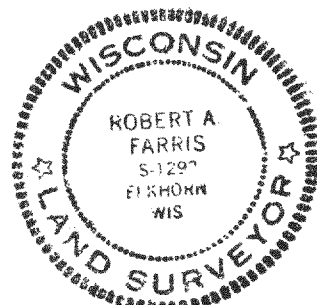

PROJECT NO. 2643

YDWM-11