


I, DANIEL D. COOPER, REGISTERED SURVEYOR, DO HEREBY CERTIFY THAT I HAVE SURVEYED THE PROPERTY DESCRIBED HEREON AND THAT THE MAP SHOWN HEREON IS A TRUE AND ACCURATE REPRESENTATION THEROF TO THE BEST OF MY PROFESSIONAL KNOWLEDGE AND BELIEF.

DATED THIS 23 DAY OF Oct. 1985 *Daniel D. Cooper*
DANIEL D. COOPER, RLS NO. S-1464

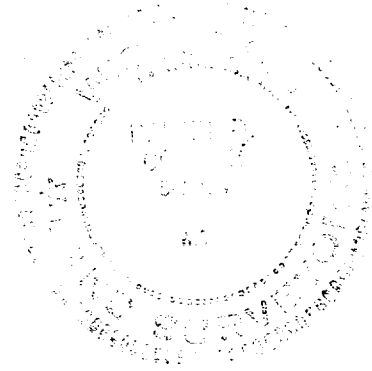


D.D. COOPER & CO. INC.

ROUTE 4, BOX 501 B
ELKHORN, WI 53121

PH 414-723-6265


SURVEYING • MODULAR HOMES

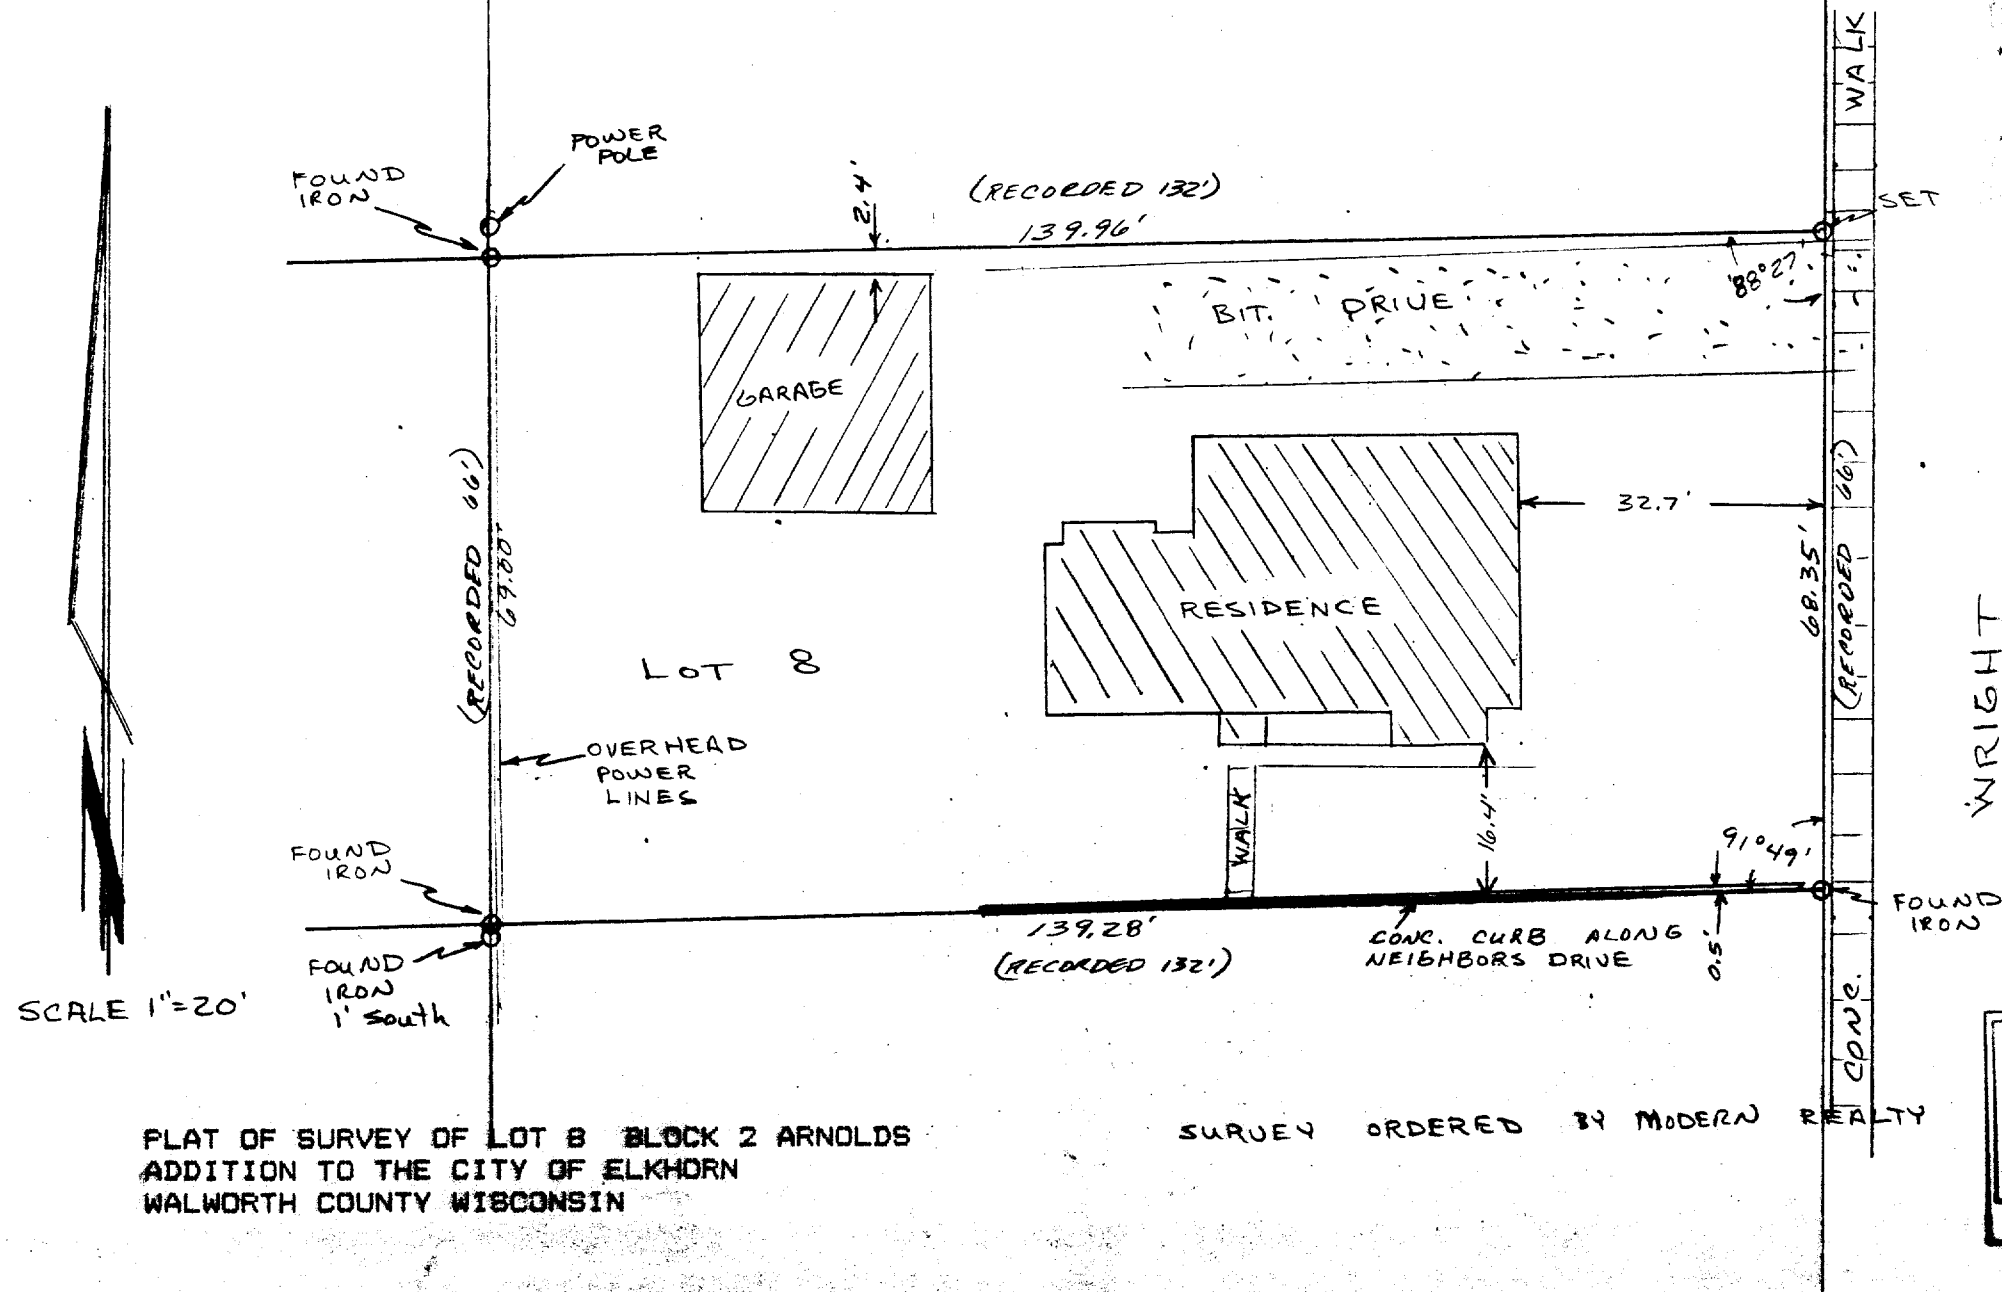

SCALE 1"=20'

PLAT OF SURVEY OF LOT 8 BLOCK 2 ARNOLDS
ADDITION TO THE CITY OF ELKHORN
WALWORTH COUNTY WISCONSIN

SURVEY ORDERED BY MODERN REALTY

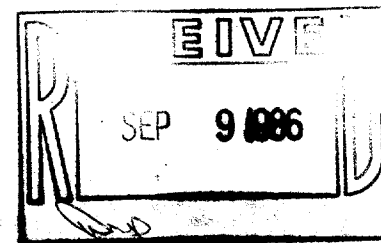

347

