
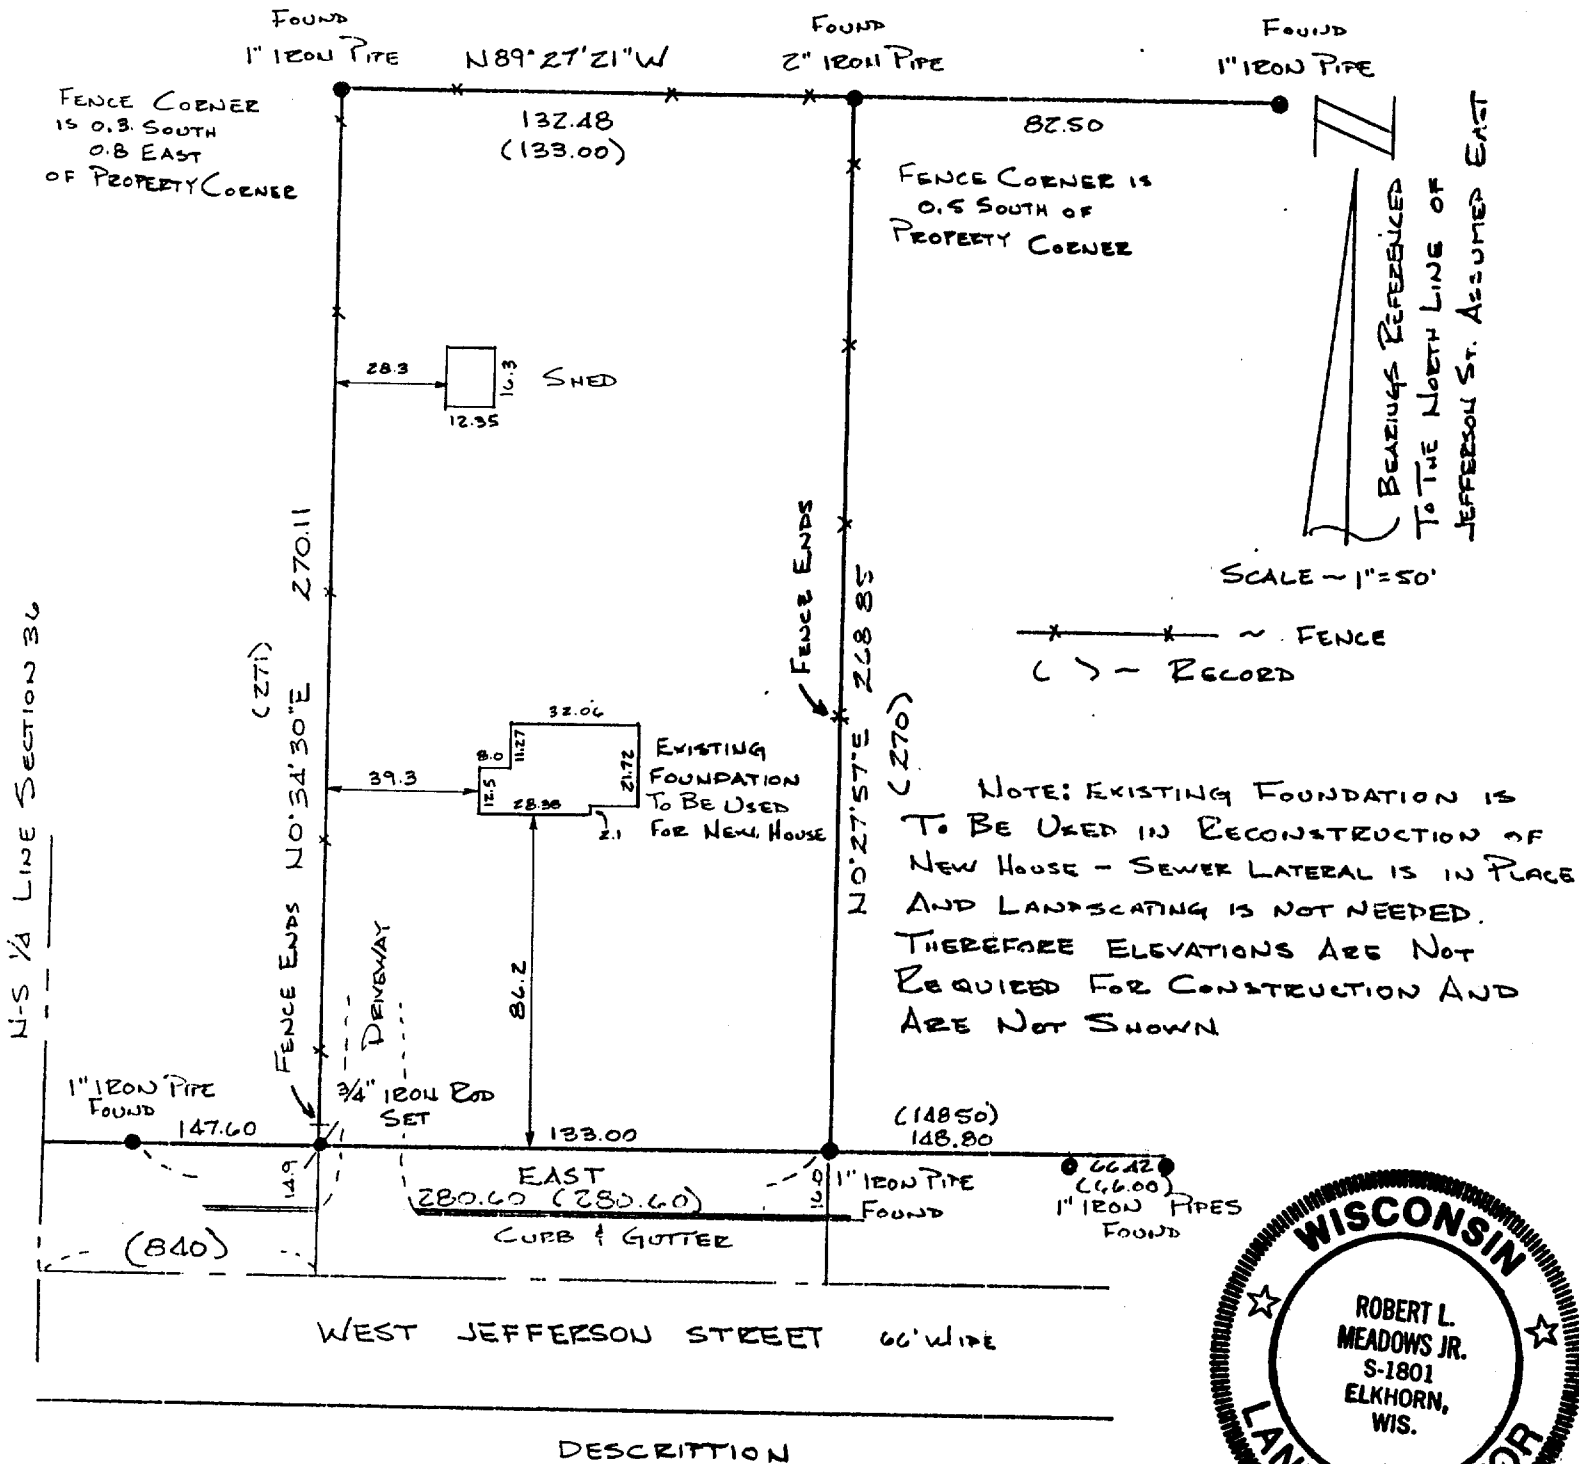


PLAT OF SURVEY

OF A PARCEL OF LAND LOCATED IN THE N.W. 1/4 OF THE S.E. 1/4 OF SECTION 36, T4N, R16E, CITY OF ELKHORN, WALWORTH COUNTY, WISCONSIN

SURVEYED BY: JENSEN SURVEYING & MAPPING S.C.
P.O. Box 322-ELKHORN, WI - 53121

SURVEYED FOR: RICHARD & GAIL TULLY
220 W. JEFFERSON ST. - ELKHORN, WI - 53121

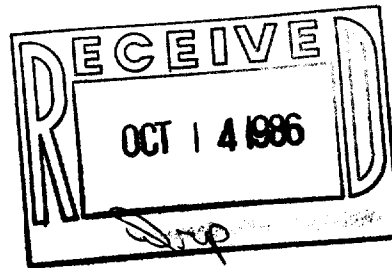

A parcel of land in the Northwest 1/4 of the Southeast 1/4 of Section 36, Town 3 North, Range 16 East, City of Elkhorn, County of Walworth, State of Wisconsin and described as follows: Beginning at a point in the centerline of Jefferson Street, that is 840 feet East of the North and South 1/4 line of said Section 36; thence North 33 feet to an iron stake set in the North line of Jefferson Street; thence North 271 feet to an iron stake set in the South line of Fairview Addition to the City of Elkhorn; thence East in said South line 133 feet to an iron stake; thence South 270.04 feet to a stake in the North line of Jefferson Street; thence South 33 feet to the centerline of said Street, thence West in said centerline 133 feet to the place of beginning.

I, ROBERT L. MEADOWS JR., WISCONSIN REGISTERED LAND SURVEYOR, DO HEREBY CERTIFY THAT THIS SURVEY WAS PERFORMED BY ME IN FULL COMPLIANCE WITH THE OWNER'S / AGENTS INSTRUCTIONS AND CHAPTER A-ES OF THE WISCONSIN ADMINISTRATIVE CODE "MINIMUM STANDARDS FOR PROPERTY SURVEYS"; AND THAT THIS MAP IS AN ACCURATE REPRESENTATION THEREOF TO THE BEST OF MY KNOWLEDGE AND BELIEF

Robert L. Meadows Jr.
ROBERT L. MEADOWS JR. S-1801
MAPPING DATE 6/6/86



1986.047 4-428