


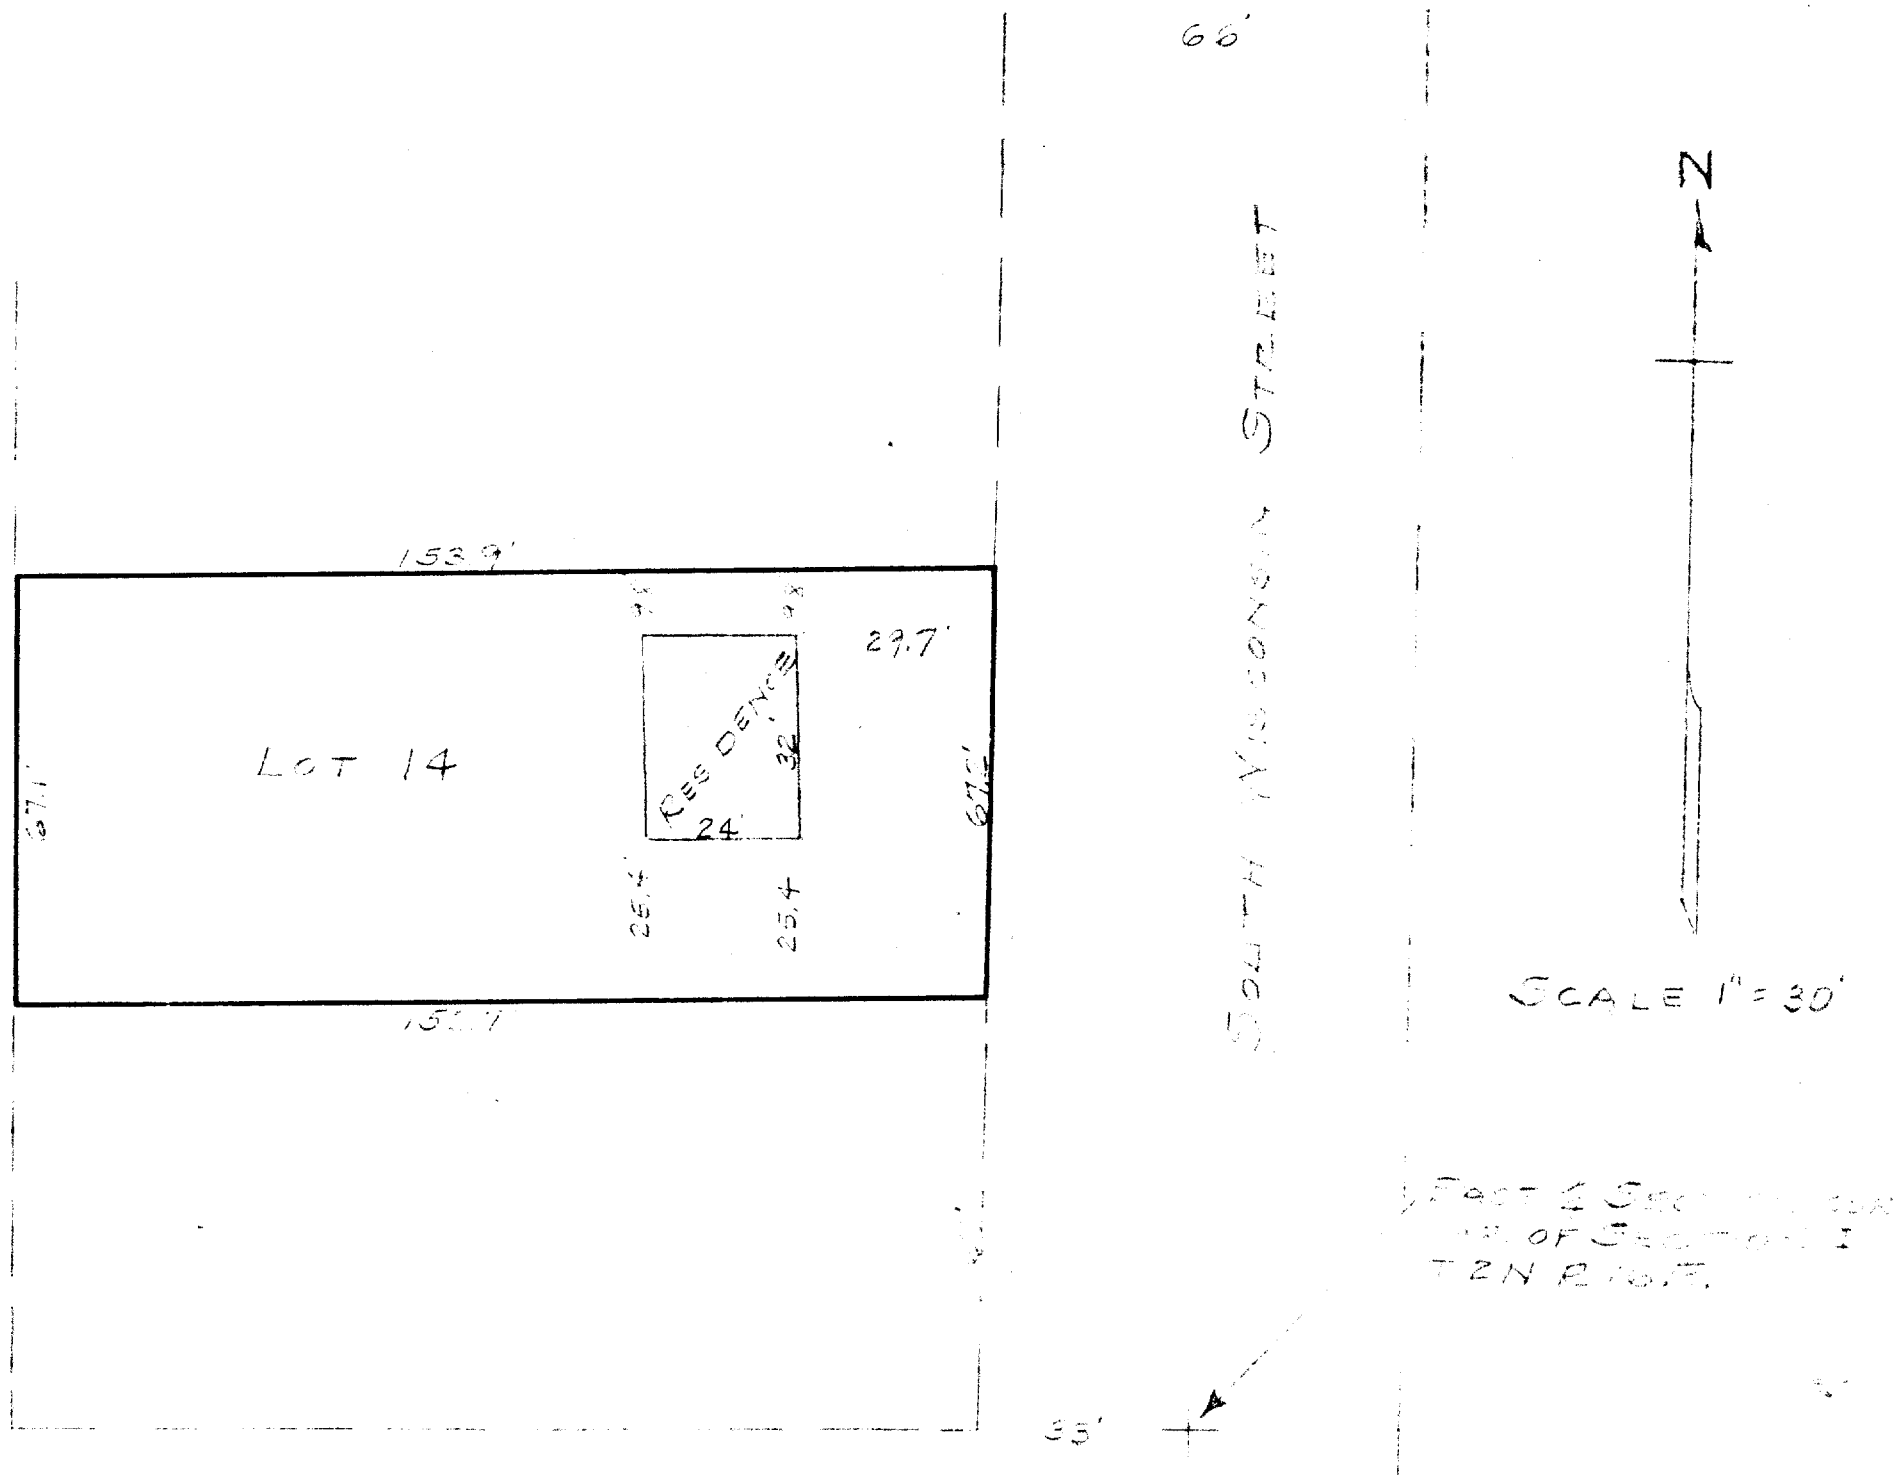

PLAT OF SURVEY

CF

Lot 14 of Block 4 of Preston's Addition to the City of Elkhorn, Walworth County, Wisconsin to show lot lines and principal lines of buildings thereon.

January 13, 1958

David R. Spence
County Surveyor