



ABELL
SURVEYING & MAPPING
DELAVAN, WISCONSIN 53115
414-728-6737

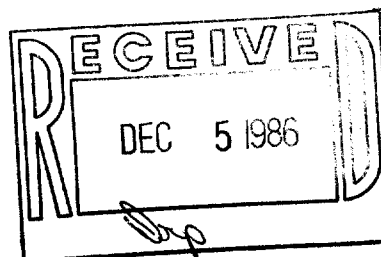

THIRD AVENUE


ORDERED BY: PAT WINGREN
RT. 5, BOX 256
DELAVAN, WI 53115

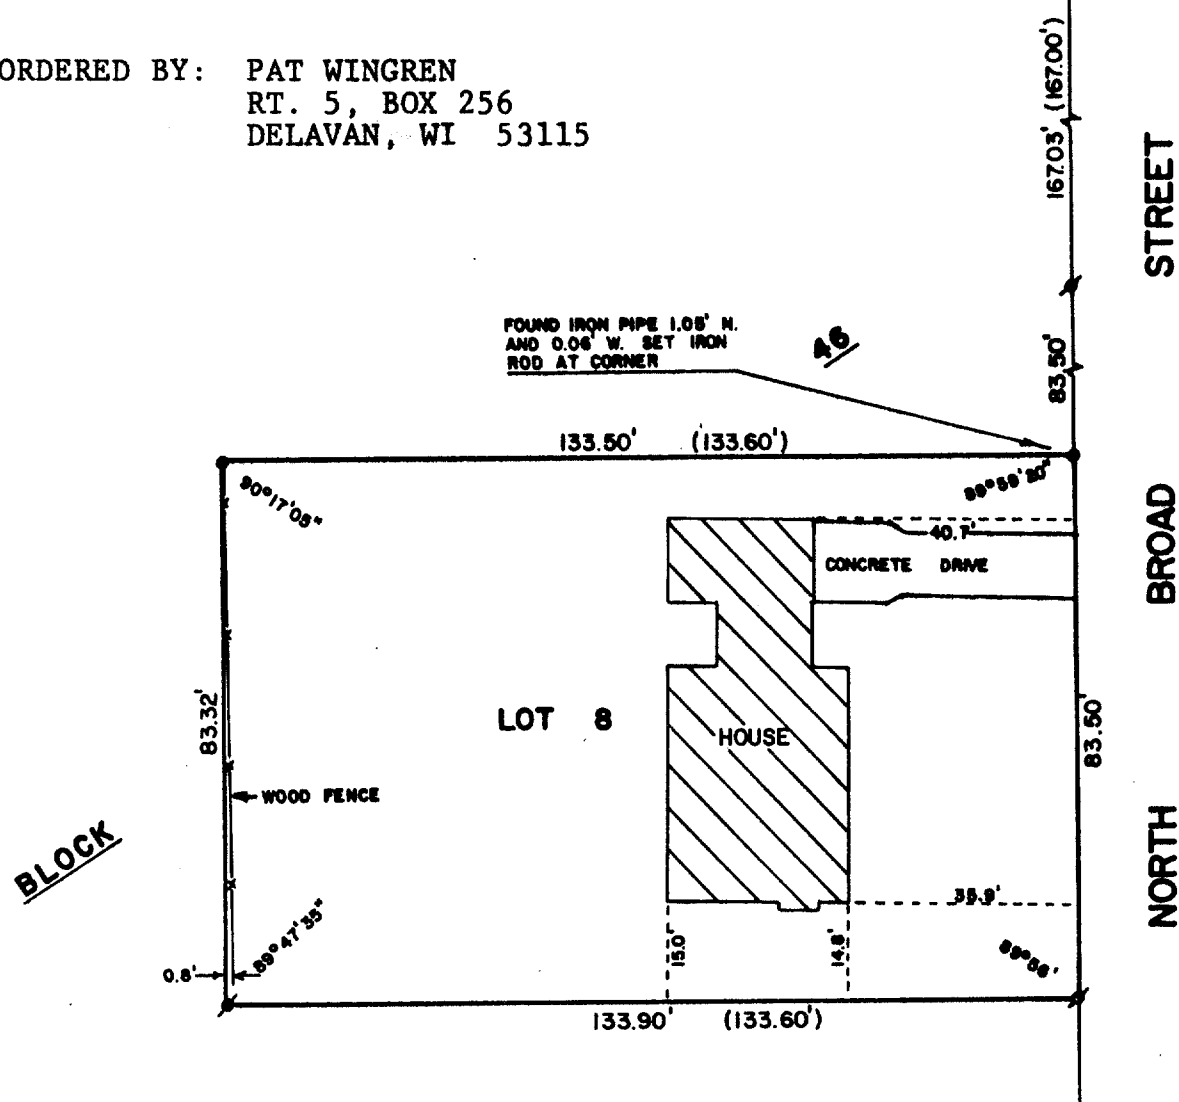

PLAT OF SURVEY OF

LOT 8, BLOCK 46, DAVIS ADDITION, CITY OF
ELKHORN, WALWORTH COUNTY, WISCONSIN.

NOTE: INFORMATION ON BLOCK OVERRUN AND UNDERRUN TAKEN
FROM MR. TUBBS RESURVEYS OF THE CITY OF ELKHORN
FILED IN THE CITY ENGINEERS OFFICE.

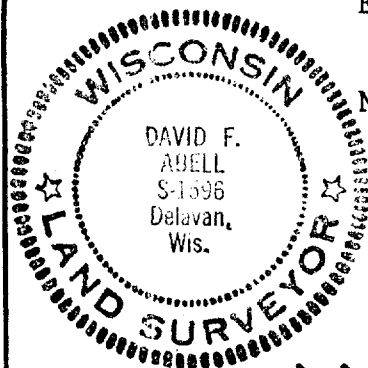

SCALE - 1"=30'

LEGEND

- IRON PIPE FOUND
- IRON ROD FOUND
- CONCRETE MONUMENT FOUND
- () - AS SHOWN ON CITY ENGINEERS RECORDS.

I, DAVID F. ABELL, DO HEREBY CERTIFY
THAT I HAVE SURVEYED THE PROPERTY
HEREON DESCRIBED ACCORDING TO THE
OFFICIAL RECORDS AND THAT THE PLAT
HEREON IS A CORRECT REPRESENTATION
OF THE PROPERTY LINES TO THE BEST OF
MY KNOWLEDGE AND BELIEF.

David F. Abell
DAVID F. ABELL
WISCONSIN REGISTERED LAND SURVEYOR, S-1596

October 8, 1986
DATE JOB NUMBER - 86057