



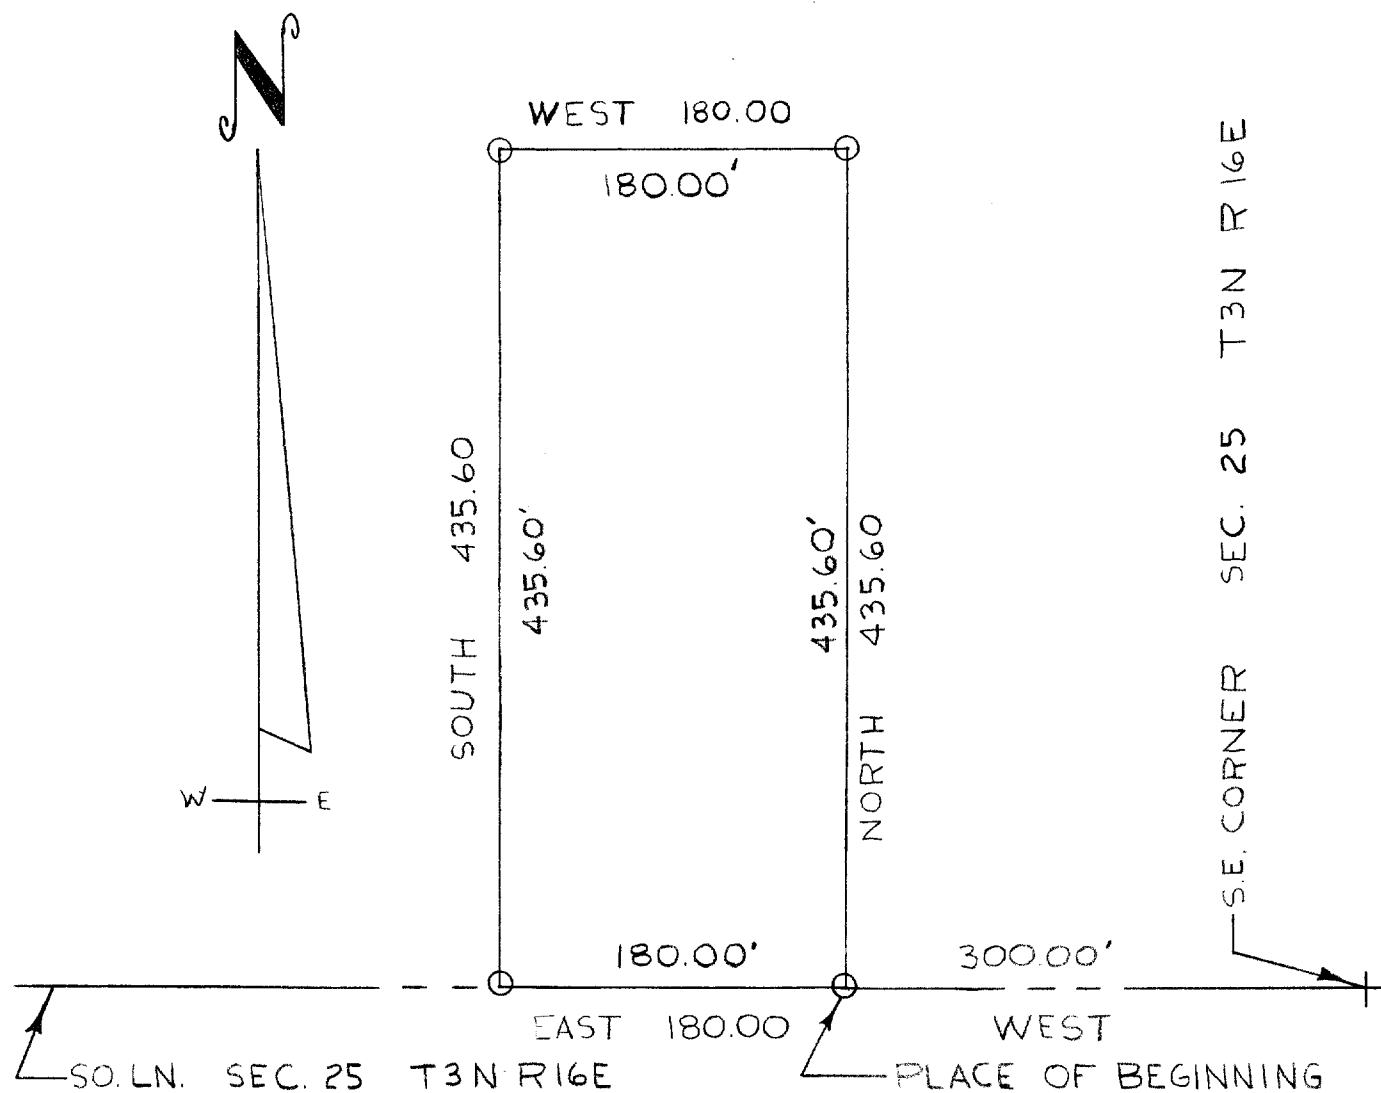

DESCRIPTION: Commencing at the S.E. Corner of Section 25, T.3 N., R. 16 E., Walworth County, Wisconsin; thence West on the South line of said Section 300.00 feet to the place of beginning, thence North 435.60 feet, thence West 180.00 feet, thence South 435.60 feet, thence East 180.00 feet to the place of beginning.

CERTIFICATE: I, James F. Biagi, surveyor, do hereby certify that I have surveyed the property hereon described.

November 8, 1968.

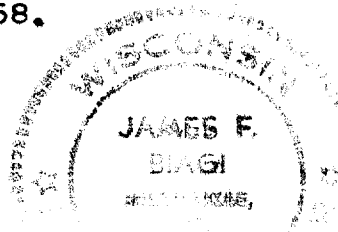

James F. Biagi RLS 712

4 316.43B.2