


Plat of Survey of The East 67 feet of Lot 24 and the West 53 feet
of Lot 25 James Jones Addition to the City of Elkhorn, Walworth
County Wisconsin



W. ROCKWELL STREET

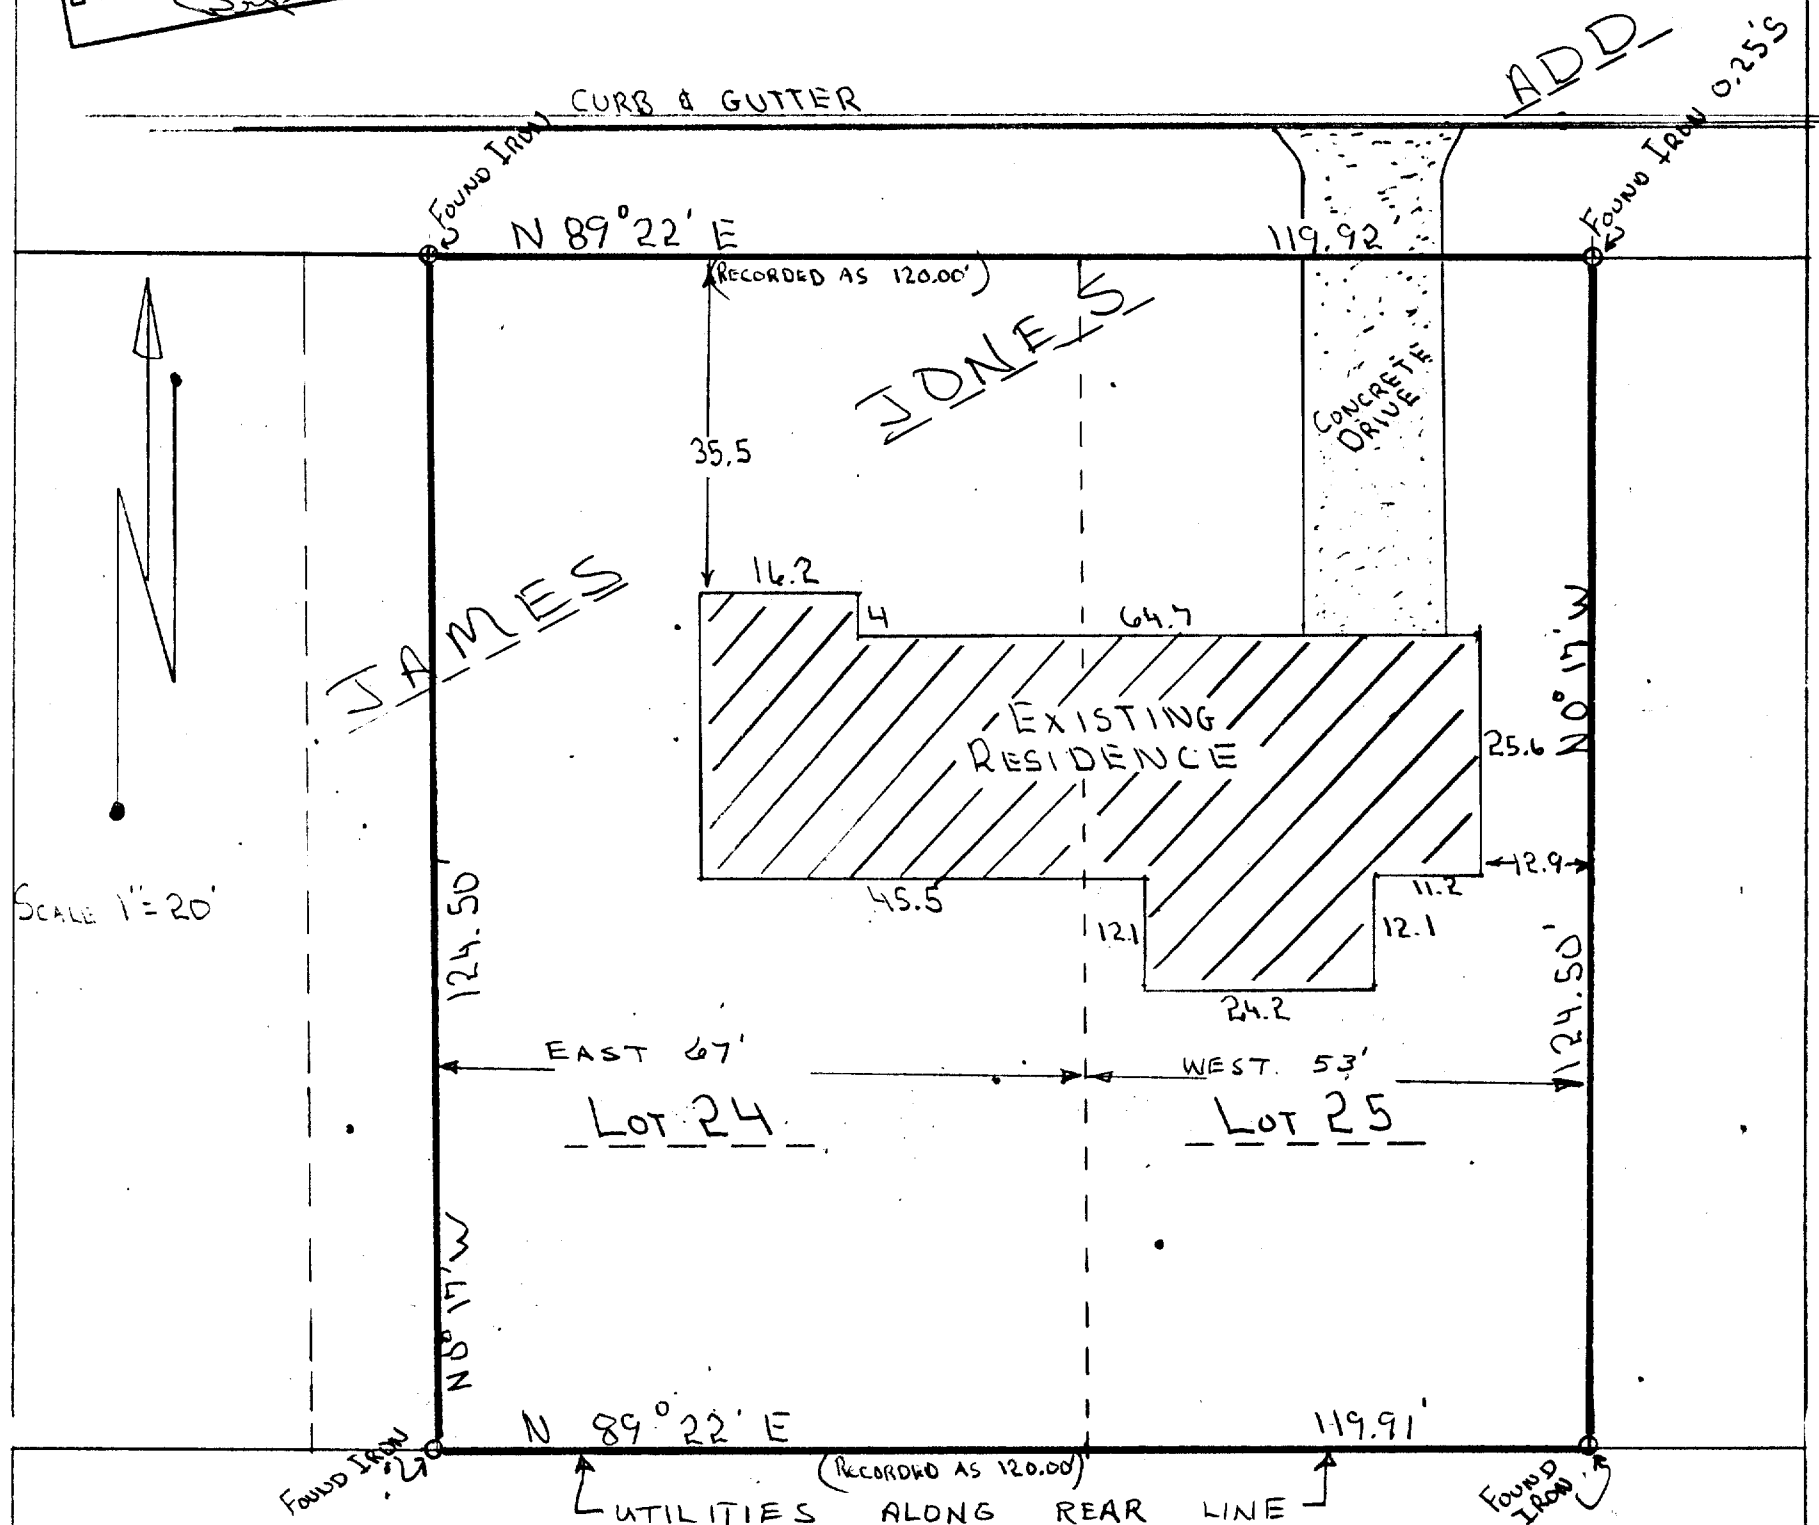

D.D. COOPER & CO. INC.

Route 4 Box 508B
Elkhorn WI 53121
Phone-414-723-6265


Survey ordered by Modern Realty
North Wisconsin St
Elkhorn WI

Bearing Reference: Northerly line of Lot assumed
to Bear N89 22'E as platted

I, Daniel D. Cooper, Registered Land Surveyor do hereby certify that
I have surveyed the property described hereon and that the map shown
hereon is a true and accurate representation thereof to the best of my
professional knowledge and belief.

Dated this 11 day of Dec 1986

Daniel D. Cooper, RLS NO. S-1464

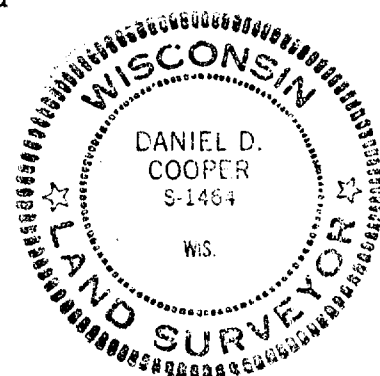

45A-24

DRAWING NO. 3037-S