


59-35


6-10-00

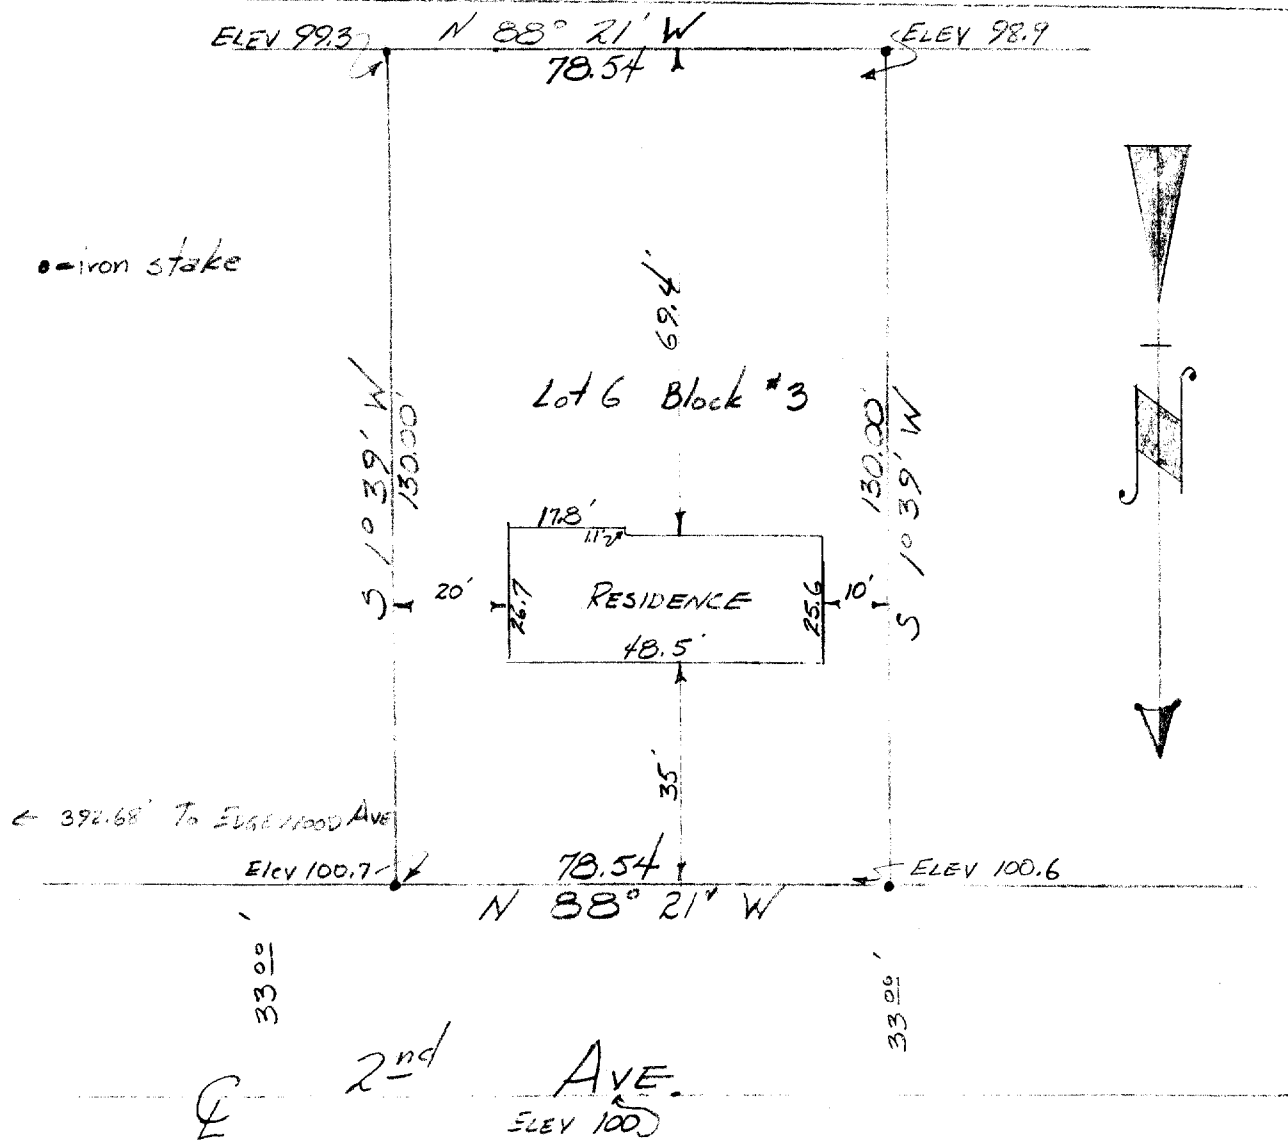

DESCRIPTION: Lot 6 of Block 3 of Edgewood Subdivision in the City of Elkhorn, Walworth County, Wisconsin.

CERTIFICATE: I, James F. Biagi, surveyor, do hereby certify that I have surveyed the property hereon described, and that the locations of all the improvements are as shown above.

Signed and Sealed this 31st day of October 1959.

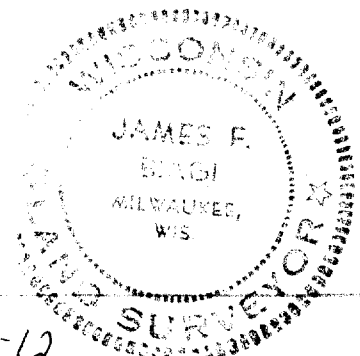

James F. Biagi
James F. Biagi, Surveyor

1-42B

YE-12

4-45B