



AUG 12 1987

Plat of Survey of Lot 4, Block 8, of the Original Plat
to the City of Elkhorn, Walworth County, Wisconsin

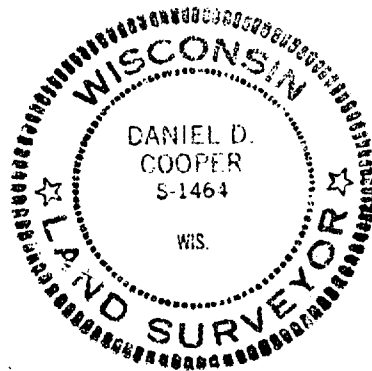

SCALE 1"=20'

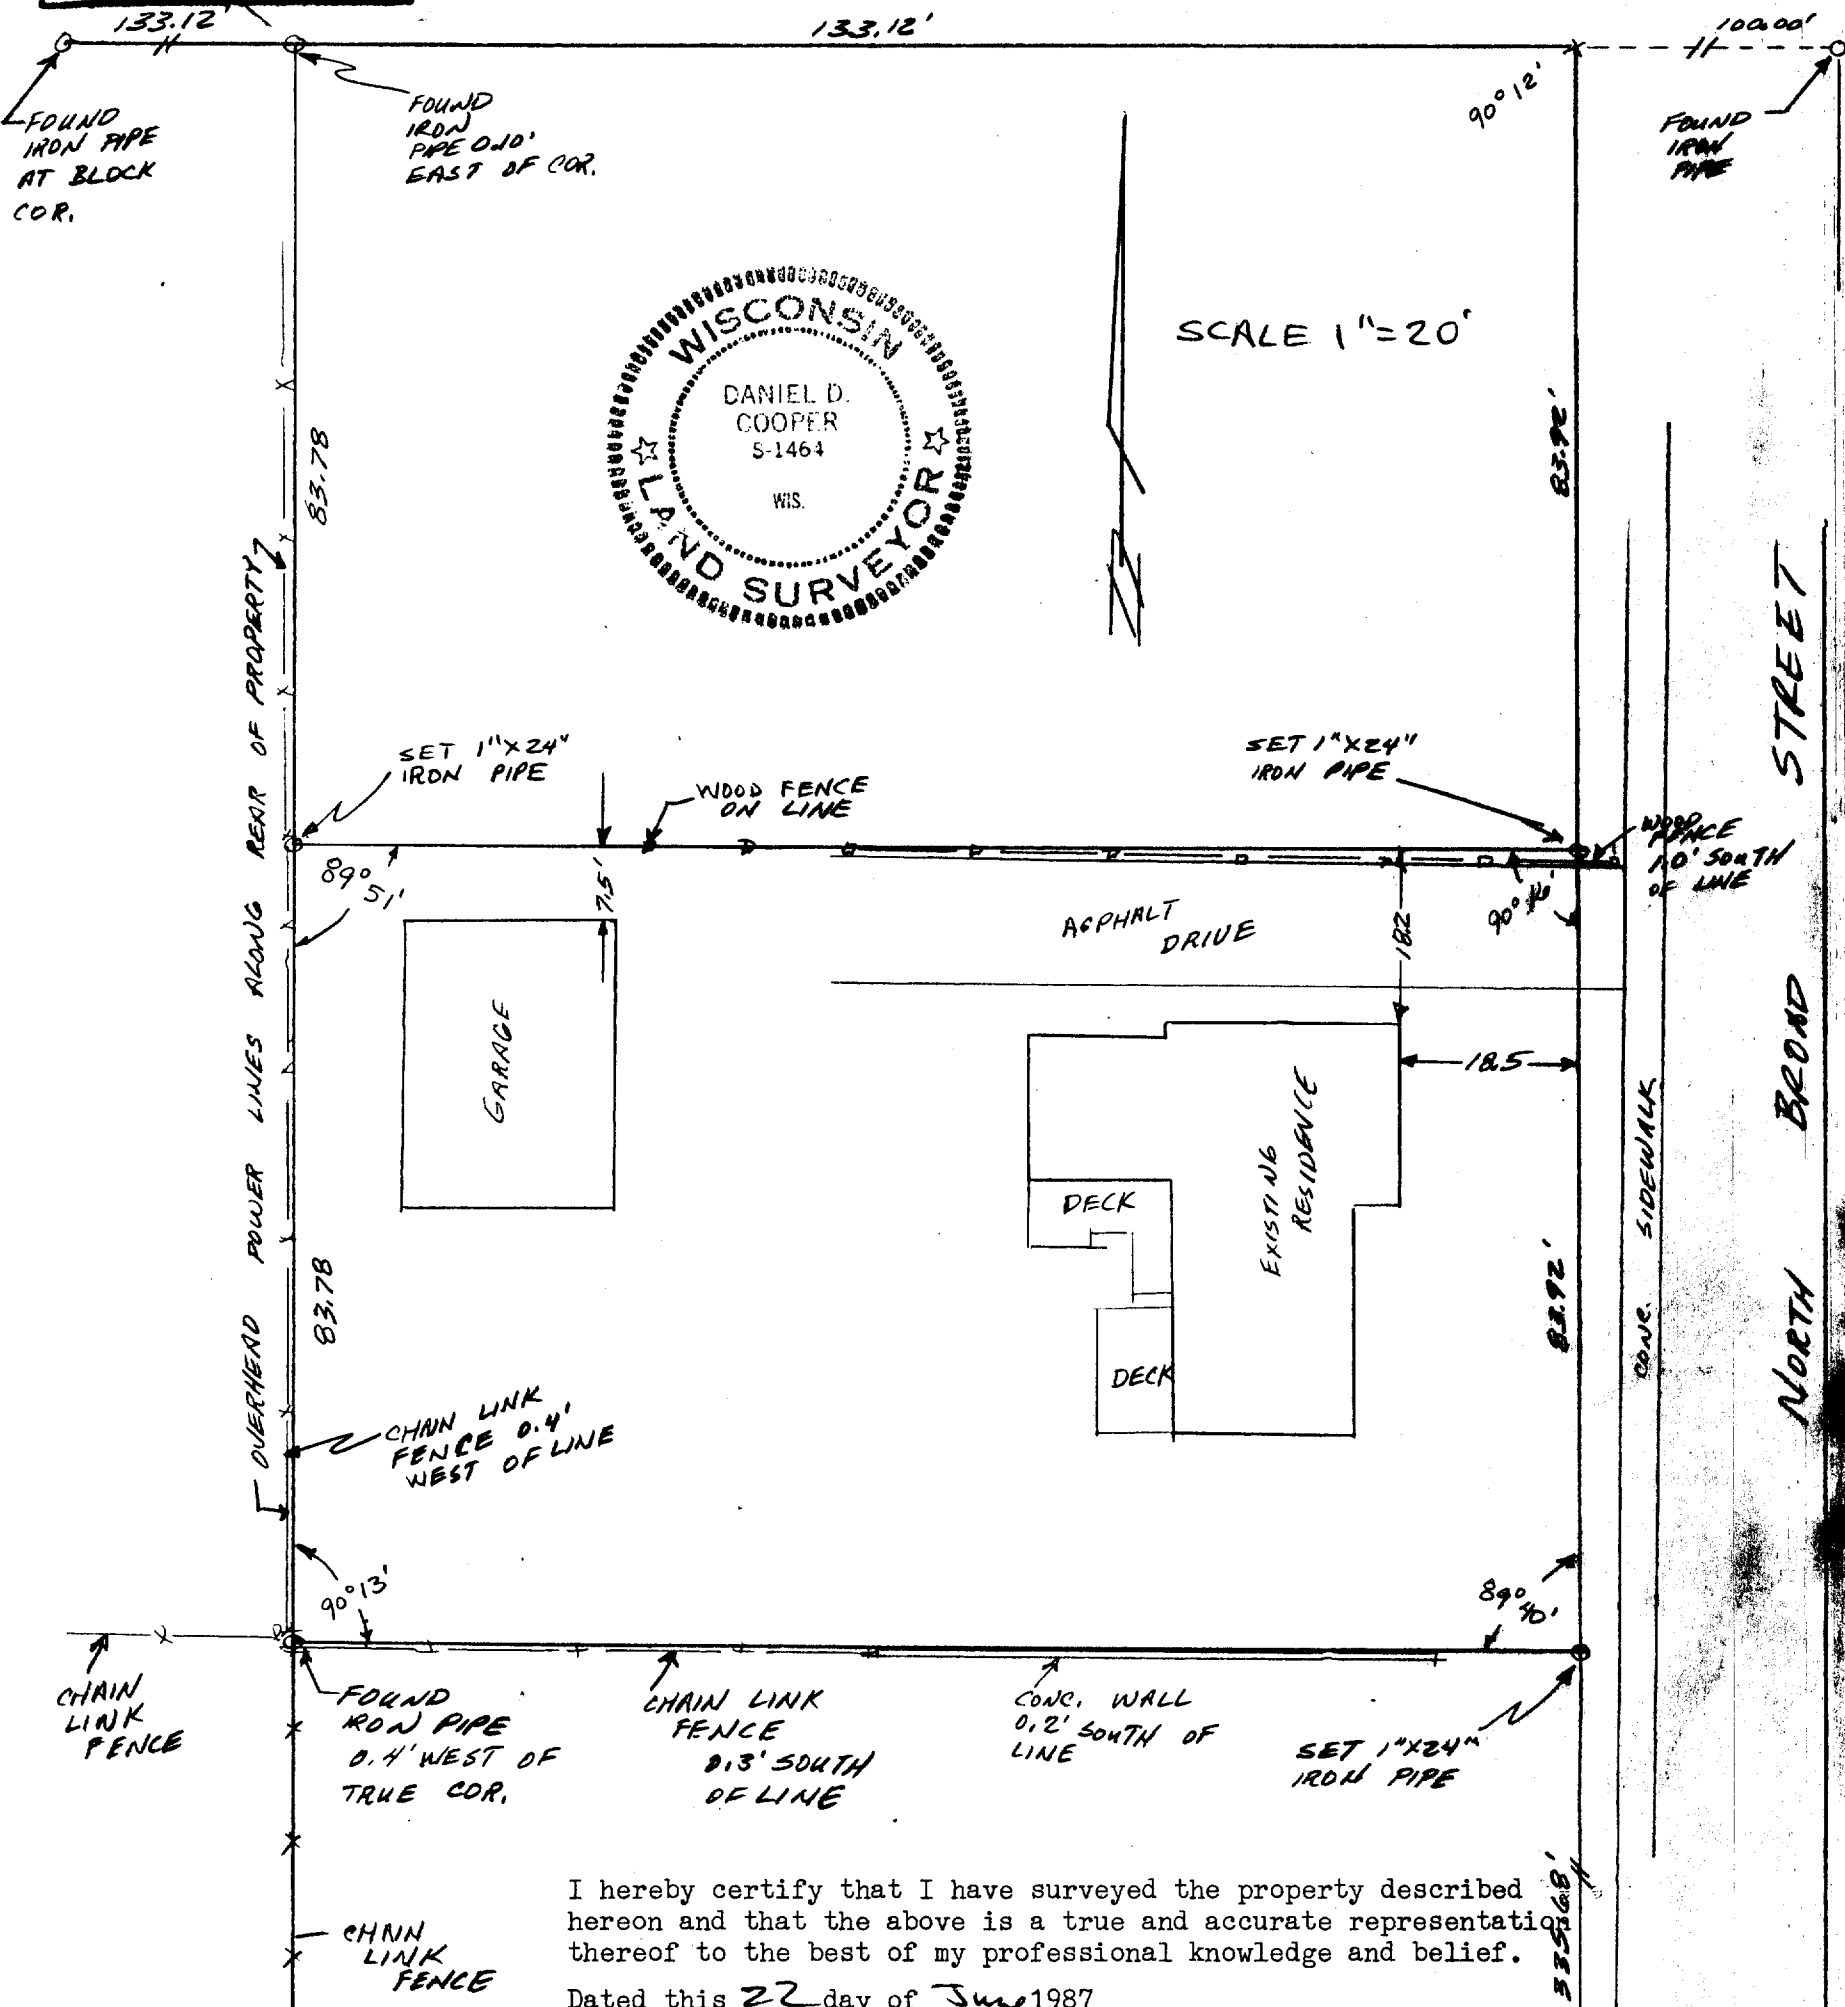

I hereby certify that I have surveyed the property described
hereon and that the above is a true and accurate representation
thereof to the best of my professional knowledge and belief.

Dated this 22 day of June 1987

Daniel D. Cooper

Daniel D. Cooper, RLS No. S-1464

D. D. COOPER & CO., INC.
Daniel D. Cooper
Rt. 4 Box 508B
Elkhorn, WI 53121

Survey ordered by Modern Realty-Elkhorn

DRAWING NO. 3104