

FARRIS, HANSEN & ASSOCIATES, INC.

7 RIDGEWAY COURT, P.O. BOX 487, ELKHORN, WISCONSIN

TEL. 414-723-2098

LOCATION: LOT 3 AND NORTH 1/2 OF LOT 6 BLK 15 DRIG.
PLAT OF CITY OF ELKHORN, WALWORTH CO., WI.

MAP LEGEND


- O = IRON PIPE STAKE FOUND
- = IRON PIPE STAKE SET
- = IRON ROD STAKE FOUND
- = IRON ROD STAKE SET
- = CONCRETE MONUMENT FOUND
- (XXXX) = RECORD DIMENSION
- (XXXX) = GROUND ELEVATION

WORK ORDERED BY: ERSKINE CONSTRUCTION CO.

MAP SCALE IN FEET WEST LINE BLK 15 = NORTH (XXXX) = RECORD DIMENSION

NOTE: THIS SURVEY IS BASED SOLELY UPON THE RECORD TITLE DESCRIPTION FOR PARCELS 1 & 2 APPEARING IN DOCUMENT # 618977 RECORDED IN VOLUME 18 OF RECORDS BEGINNING ON PAGE 347. THE ABOVE DOCUMENT IS THE FINAL JUDGEMENT OF THE ESTATE OF ARTHUR C. SOMMER.

USERS OF THIS PLAT SHOULD ASCERTAIN THAT NO OTHER DOCUMENTS AFFECT TITLE TO THESE LANDS.

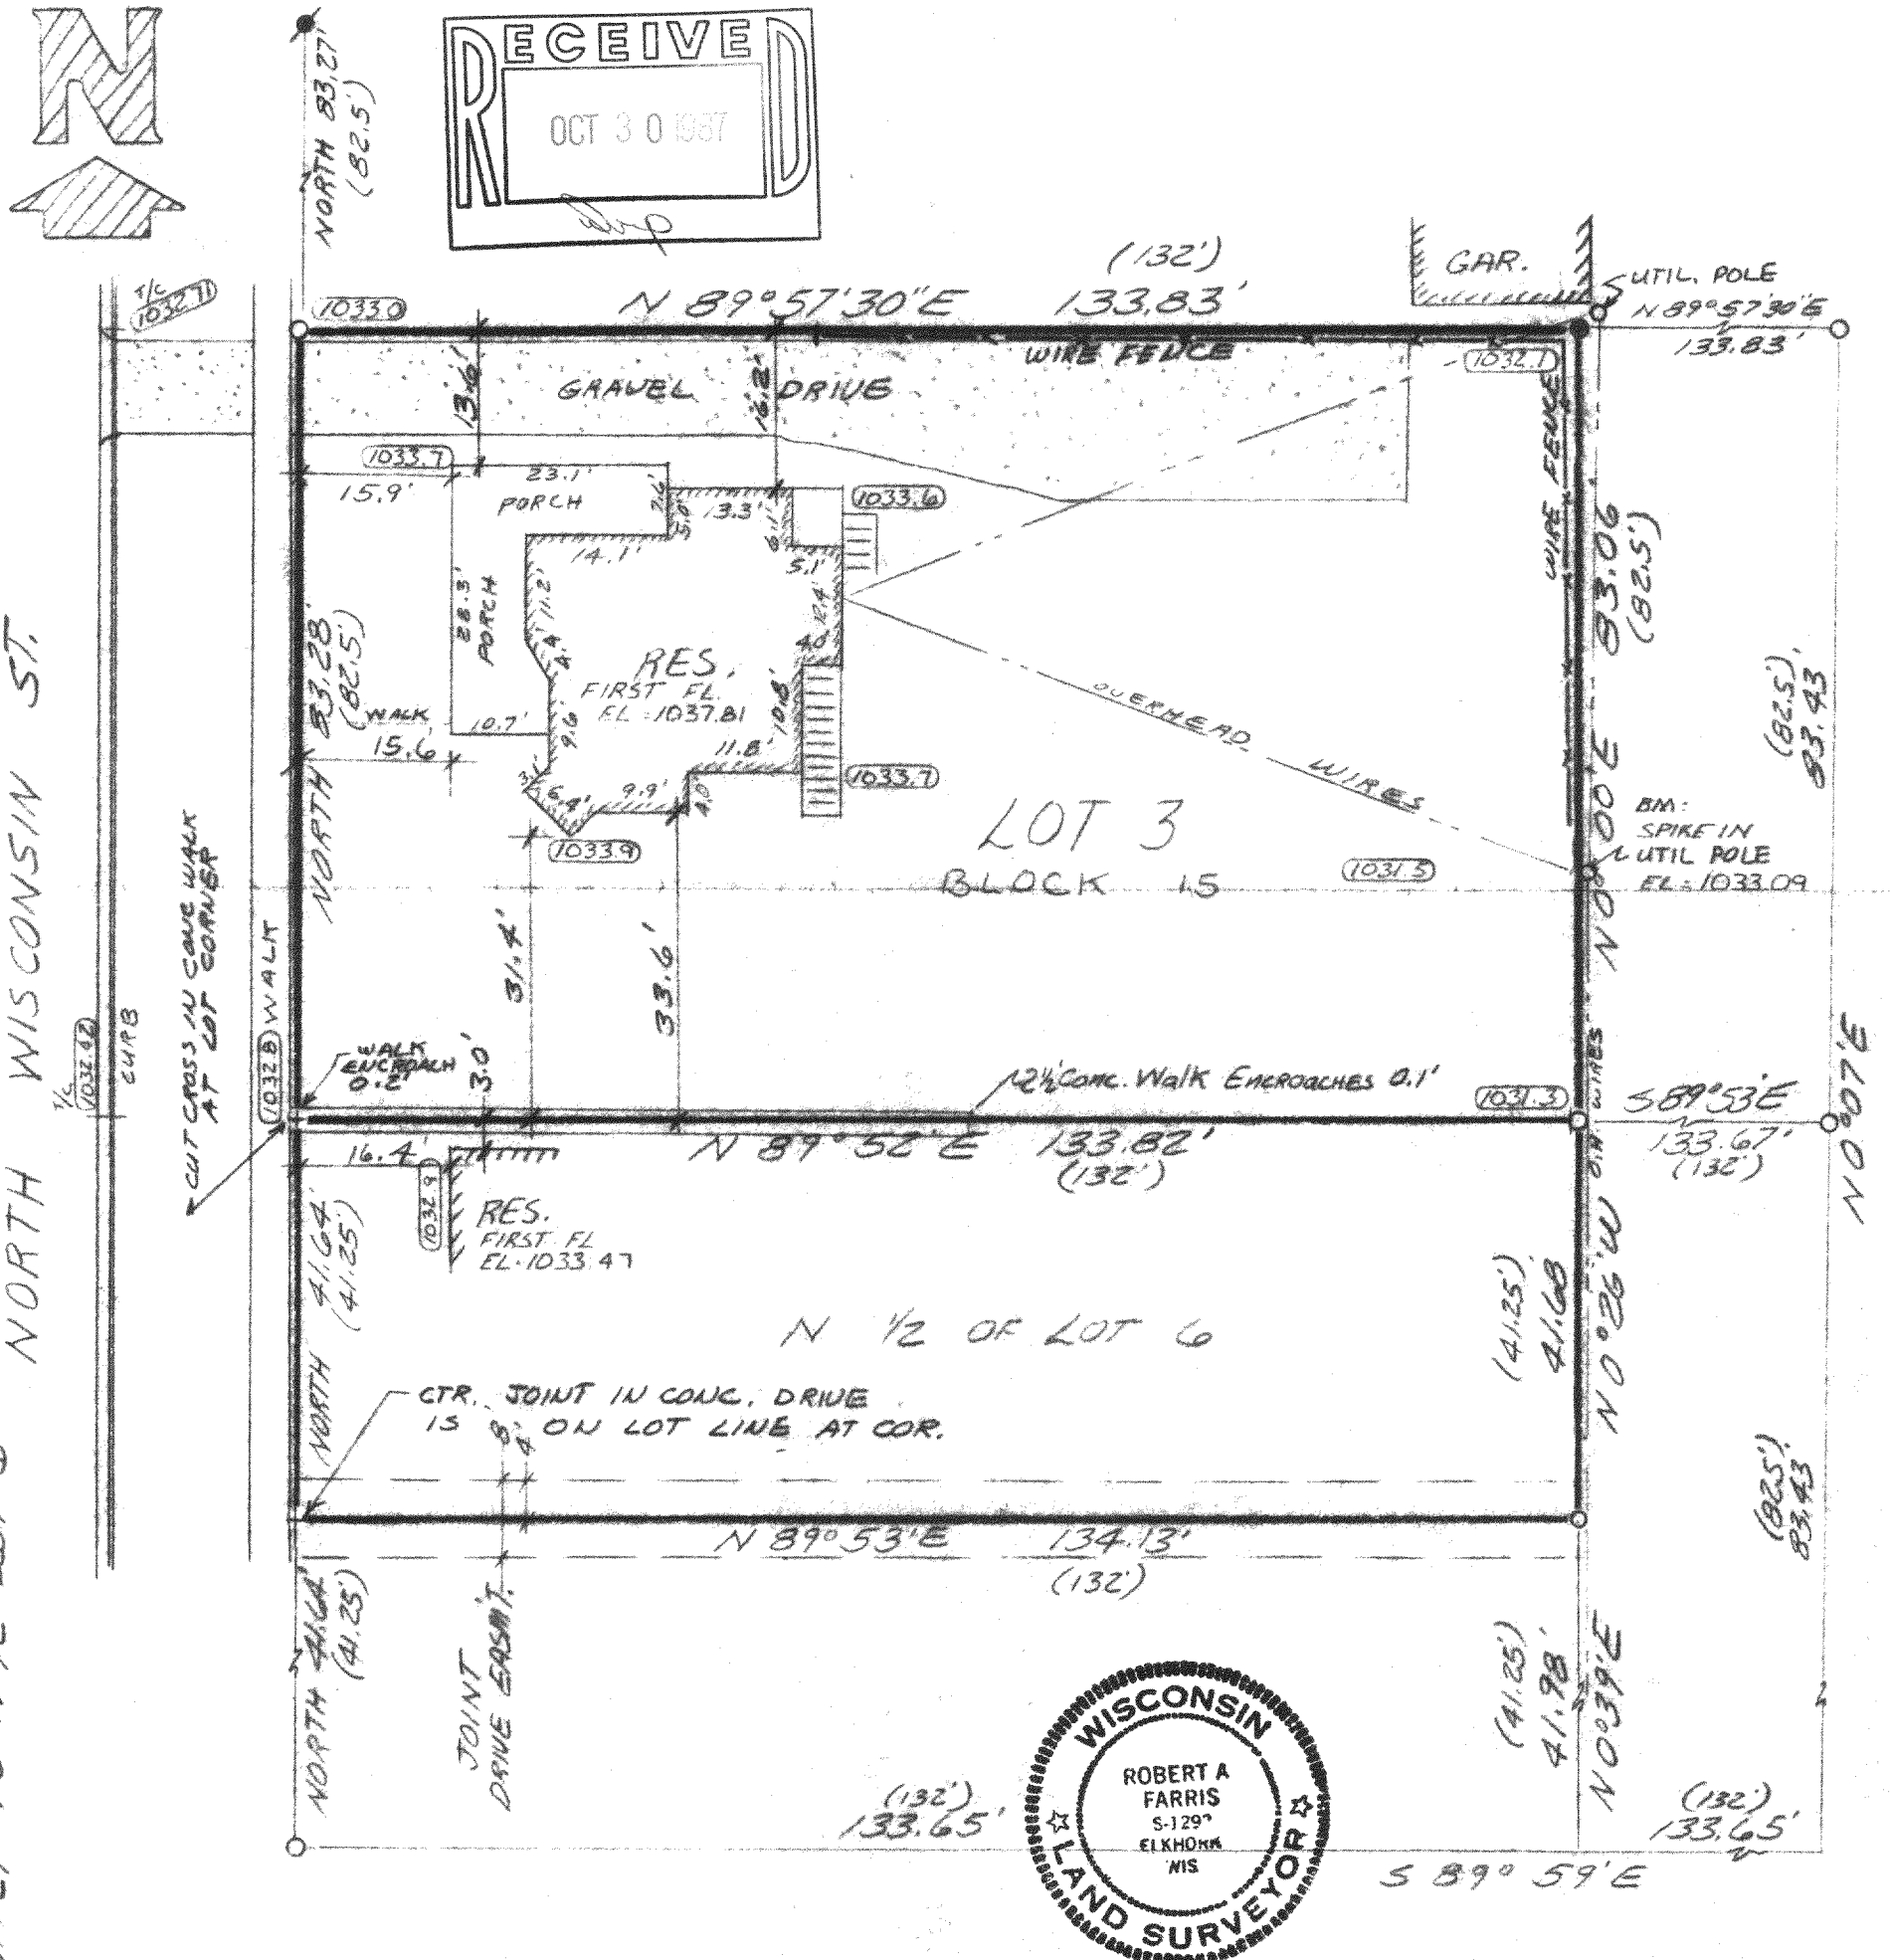

I hereby certify that the above described property has been surveyed under my direction and that the above map is a true representation thereof and shows the size and location of the property, its exterior boundaries, the location of all visible structures and dimensions of all principal buildings thereon, boundary fences, apparent easements, roadways and visible encroachments, if any. This survey is made for the use of the present owners of the property, and also those who purchase, mortgage, or guarantee the title thereto within one year from the date hereof.

DATED: AUG 20, 1987

Robert A. Farris

PROJ. NO. 2870