



# PLAT OF SURVEY

OF  
LOT 3, BLOCK 9, OF THE ORIGINAL PLAT OF THE VILLAGE ( NOW CITY ) OF ELKHORN, ACCORDING TO  
RECORDED PLAT THEREOF. LOCATED IN THE CITY OF ELKHORN, WASHINGTON COUNTY, WISCONSIN.

FOR THE ESTATE OF PEARL WALTER

SCALE 1" = 30'       $\sigma$  = IRON STAKE FOUND.       $\circ$  = 60d SPIKE SET.

TUBBS 1930 REFERS TO A 1930 SURVEY OF THIS BLOCK AND OTHERS IN THE  
ORIGINAL PLAT OF ELKHORN WHICH IS ON FILE IN COURT HOUSE.

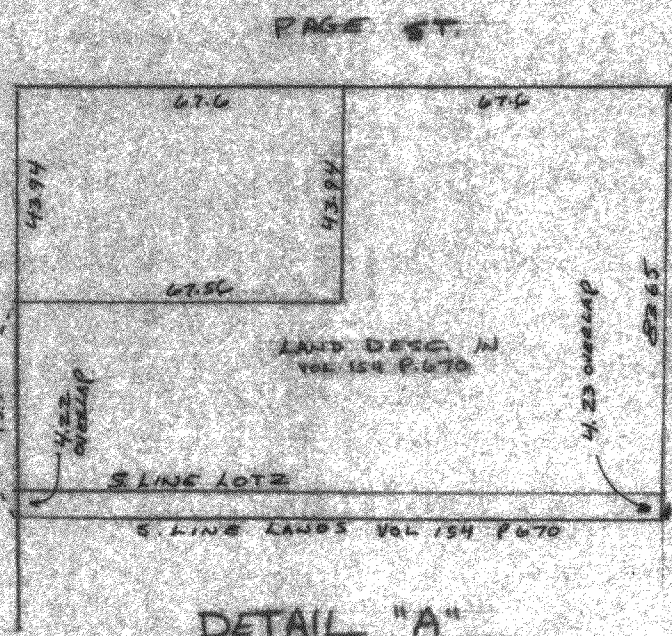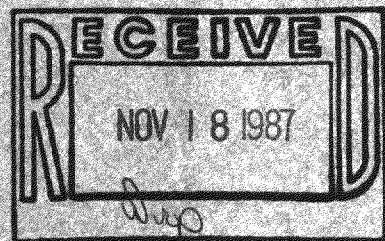

I have surveyed the above-described property, and the map herein is a true representation thereof and shows the size and location of the property, its exterior boundaries, the location and dimensions of all visible structures thereon, fences, apparent easements and roadways and visible encroachments, if any.

This survey is made for the exclusive use of the present owners of the property, and also those who purchase, mortgage, or guarantee the title thereto, within one year from date hereof.

Dated at Burlington, this 14th day of OCTOBER, 1987.  
*John F. Degen*  
John F. Degen, Land Surveyor & S.D.

N. BROAD ST.

W. PAGE ST.

502.10 TUBBS 1930  
501.96 MEAS.  
475 RECORD

BLOCK 9

N. WISCONSIN ST.

501.87 MEAS.  
475 RECORD  
502.2 TUBBS 1930

W. JEFFERSON ST.

4491

15-R #6