


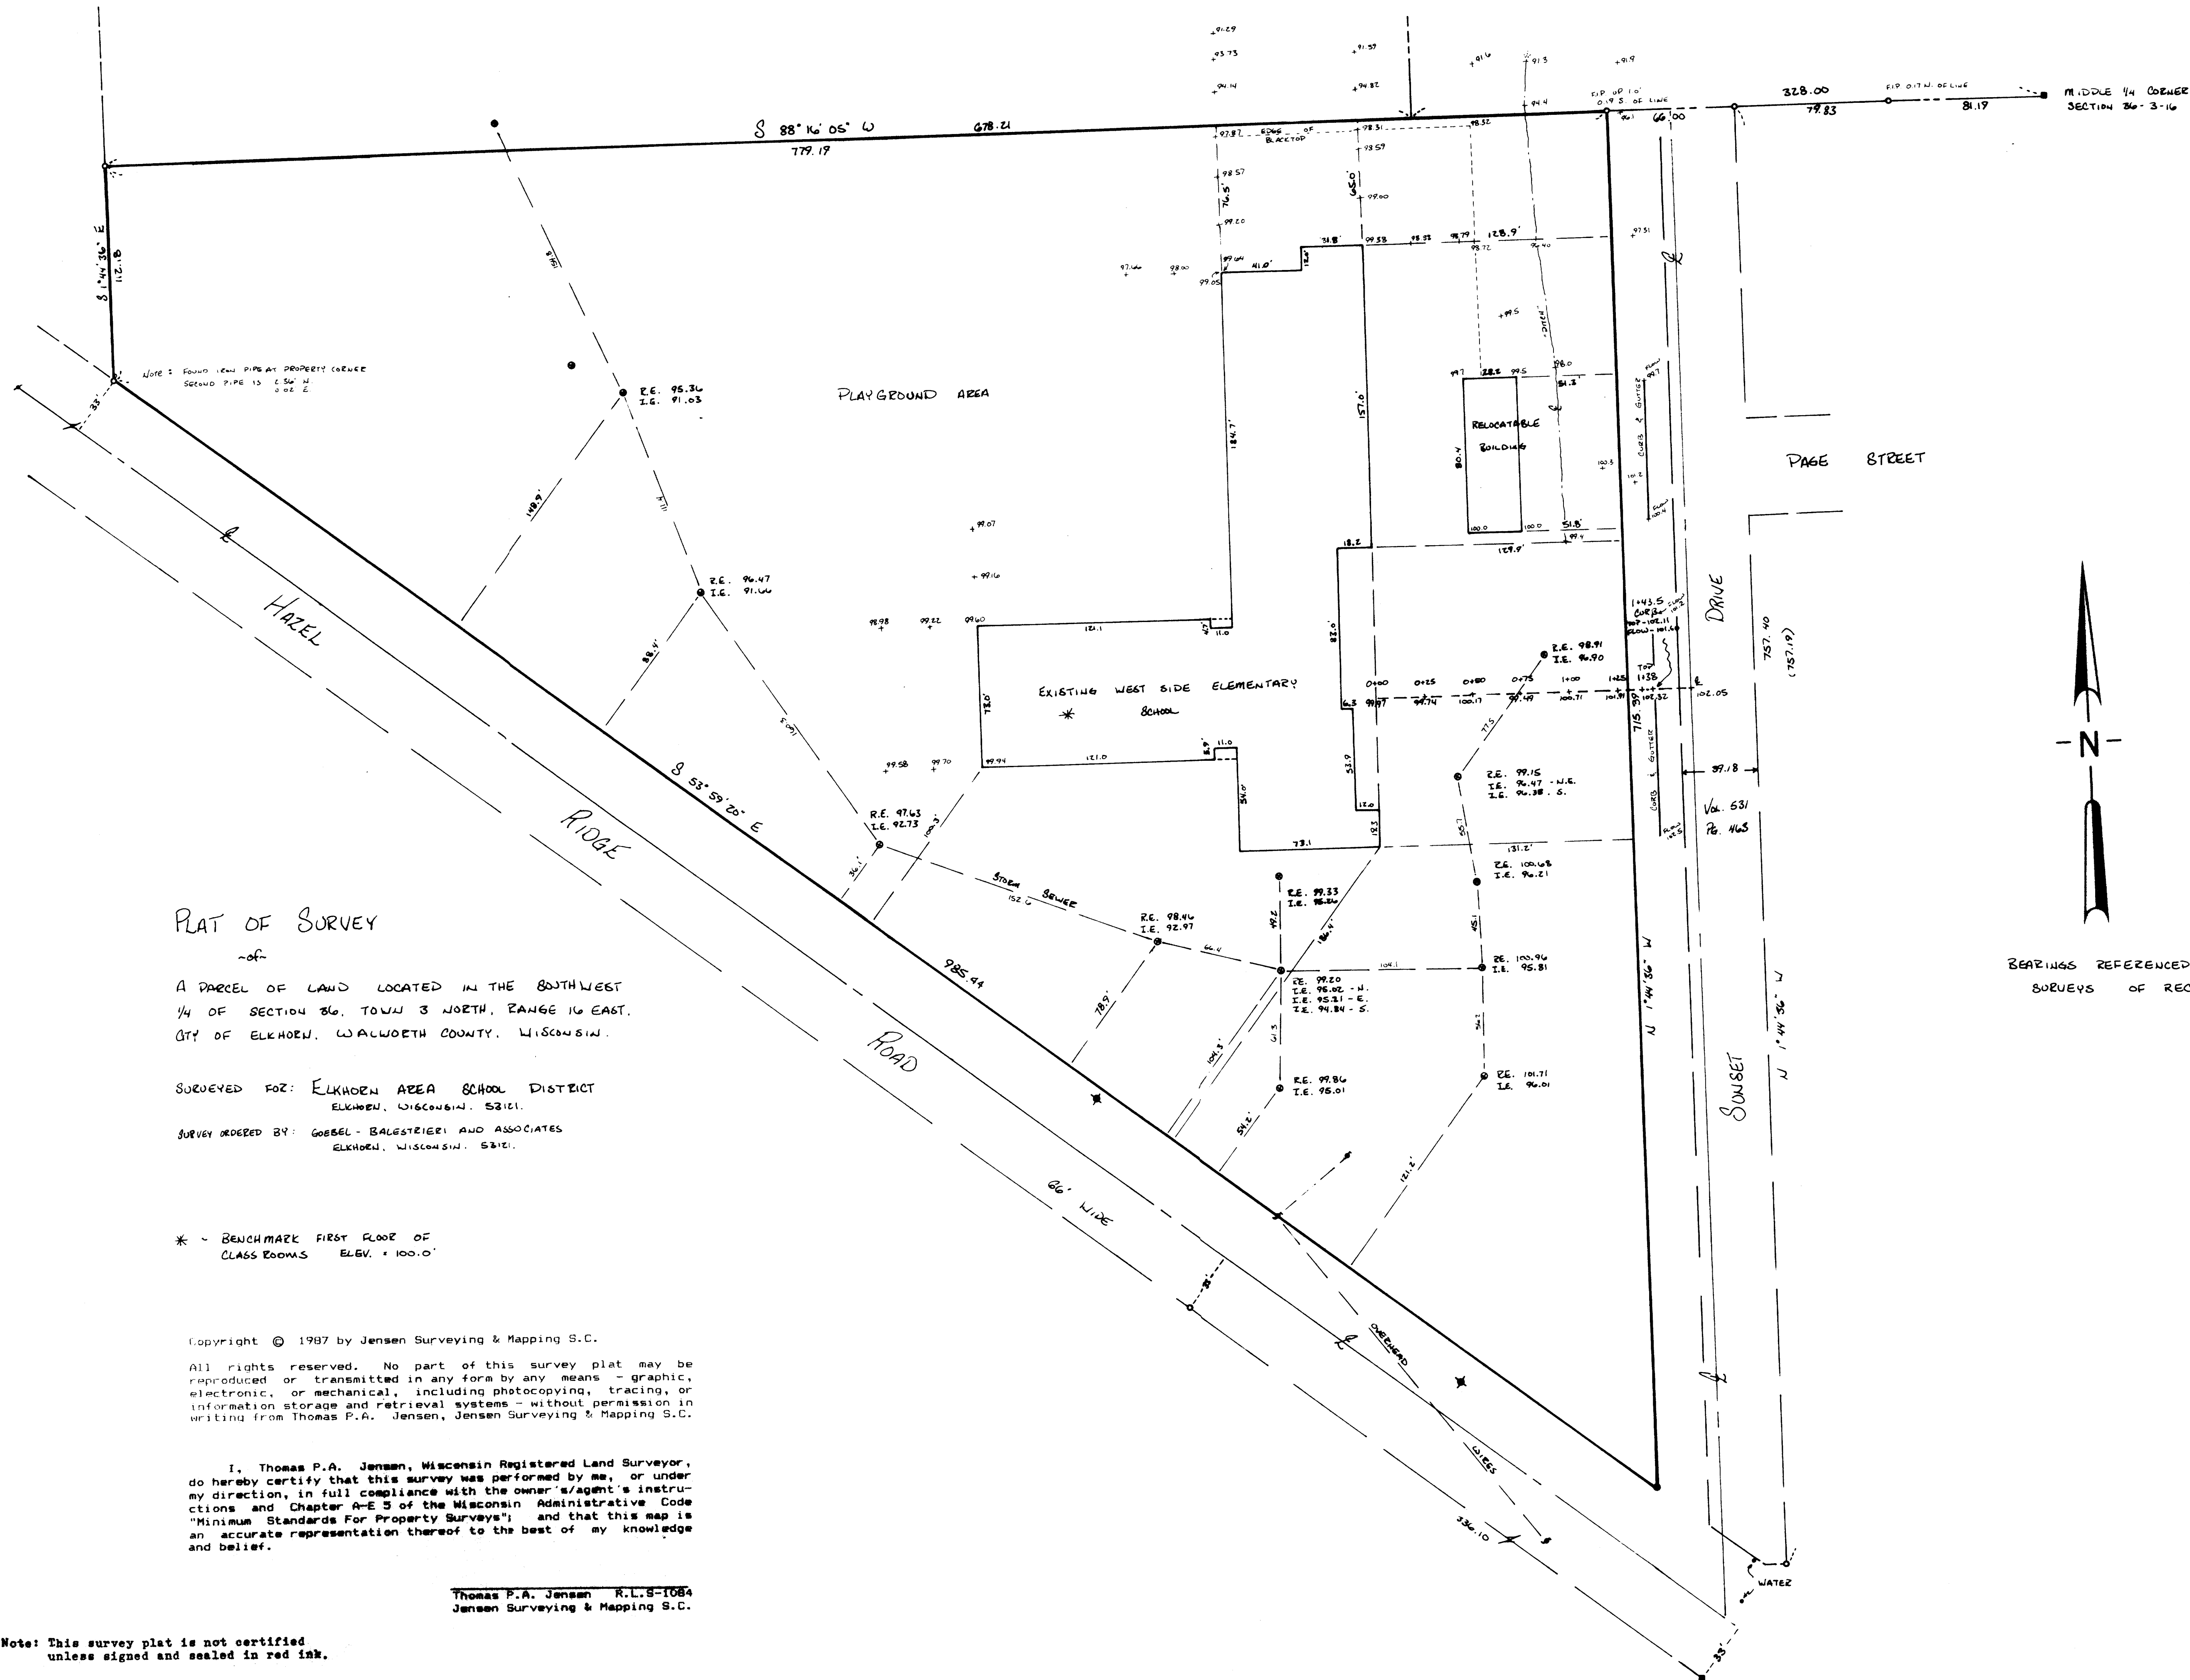

PLAT OF SURVEY

A PARCEL OF LAND LOCATED IN THE SOUTHWEST 1/4 OF SECTION 36, TOWN 3 NORTH, RANGE 16 EAST, CITY OF ELKHORN, WALWORTH COUNTY, WISCONSIN.

SURVEYED FOR: ELKHORN AREA SCHOOL DISTRICT
ELKHORN, WISCONSIN. 53121.
SURVEY ORDERED BY: GOBBEL - BALESTRIERI AND ASSOCIATES
ELKHORN, WISCONSIN. 53121.

* - BENCHMARK FIRST FLOOR OF CLASS ROOMS ELEV. = 100.0'



Copyright © 1987 by Jensen Surveying & Mapping S.C.

All rights reserved. No part of this survey plat may be reproduced or transmitted in any form by any means - graphic, electronic, or mechanical, including photocopying, tracing, or information storage and retrieval systems - without permission in writing from Thomas P.A. Jensen, Jensen Surveying & Mapping S.C.

I, Thomas P.A. Jensen, Wisconsin Registered Land Surveyor, do hereby certify that this survey was performed by me, or under my direction, in full compliance with the owner's/agent's instructions and Chapter A-E 5 of the Wisconsin Administrative Code "Minimum Standards For Property Surveys"; and that this map is an accurate representation thereof to the best of my knowledge and belief.

Thomas P.A. Jensen R.L.S-1084
Jensen Surveying & Mapping S.C.

Note: This survey plat is not certified unless signed and sealed in red ink.

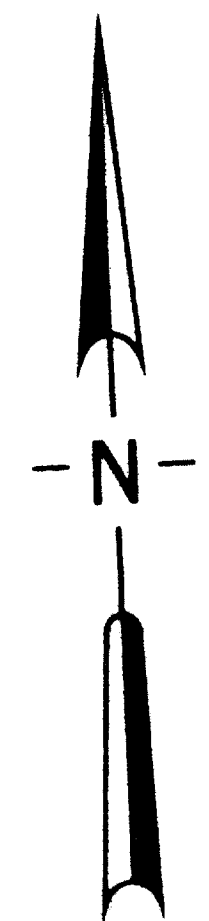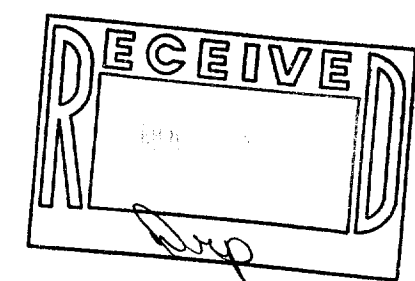

BEARINGS REFERENCED TO PREVIOUS SURVEYS OF RECORD.

Mapping date: 6-11-87
Revisions: 6-17-87

Scale: 1" = 40'
40' 20' 0' 40'



JENSEN SURVEYING & MAPPING S.C.
45 South Wisconsin Street P.O. Box 322
Elkhorn, Wisconsin 53121
(414) 723-3434

Legend
- FOUND CONCRETE MONUMENT
o- FOUND IRON PIPE
- FOUND NAIL
o- SET IRON ROD 3/4"
- UTILITY POLE
- MANHOLE
o- CATCH BASIN

Sheet no. 1 of 1 sheets.
Job reference number
1987.063

1987.063