


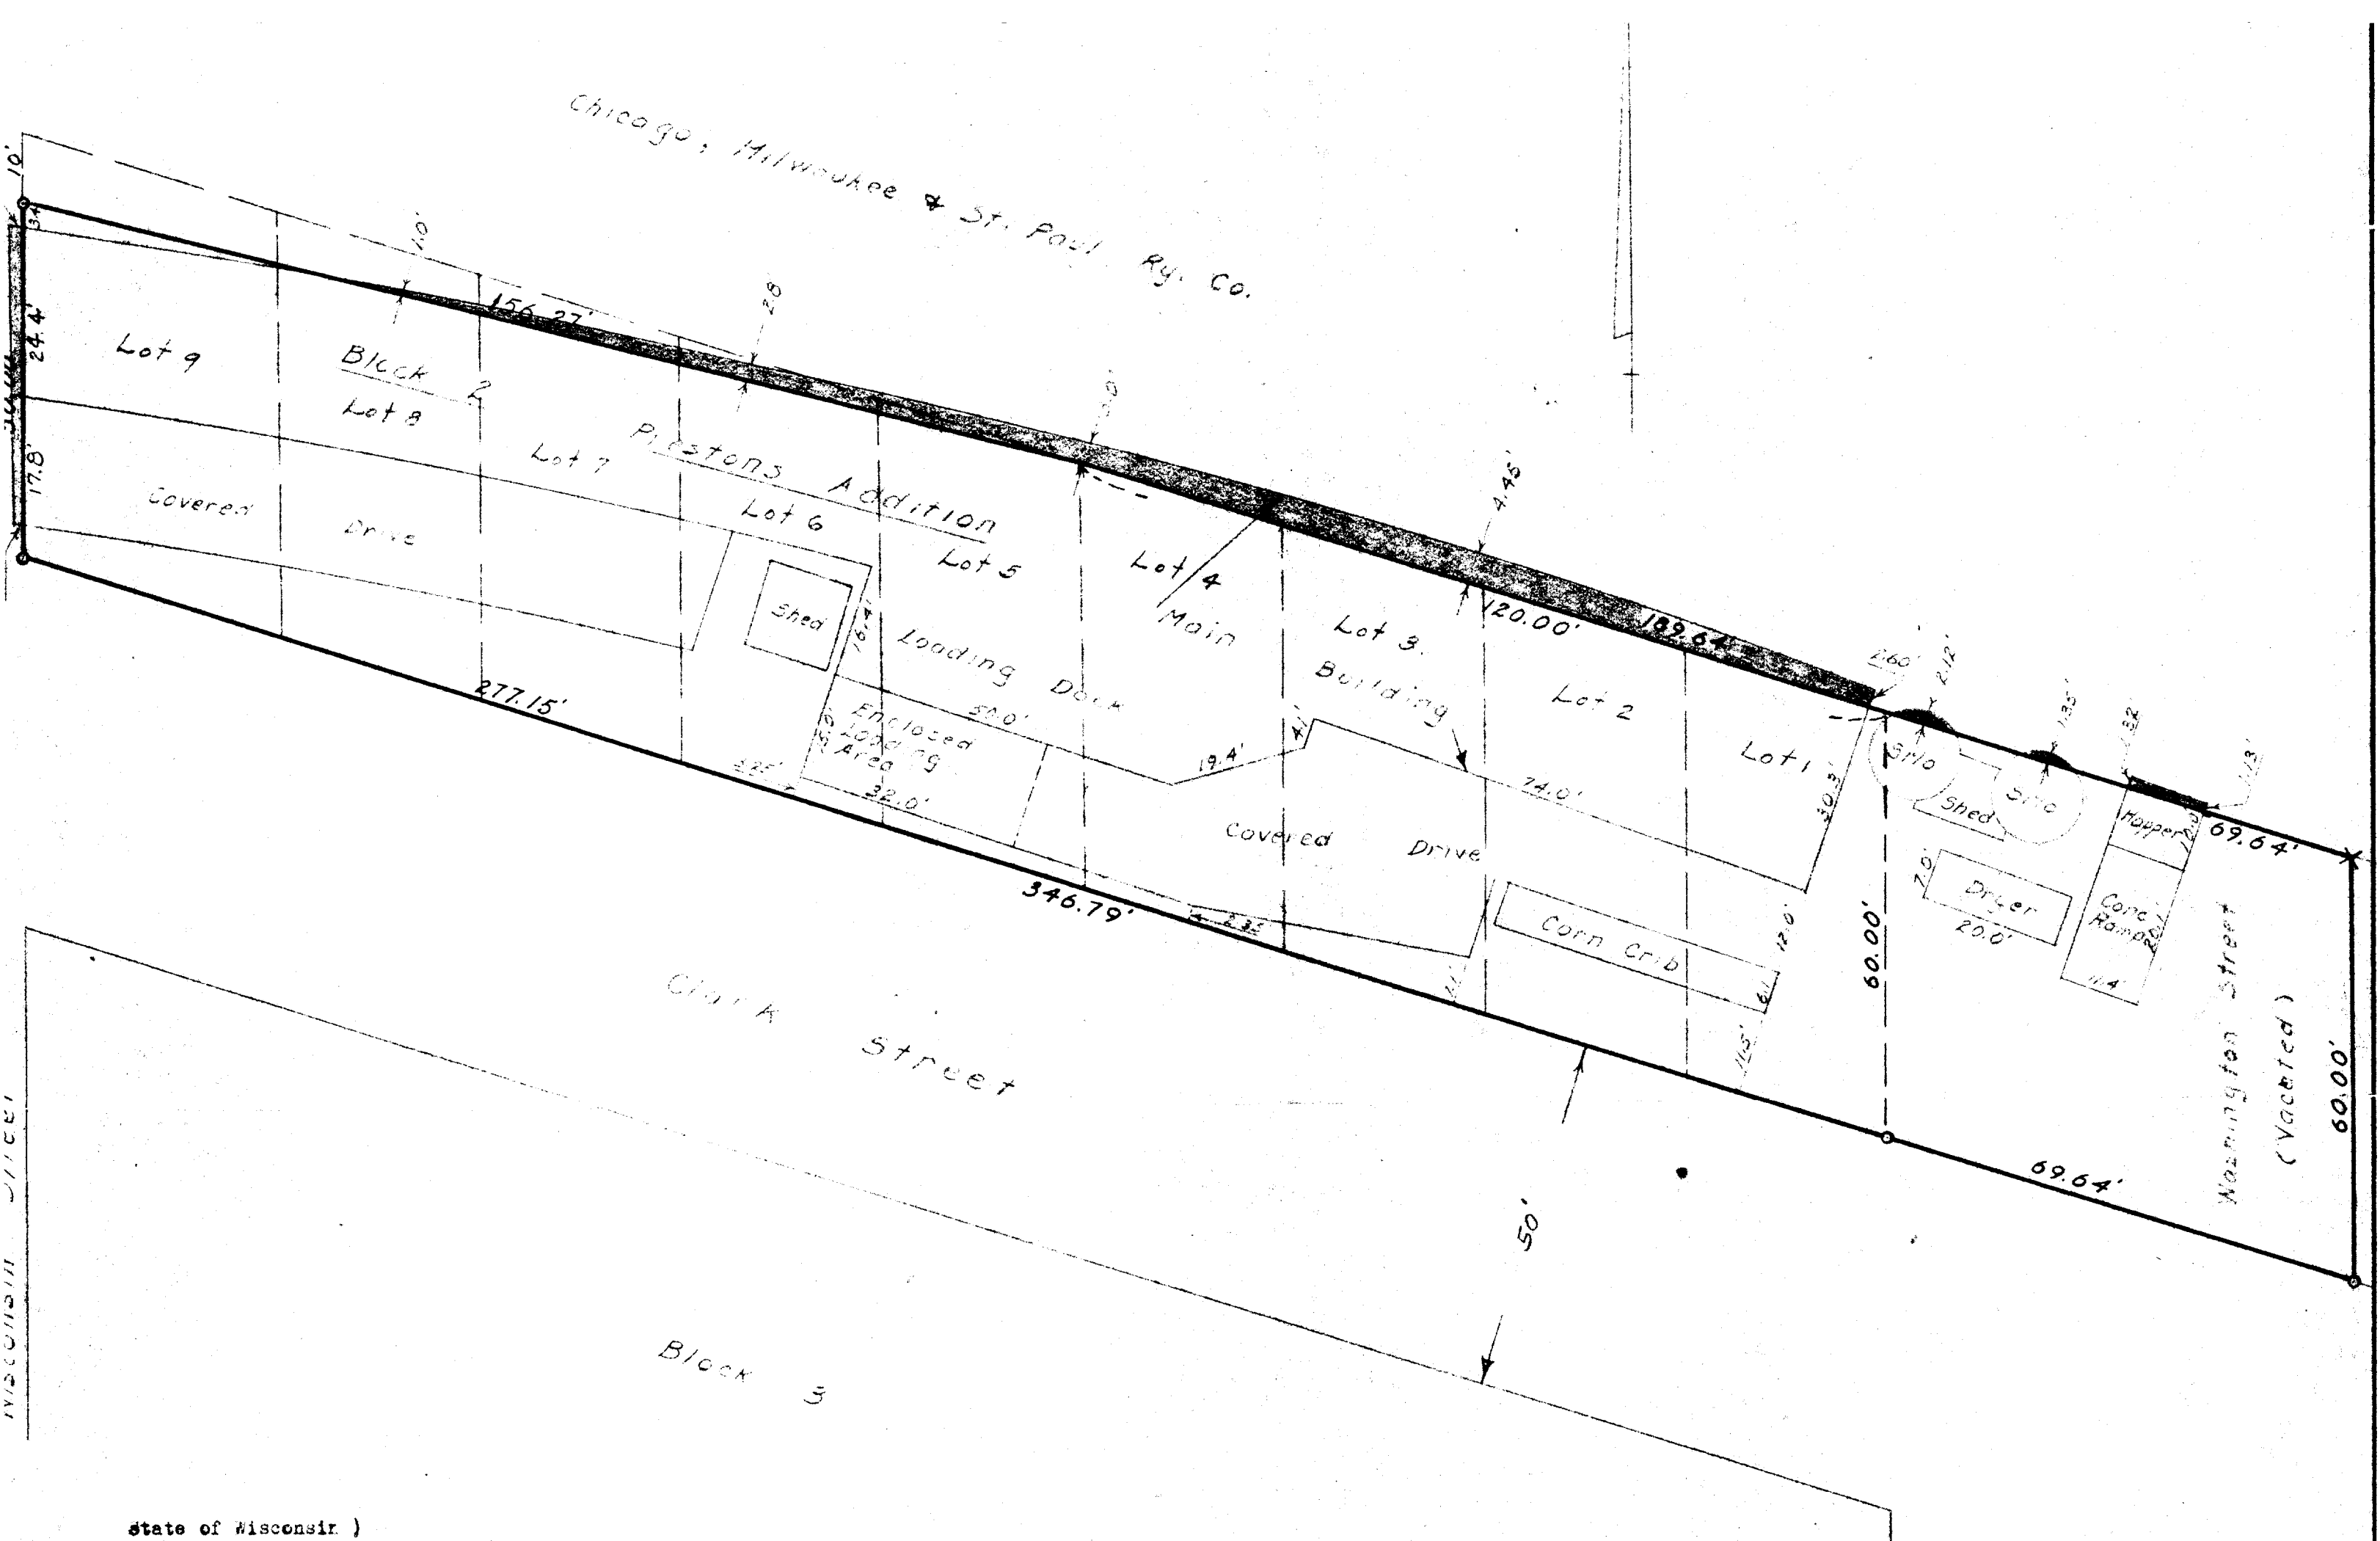

State of Wisconsin)

County of Walworth)

I, Lloyd L. Jensen, do hereby certify that I have surveyed the property hereon described according to the official records, and that the plat hereon is a correct representation of the lot lines and the principal lines of the buildings thereon.

Date March 14, 1961

Lloyd L. Jensen

(Lloyd L. Jensen) Wisconsin Registered Surveyor S-211

Legend
 o - Iron Pipe
 x - Cross cut in concrete
 - - Property Lines
 - - Building Lines
 - - Easement

PLAT OF SURVEY OF

Block 2, Prestons Addition and part
of Washington Street (Vacated), City of
Elkhorn, Walworth County, Wisconsin.

Lloyd L. Jensen
SURVEYOR

SCALE 1" = 20'

DATE March, 1961