


PLAT OF SURVEY

OF

THE NORTH 73 FEET OF LOT 1 OF BLOCK 32
OF THE ORIGINAL PLAT OF THE CITY OF
ELKHORN, WALWORTH COUNTY, WISCONSIN

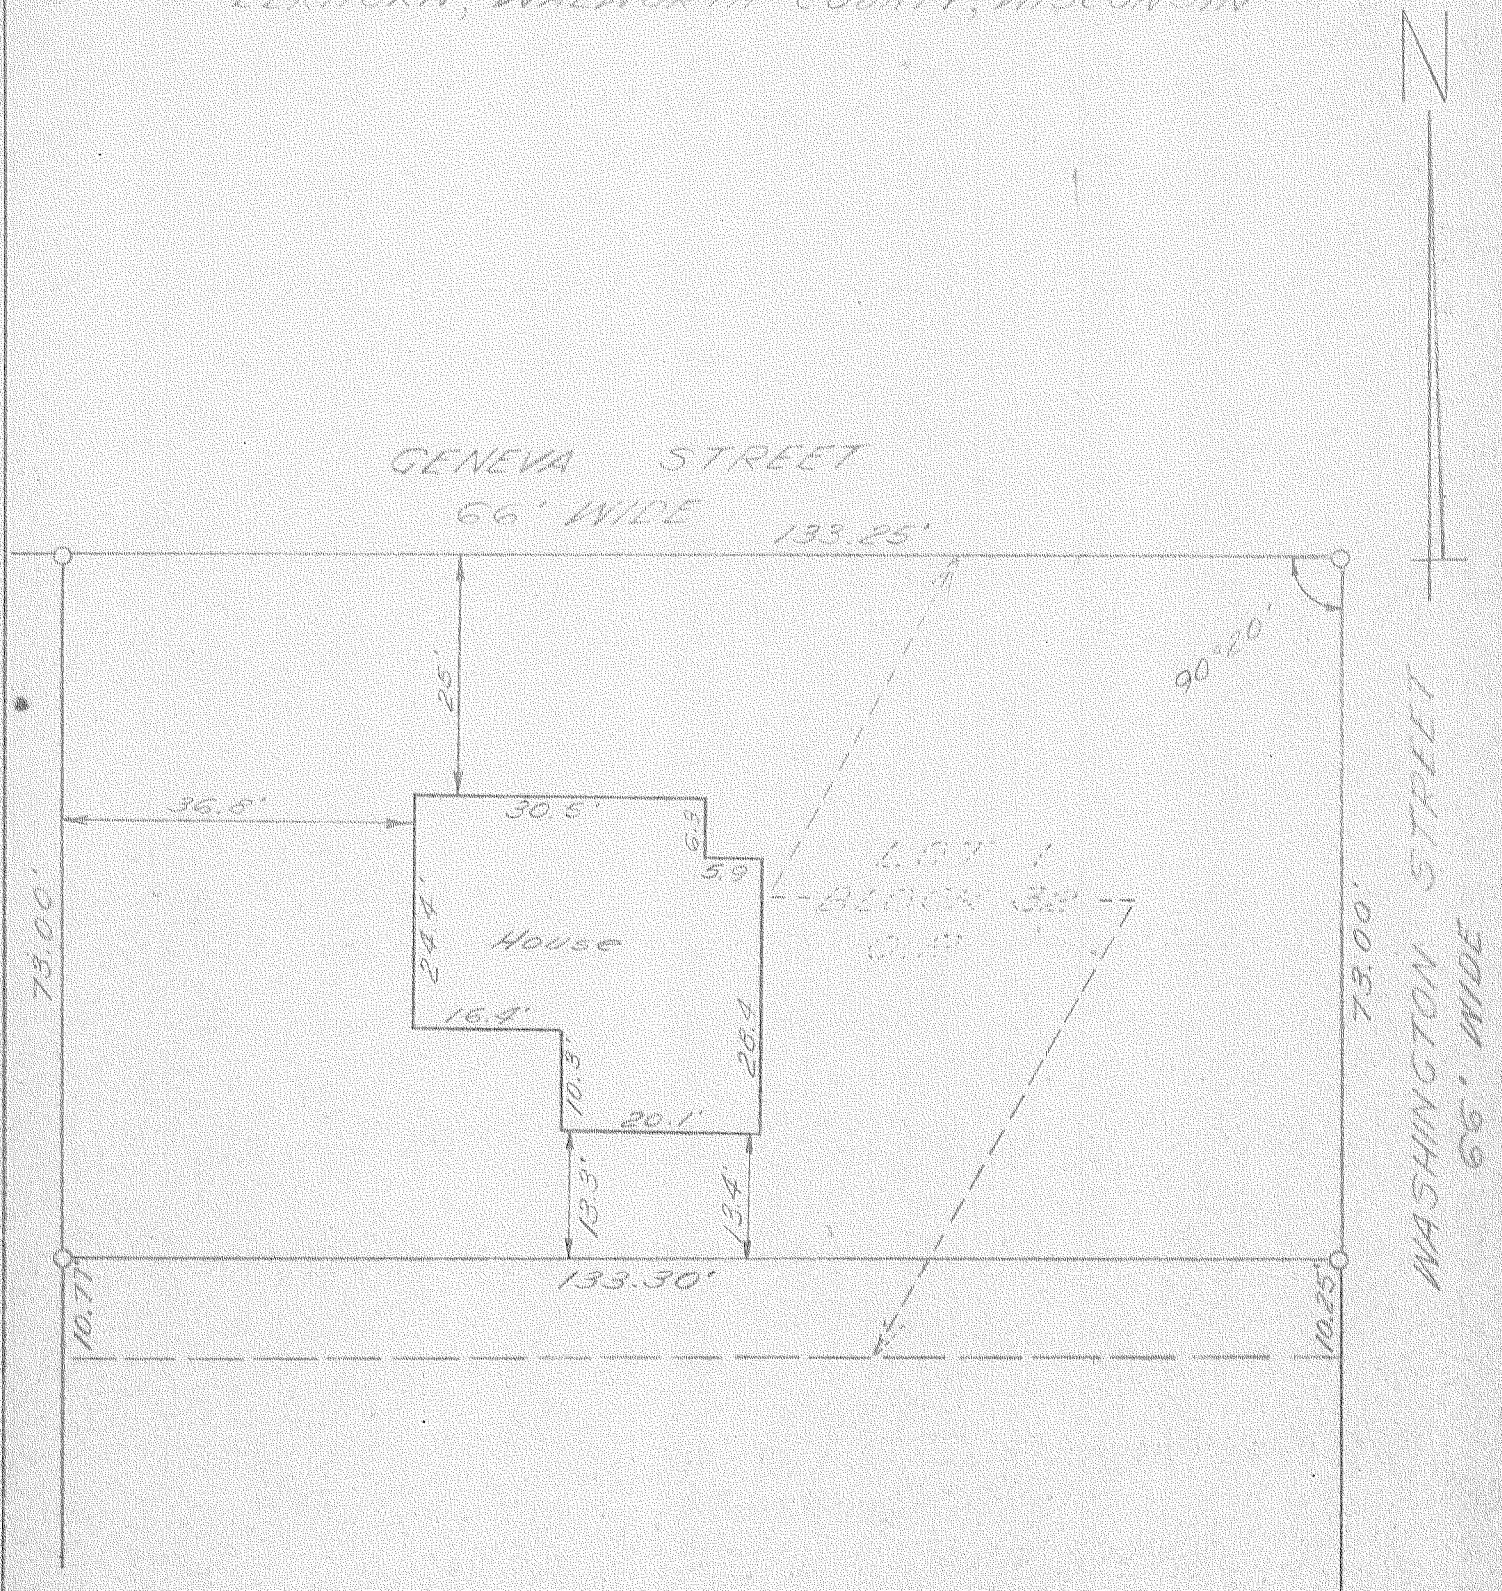

SURVEY AND PLAT BY

JENSEN & JOHNSON
CIVIL ENGINEERS AND SURVEYORS

Elkhorn, Wisconsin

LEGEND

- — Iron Pipe
- — Concrete Monument
- Scale 1" = 20'

WE CERTIFY: That we have surveyed the above described property and that the plat shown hereon is an accurate survey and a true representation thereof and correctly shows the exterior boundary lines and all divisions of said property.

Date AUGUST, 1962

Lloyd L. Jensen
LLOYD L. JENSEN, Partner

Wisconsin Registered Land Surveyor, No. S-211

YOR 269