


**ABELL
SURVEYING & MAPPING
DELAVER, WISCONSIN 53115
414-720-0737**

HARTWELL STREET

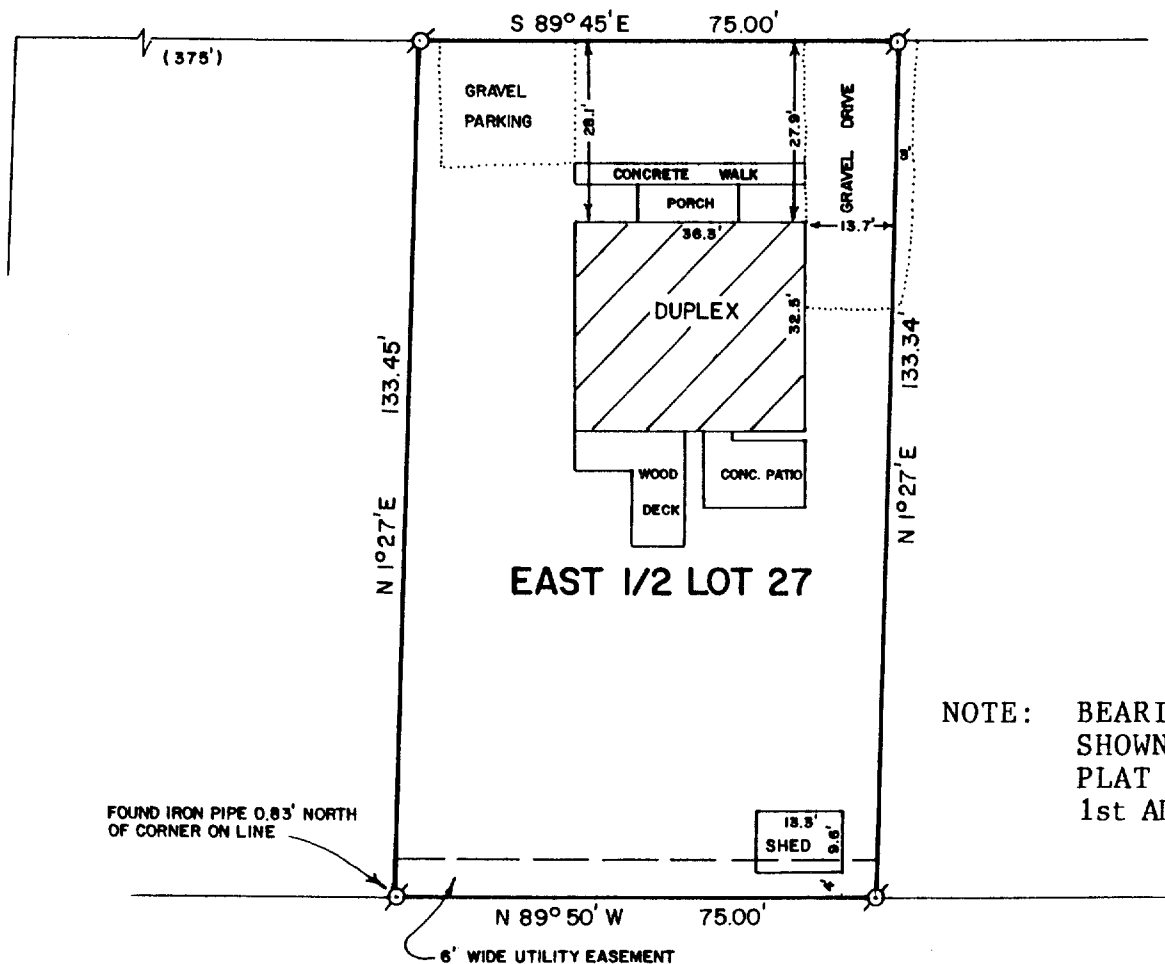


NOTE: BEARINGS ARE AS
SHOWN ON SUBDIVISION
PLAT OF HARMONY ACRES
1st ADDITION.

PLAT OF SURVEY OF

THE EAST 1/2 OF LOT 27 OF HARMONY ACRES SUBDIVISION
1st ADDITION, LOCATED IN THE CITY OF ELKHORN,
WALWORTH COUNTY, WISCONSIN.

ORDERED BY: ANCHOR SAVINGS & LOAN
201 BROAD STREET
LAKE GENEVA, WI. 53147

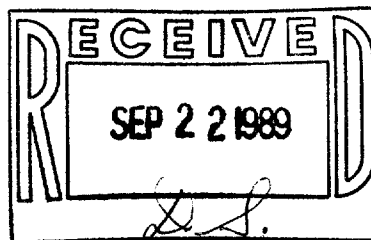

SCALE - 1"=30'

LEGEND

Ø - IRON PIPE FOUND

I HEREBY CERTIFY THAT I HAVE SURVEYED THE ABOVE DESCRIBED PROPERTY AND THAT THE ABOVE MAP IS A TRUE REPRESENTATION THEREOF AND SHOWS THE SIZE AND LOCATION OF THE PROPERTY, ITS EXTERIOR BOUNDARIES, THE LOCATION OF ALL VISIBLE STRUCTURES AND DIMENSIONS OF ALL PRINCIPAL BUILDINGS THEREON, BOUNDARY FENCES, APPARENT EASEMENTS, ROADWAYS AND VISIBLE ENCROACHMENTS, IF ANY, TO THE BEST OF MY KNOWLEDGE AND BELIEF.

THIS SURVEY IS MADE FOR THE USE OF THE PRESENT OWNERS OF THE PROPERTY, AND ALSO THOSE WHO PURCHASE, MORTGAGE, OR GUARANTEE THE TITLE THERETO WITHIN ONE (1) YEAR FROM DATE HEREOF.

David F. Abell
DAVID F. ABELL
WISCONSIN REGISTERED LAND SURVEYOR, S-1596

DATE *August 30, 1989* JOB NUMBER - 89184
NOTE: THIS IS NOT A CERTIFIED COPY UNLESS SEALED.

YHAI-15

2- ELKHORN

4-557