


ABELL
SURVEYING & MAPPING
 DELAVAN, WISCONSIN 53115
 414-728-8787

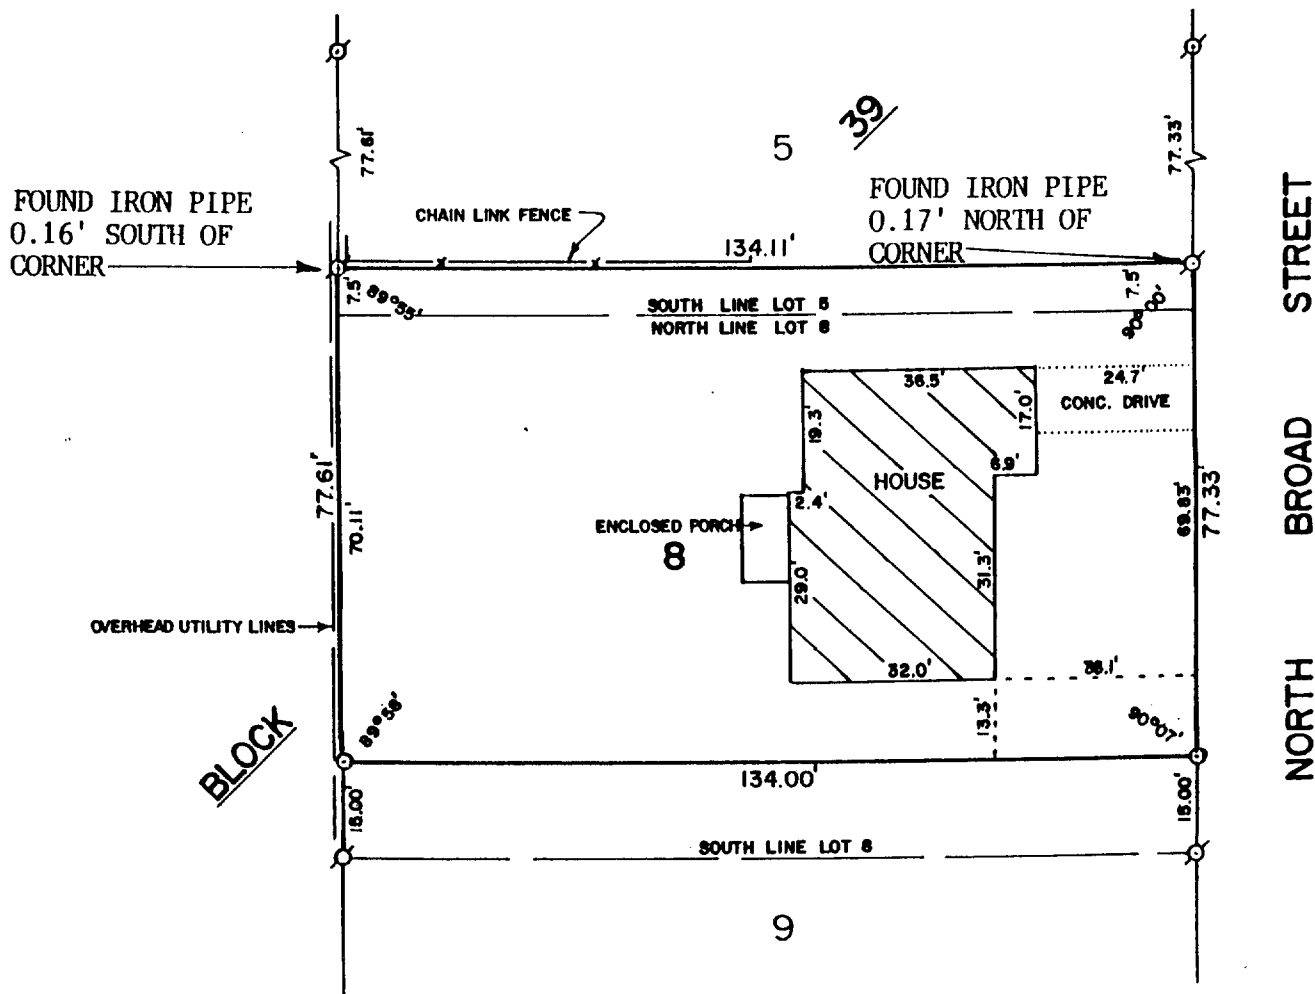


PLAT OF SURVEY OF

The South 1/2 of Lots 5 and 8 excepting the South 15 feet of said Lot 8, Block 39 of the Original Plat of Davis Addition to the Village (now City) of Elkhorn, Wisconsin, the tract of land hereby conveyed being the South 7 1/2 feet of Lot 5 along the entire length thereof and Lot 8 excepting from said Lot 8 the South 15 feet along the entire length thereof.

Tax Key Number: YD 00029A

ORDERED BY: COLONY REALTY
 16 E. WALWORTH ST.
 ELKHORN, WI. 53121

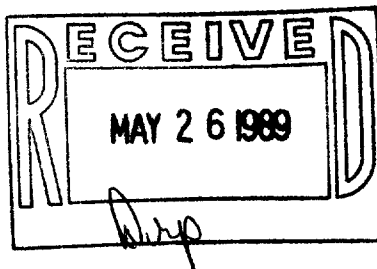

SCALE - 1"=30'

LEGEND

- ⊗ - IRON PIPE FOUND
- - IRON PIPE SET

I HEREBY CERTIFY THAT I HAVE SURVEYED THE ABOVE DESCRIBED PROPERTY AND THAT THE ABOVE MAP IS A TRUE REPRESENTATION THEREOF AND SHOWS THE SIZE AND LOCATION OF THE PROPERTY, ITS EXTERIOR BOUNDARIES, THE LOCATION OF ALL VISIBLE STRUCTURES AND DIMENSIONS OF ALL PRINCIPAL BUILDINGS THEREON, BOUNDARY FENCES, APPARENT EASEMENTS, ROADWAYS AND VISIBLE ENCROACHMENTS, IF ANY, TO THE BEST OF MY KNOWLEDGE AND BELIEF.

THIS SURVEY IS MADE FOR THE USE OF THE PRESENT OWNERS OF THE PROPERTY, AND ALSO THOSE WHO PURCHASE, MORTGAGE, OR GUARANTEE THE TITLE THERETO WITHIN ONE (1) YEAR FROM DATE HEREOF.

David F. Abell
 DAVID F. ABELL
 WISCONSIN REGISTERED LAND SURVEYOR, S-1596

DATE April 1, 1989 REVISED: APRIL 17, 1989
 JOB NUMBER - 89033
 NOTE: THIS IS NOT A CERTIFIED COPY UNLESS SEALED.