


46-13

5 WEIGHT 5

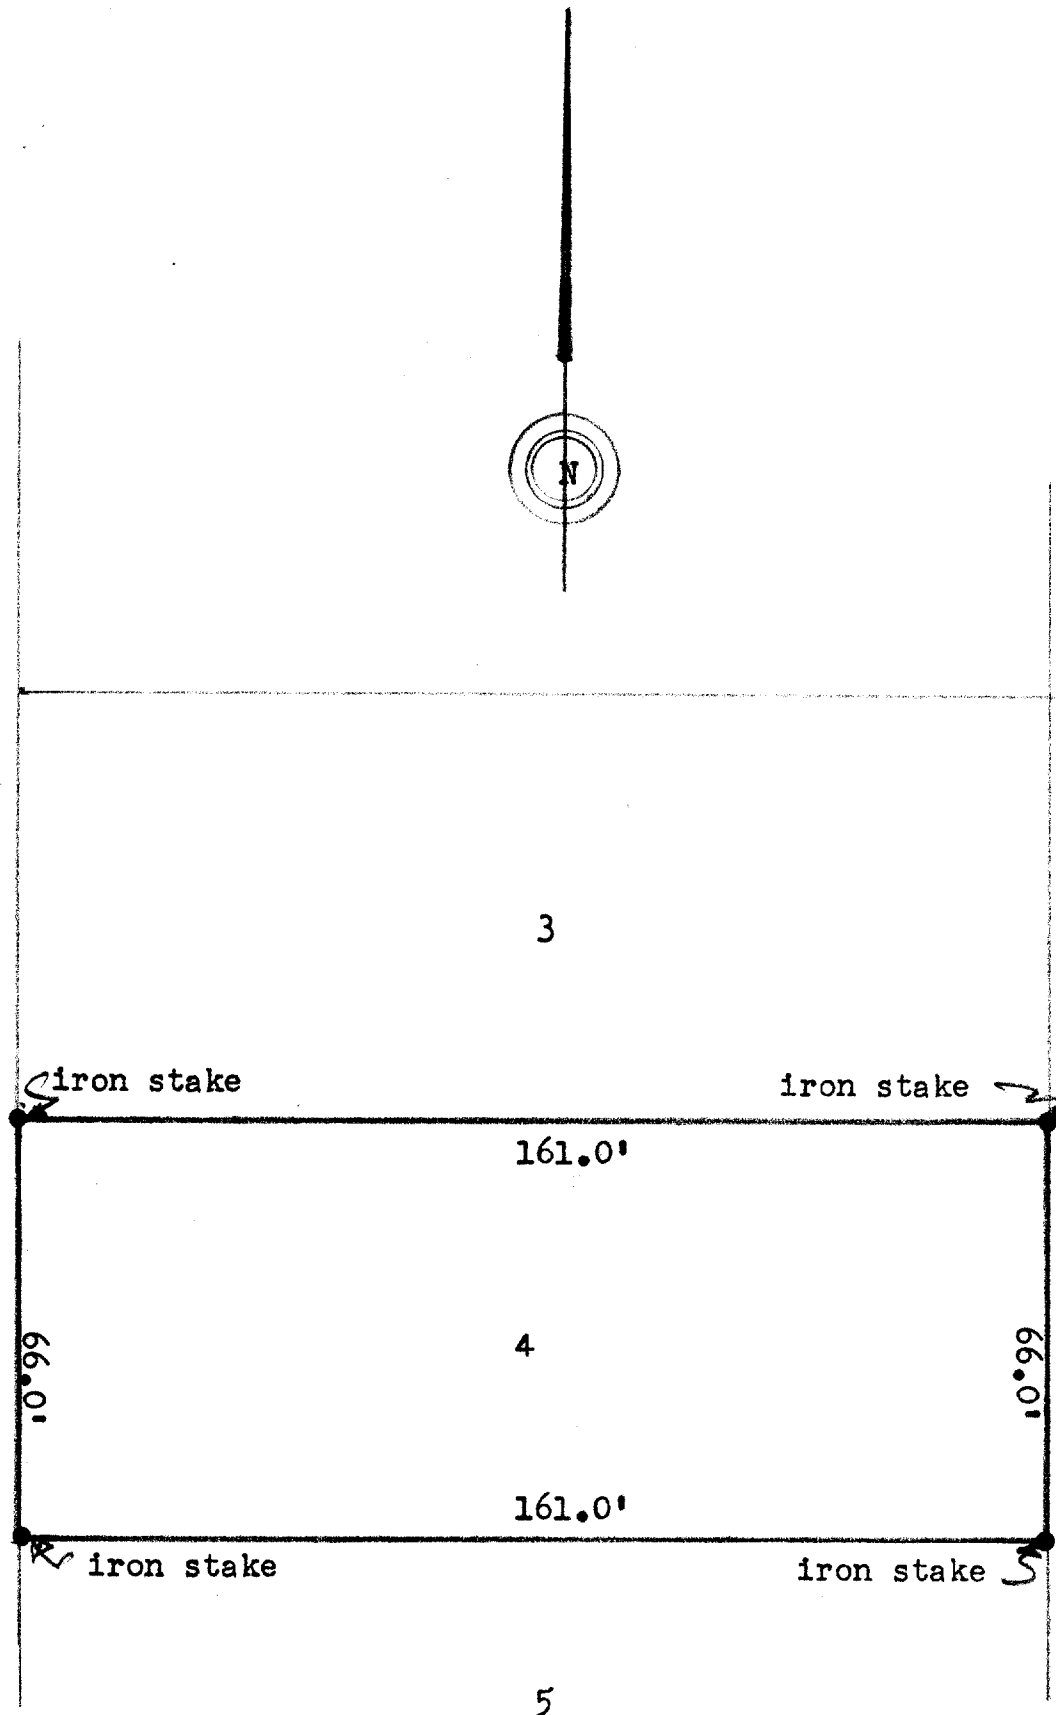

DESCRIPTION: Lot 4, Block 9, Elderkins Addition to the City of Elkhorn Walworth County, Wisconsin.

CERTIFICATE: I, hereby certify that I have on this the 10th day of August 1946, surveyed the above described property.  
SIGNED AND SEALED THIS 13TH DAY OF AUGUST 1946.

*Joseph M. Biagi*  
Joseph M. Biagi.  
Professional Enginssr.  
Elkhorn Wisconsin.

YEk-54

4-58 A