Copyright © 1991 by Jensen Surveying & Mapping S.C.


All rights reserved. No part of this survey plat may be reproduced or transmitted in any form

by any means - graphic, electronic, or mechanical, including photocopying, tracing, or information storage and retrieval systems - without permission in writing from Thomas P.A. Jensen.

A parcel of land being a part of Lots 1 and 2 in Block 11 of the Original Plat to the Tax Parcel No: YOP 00064A City of Elkhorn, Walworth County, Wisconsin, described as follows, to-wit: Commencing at a point in the West line of Lincoln Street, 83.63 feet South of the NE corner of Block 11 of the Original Plat, thence West 121.92 feet, thence South 84.61 feet, thence East 123.48 feet to a point in the West line of Lincoln Street, thence North in the West line of Lincoln Street 83.62 feet to the place of beginning.

Surveyed for: MRS. FRED YANKE 216 N. LINCOLN ST. ELKHORN, WI 53121

BEARINGS REFERENCED TO THE WEST LINE OF NORTH LINCOLN ST. ASSUMED AS NORTH

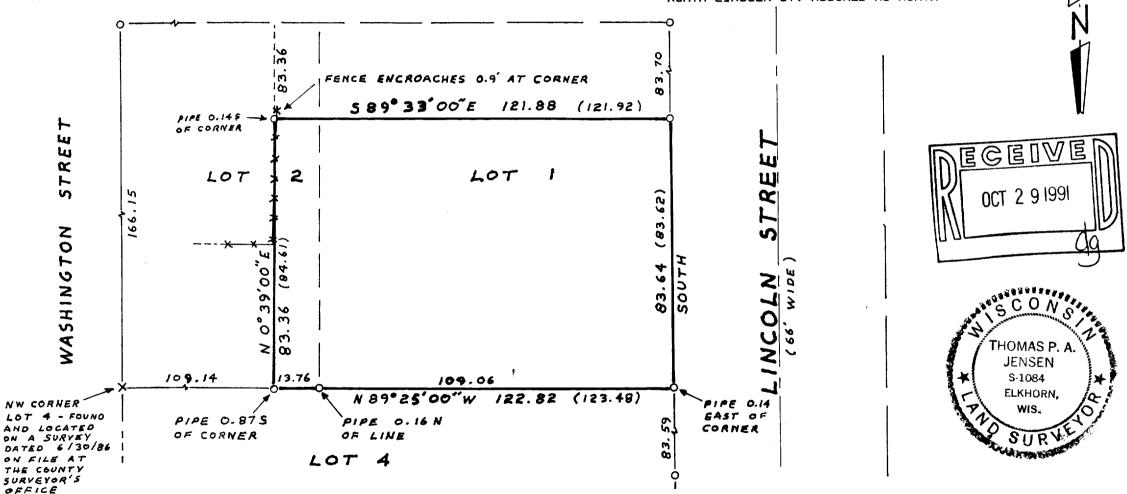

I. Thomas P.A. Jensen, Wisconsin Registered Land Surveyor, do hereby certify that this survey was performed by me, or under my direction, in full compliance with the owner's/agent's instructions and Chapter A-E 7 of the Wisconsin Administrative Code ' Minimum Standards For Property Surveys ', and that this map is an accurate representation thereof to the best of my knowledge and belief.

Note: This survey plat is not certified unless signed and sealed in red ink.

Thomas P.A. Jensen R.L.S.

S Mapping P.0. S Surveying ch Wisconsin Elkhorn, Wis (414) 7 lensen

apping date: Revisions:

S

Sheets

41

of

Sheet

106

1991

AHO.

d iron pipe, 1^h di rded as dimension e - *BoARD* 0 ~