



PLAT OF SURVEY

of Lot 3 of EDGEWOOD ESTATES SUBDIVISION, in the City of Elkhorn according to the recorded plat thereof, Walworth County, Wisconsin.

AMBIT LAND SURVEYING
P.O. Box 42
Bassett, WI. 53101
414-537-4874

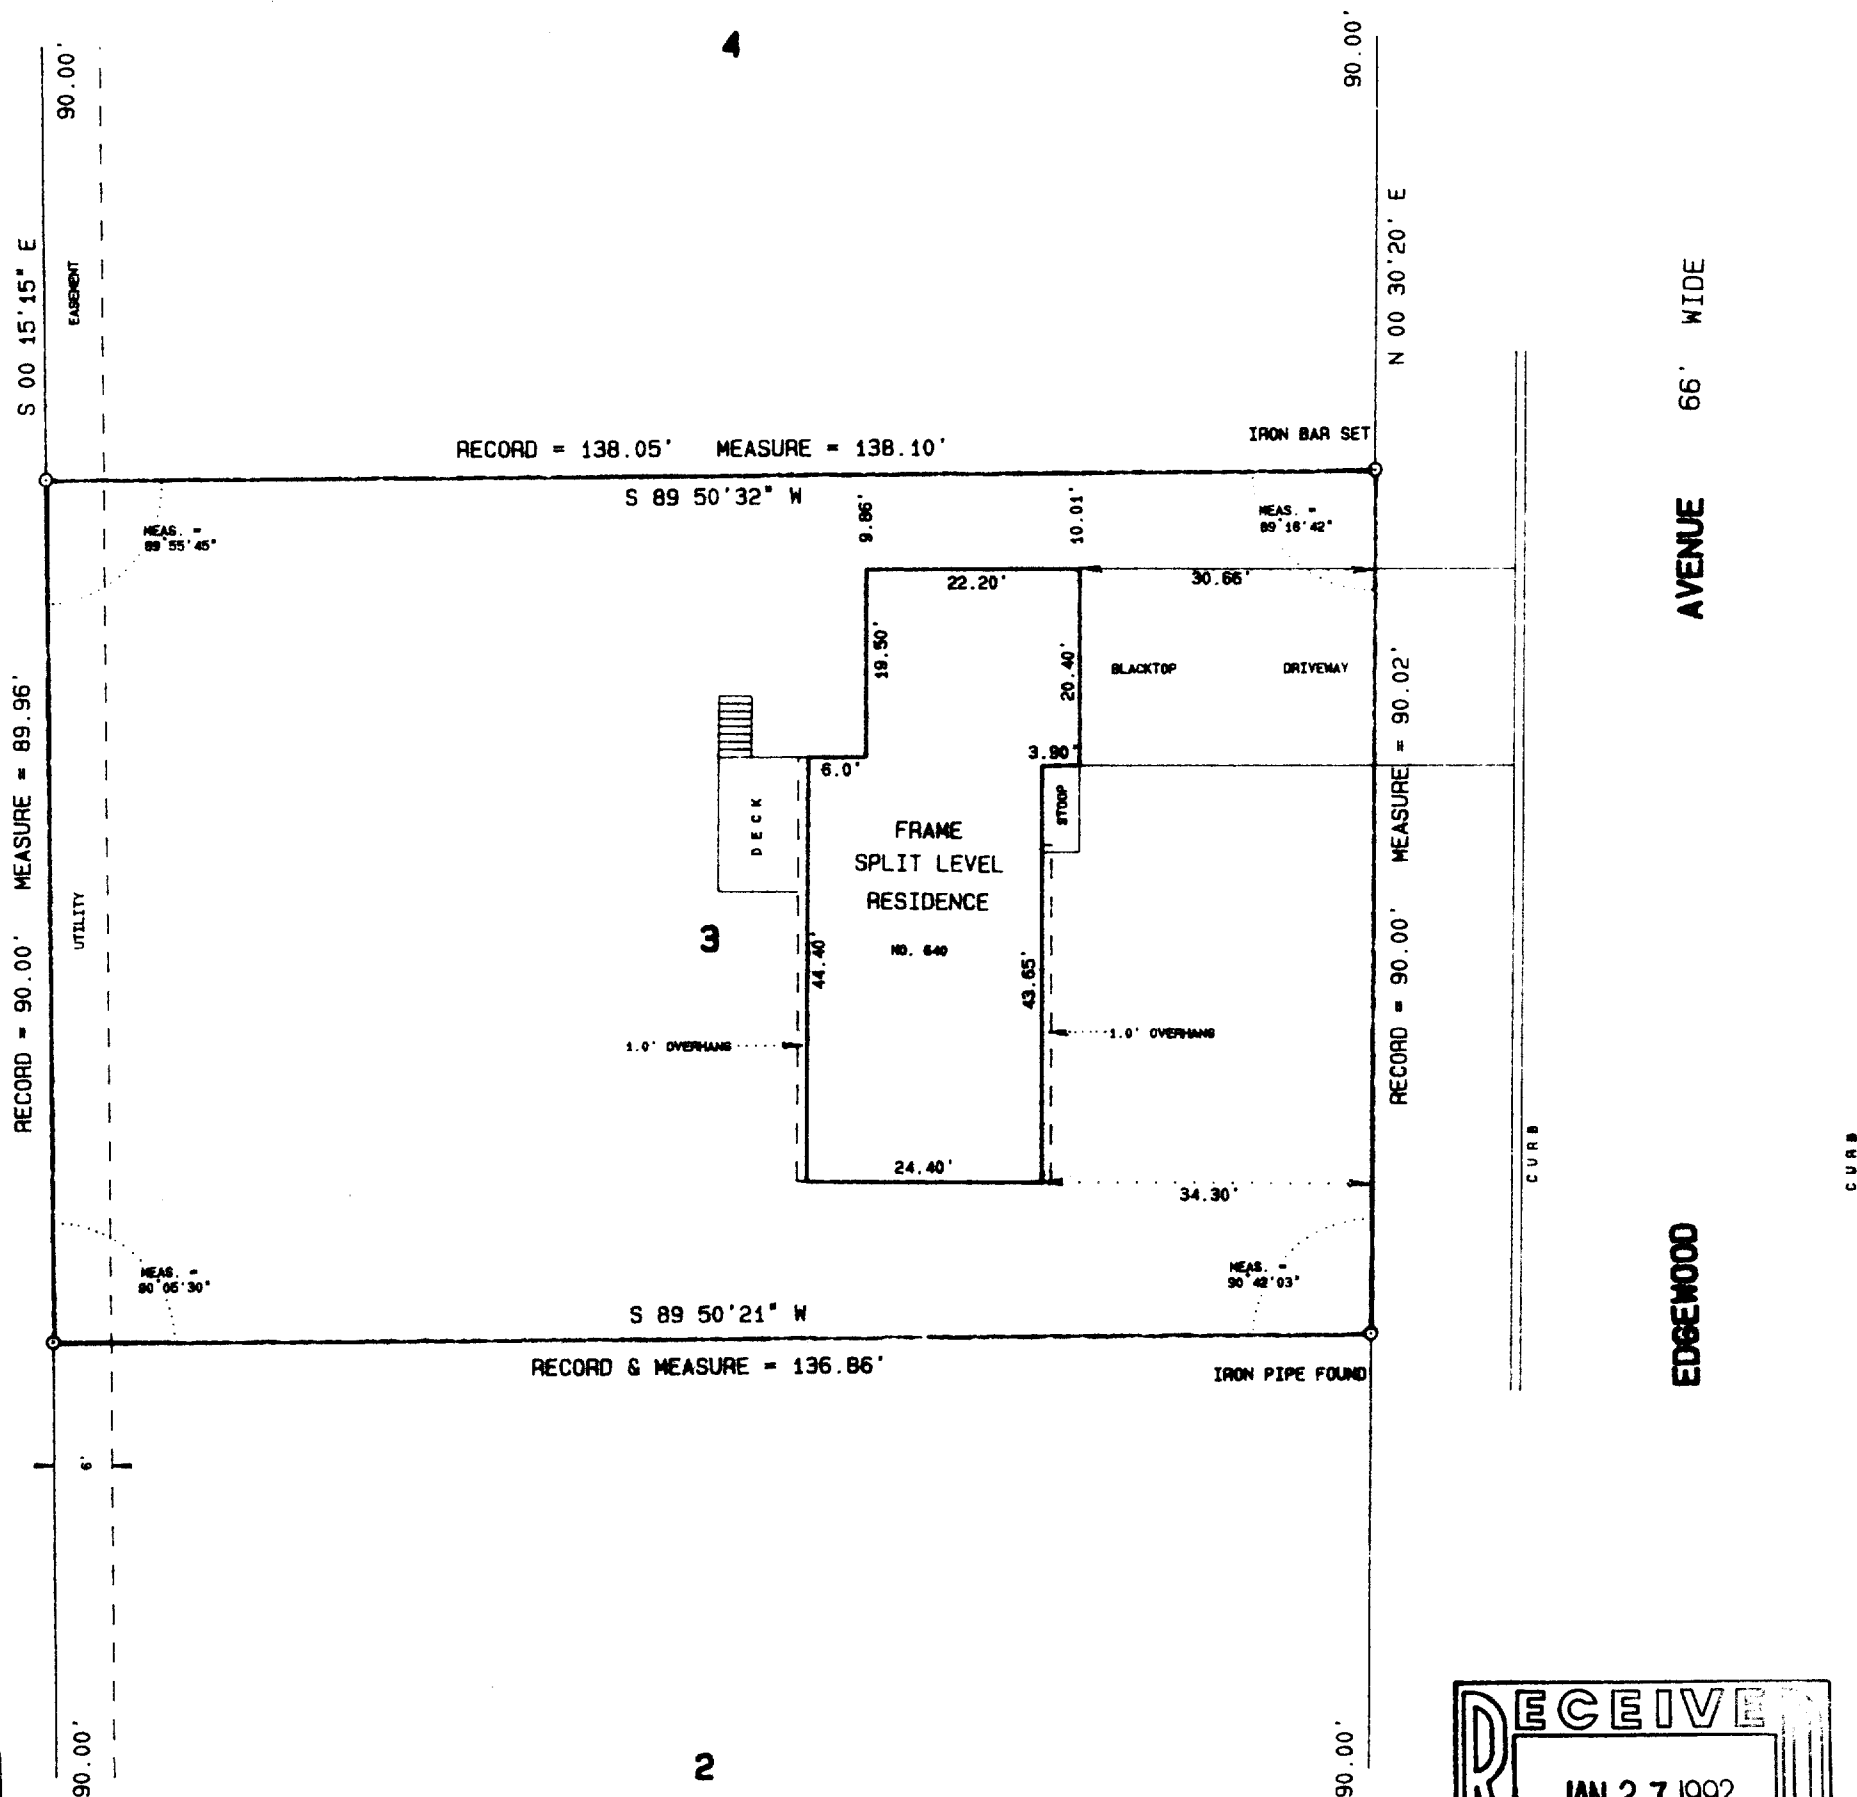

NOTE: Due to snow cover not all conc. walks are shown.

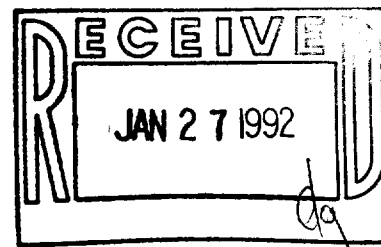

I hereby certify that I have surveyed the above described property and the above plat is a true representation thereof and shows the size and location of the property, its exterior boundaries, the location and dimensions of all visible structures thereon, boundary fences, apparent easements and roadways and visible encroachments, if any.

This survey is made for the exclusive use of the present owners of the property, and also those who purchase, mortgage, or guarantee the title thereto within one year from the date hereof.

Dated at Bassett, Wisconsin this 27th day of DECEMBER 1991.

Mark A. Bolender
Mark A. Bolender
Wisconsin Registered Land Surveyor S - 1784



SCALE 1" = 20'
ORDERED BY R. Fletcher
JOB NO. 91251

004-688

YDW 00003