


929 WILLIAMS STREET

LAKE GENEVA, WISCONSIN 53147

414-248-3697

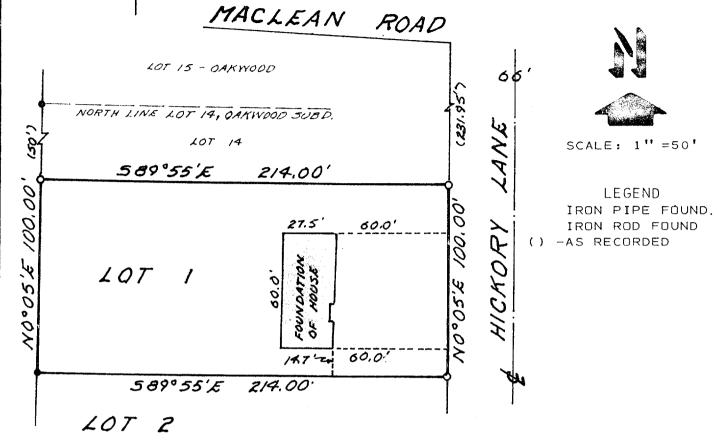


PLAT OF SURVEY OF LOCATION OF A FOUNDATION ON LOT 1 OF CERTIFIED SURVEY MAP NO. 1736, WHICH IS PART OF LOT 14, DAKWOOD SUBDIVIS-ION, LOCATED IN THE NORTHWEST 1/4 OF SECTION 8, T 2 N, R 17 E, CITY OF ELKHORN, WALWORTH COUNTY, WISCONSIN.

ORDERED BY: FIVE STAR HOMES 90 E. GENEVA SQUARE LAKE GENEVA, WI. 53147 NOTE: BEARINGS ARE ASSUMED AS SHOWN ON CERTIFIED SURVEY MAP NO. 1736.

THAT I HAVE SURVEYED THE PROPERTY HEREON DESCRIBED ACCORDING TO THE OFFICAL RECORDS, AND THAT THE PLAT HEREON IS A CORRECT REPRESENTATION OF THE LOT LINES AND THE PRINCIPAL LINES OF THE BUILDING FOUNDATION THEREON, TO THE BEST OF MY KNOWLEDGE AND BELIEF. NOTE: SURVEY IS NOT VALID UNLESS THE SURVEYOR'S SIGNATURE IS IN RED.

I, HAROLD H. KOLB, DO HEREBY CERTIFY

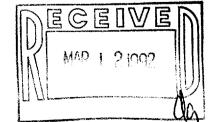

HAROLD	Η.	KOLB.	

WISCONSIN REGISTERED LAND SURVEYOR, S- 187 AUGUST 7, 1990

REVISED\_

REVISED\_