
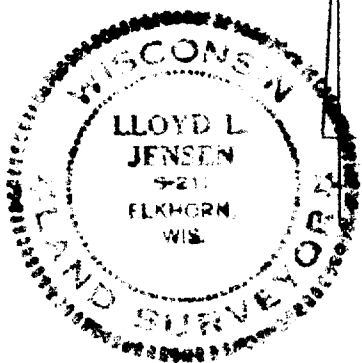


PLAT OF SURVEY OF

LOTS 3 & 4 BLOCK 18, ORIGINAL PLAT, CITY OF
ELKHORN, WALWORTH COUNTY, WISCONSIN

JEFFERSON ST.

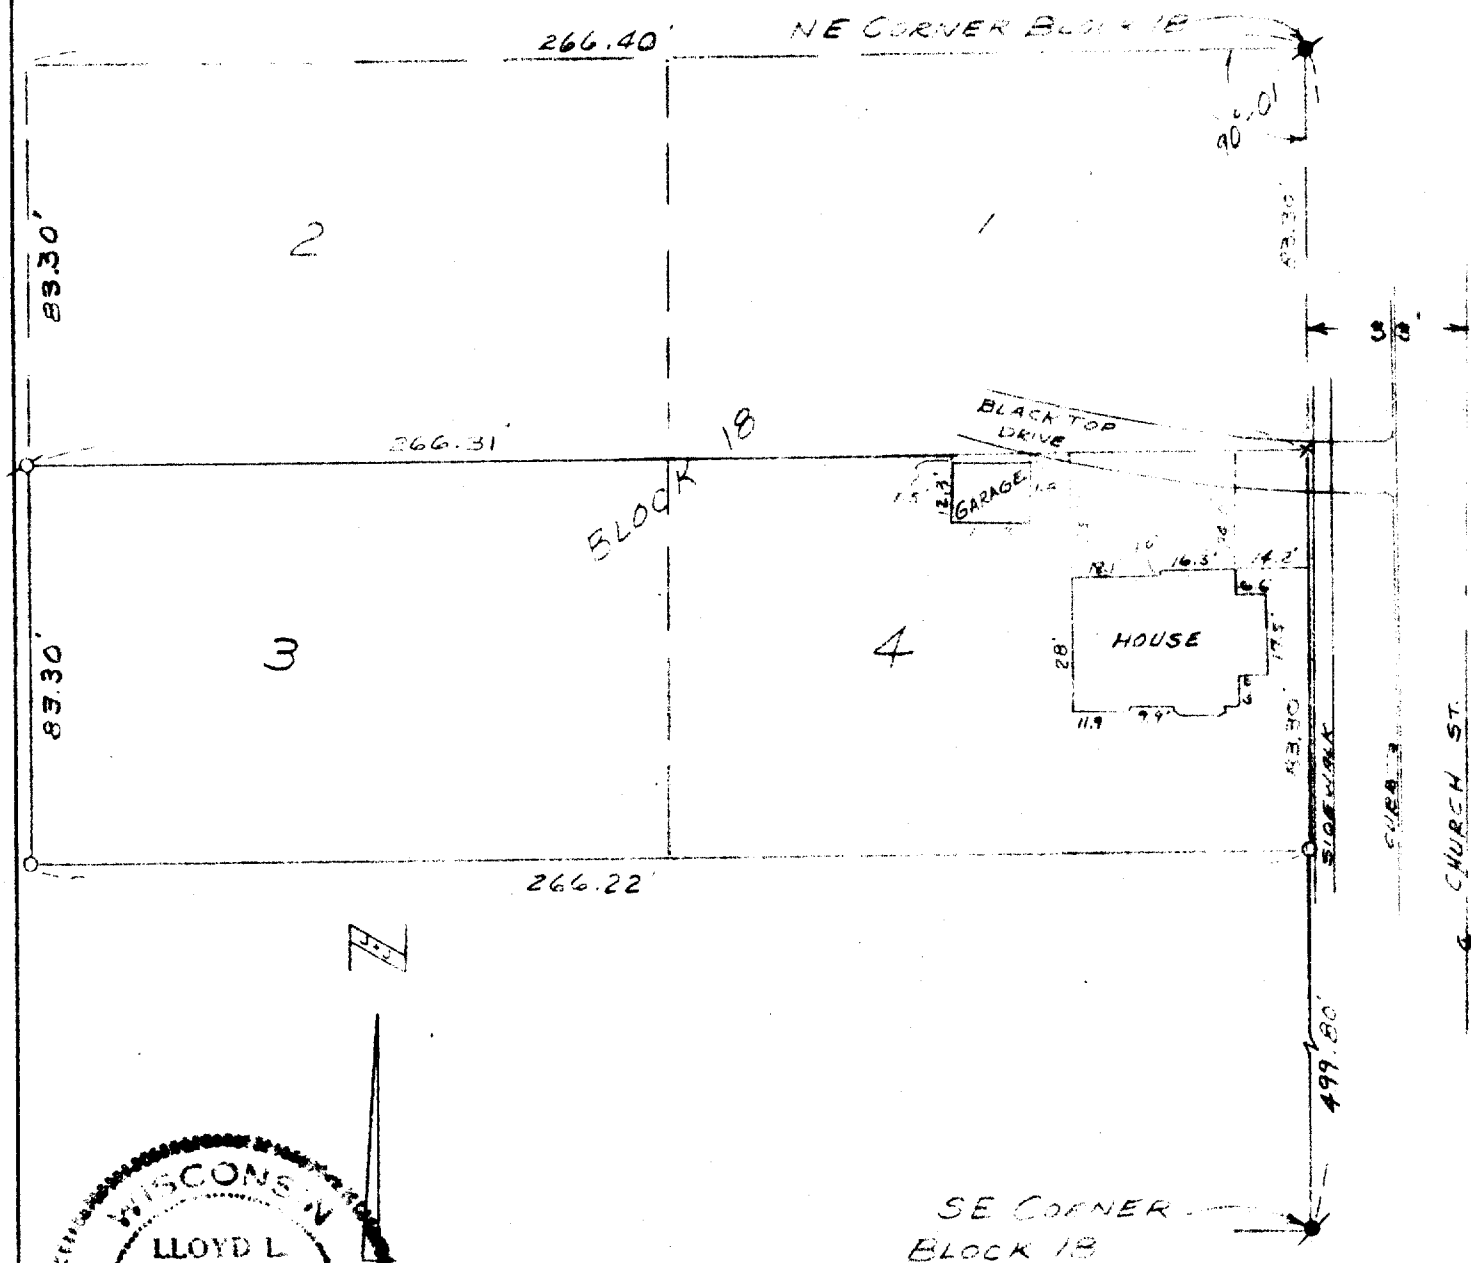

LEGEND

Ø—Iron Pipe FOUND

● — Concrete Monument

Scale 1" = 40'

♣ - IRON PINE FOUND

0 - IRON PIPE SET

X - PK NAIL SET

YOR 128

WE CERTIFY: That we have surveyed the above described property and that the plat shown hereon is an accurate survey and a true representation thereof and correctly shows the exterior boundary lines and all divisions of said property.

Date FEB 1968

LLOYD L. JENSEN,

Wisconsin Registered Land Surveyor, No. S