

ROBERTS & SONS, INC.
CONSULTING ENGINEERS & LAND SURVEYORS



PHONE (415) 761-2453

116 E. CHURCH ST.

BURLINGTON, WIS. 53105

PLAT OF SURVEY & HOUSE LOCATION

LANDS DESCRIBED IN VOLUME 647 PAGE 607 OF WARRANTY DEEDS,
 LOCATED IN THE CITY OF EUGEN, WALWORTH COUNTY
 WISCONSIN

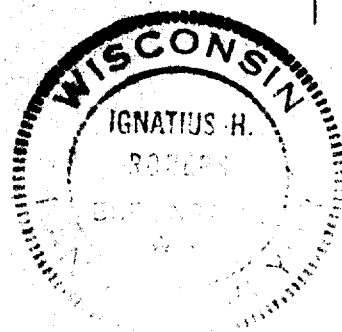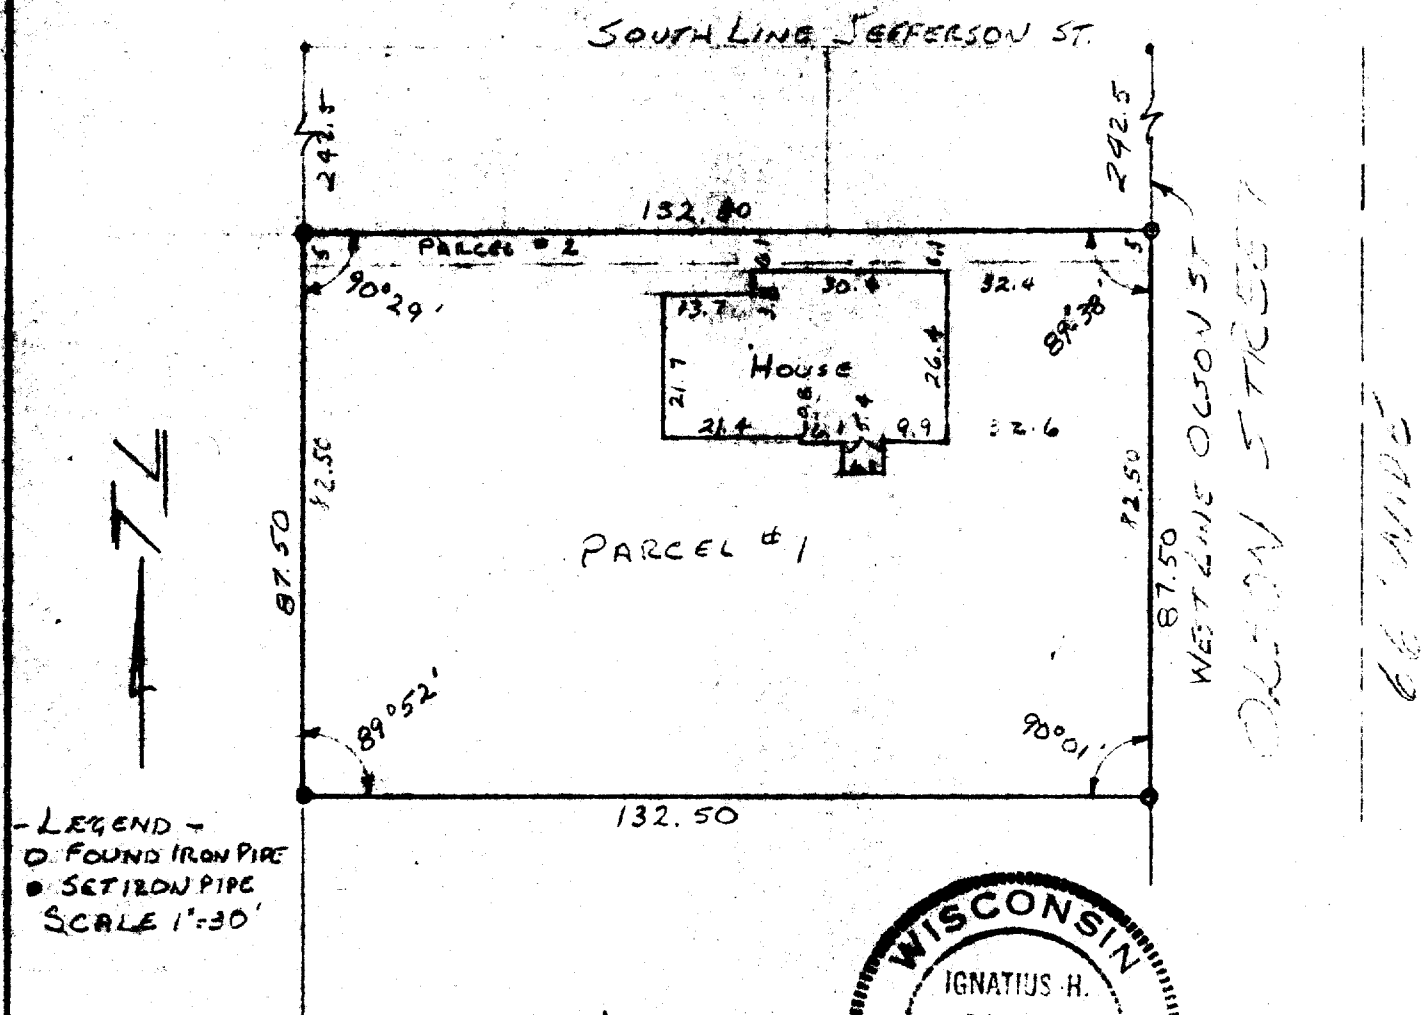

I HEREBY CERTIFY THAT WE HAVE SURVEYED THE LANDS DESCRIBED
 ABOVE ACCORDING TO OFFICIAL RECORDS AND THAT THE PLAT
 DRAWN HEREON IS A CORRECT REPRESENTATION OF SAID SURVEY.

WIS. REG. LAND SURVEYOR

DATE 3-26-75

JOB NO. 70-4-5

ROBERS & BOYD, INC.
CONSULTING ENGINEERS AND LAND SURVEYORS
116 E. CHESTNUT STREET
BURLINGTON, WISCONSIN 53105
PHONE 414-763-2692

DESCRIPTION FOR 73044-2


PARCEL 1

The South 1/2 of the following described piece of parcel of real estate, lying and being in the City of Elkhorn, Walworth County, Wisconsin. Beginning at a point on the west side of Olsen Street 10 rods south of the south line of Jefferson Street (Olsen Street being the street that runs north and south between Jefferson Street and Court Street) and along the 1/4 section line of Section 36 Town 3 North, Range 16 East, running thence west 8 rods, thence south parallel with said west line of Olsen Street 10 rods, thence east to said west line of Olsen Street 8 rods, thence north along the west line of Olsen Street 10 rods to place of beginning, containing 1/4 of an acre of land.

PARCEL 2

The South 5 feet of the following described premises located in the City of Elkhorn, Walworth County, Wisconsin, described as follows, to-wit: Beginning at a point on the west line of Olsen Street (formerly called Blanchard Street and being the street which runs north and south between Jefferson Street and Court Street) and being along the quarter section line of Section 36 Town 3 North, Range 16 East 10 rods south of the south line of Jefferson Street, running thence west 8 rods, thence south parallel with said west line of Olsen Street 5 rods, thence east to said west line of Olsen Street 8 rods, thence north along the west line of Olsen Street 5 rods to the place of beginning.

Lands described in Volume 647 page 607 and 608 of Warranty Deeds.

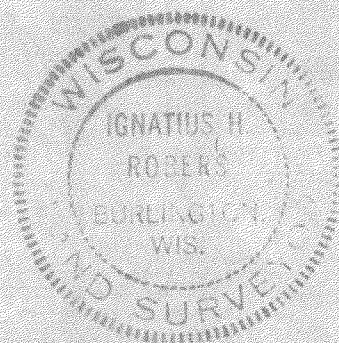

Ignatius H. Rober
Ignatius H. Rober
ROBERS & BOYD, INC.
March 26, 1973