
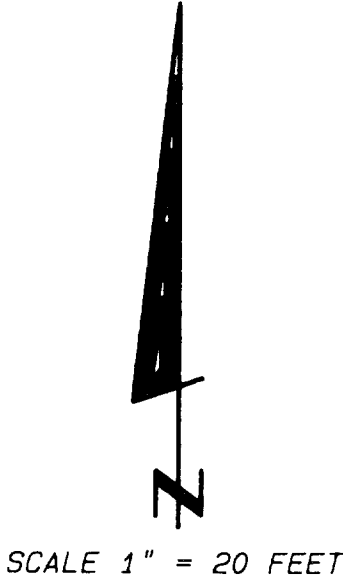



PLAT OF SURVEY

LOT 2 OF JAMES JONES
ADDITION, LOCATED IN THE
NW 1/4 OF THE NE 1/4 OF
SECTION 1, TOWN 2 NORTH,
RANGE 16 EAST, CITY OF
ELKHORN, WALWORTH COUNTY,
WISCONSIN.


ORDERED BY: JOE KYLE
208 W. ROCKWELL
ELKHORN, WI. 53121

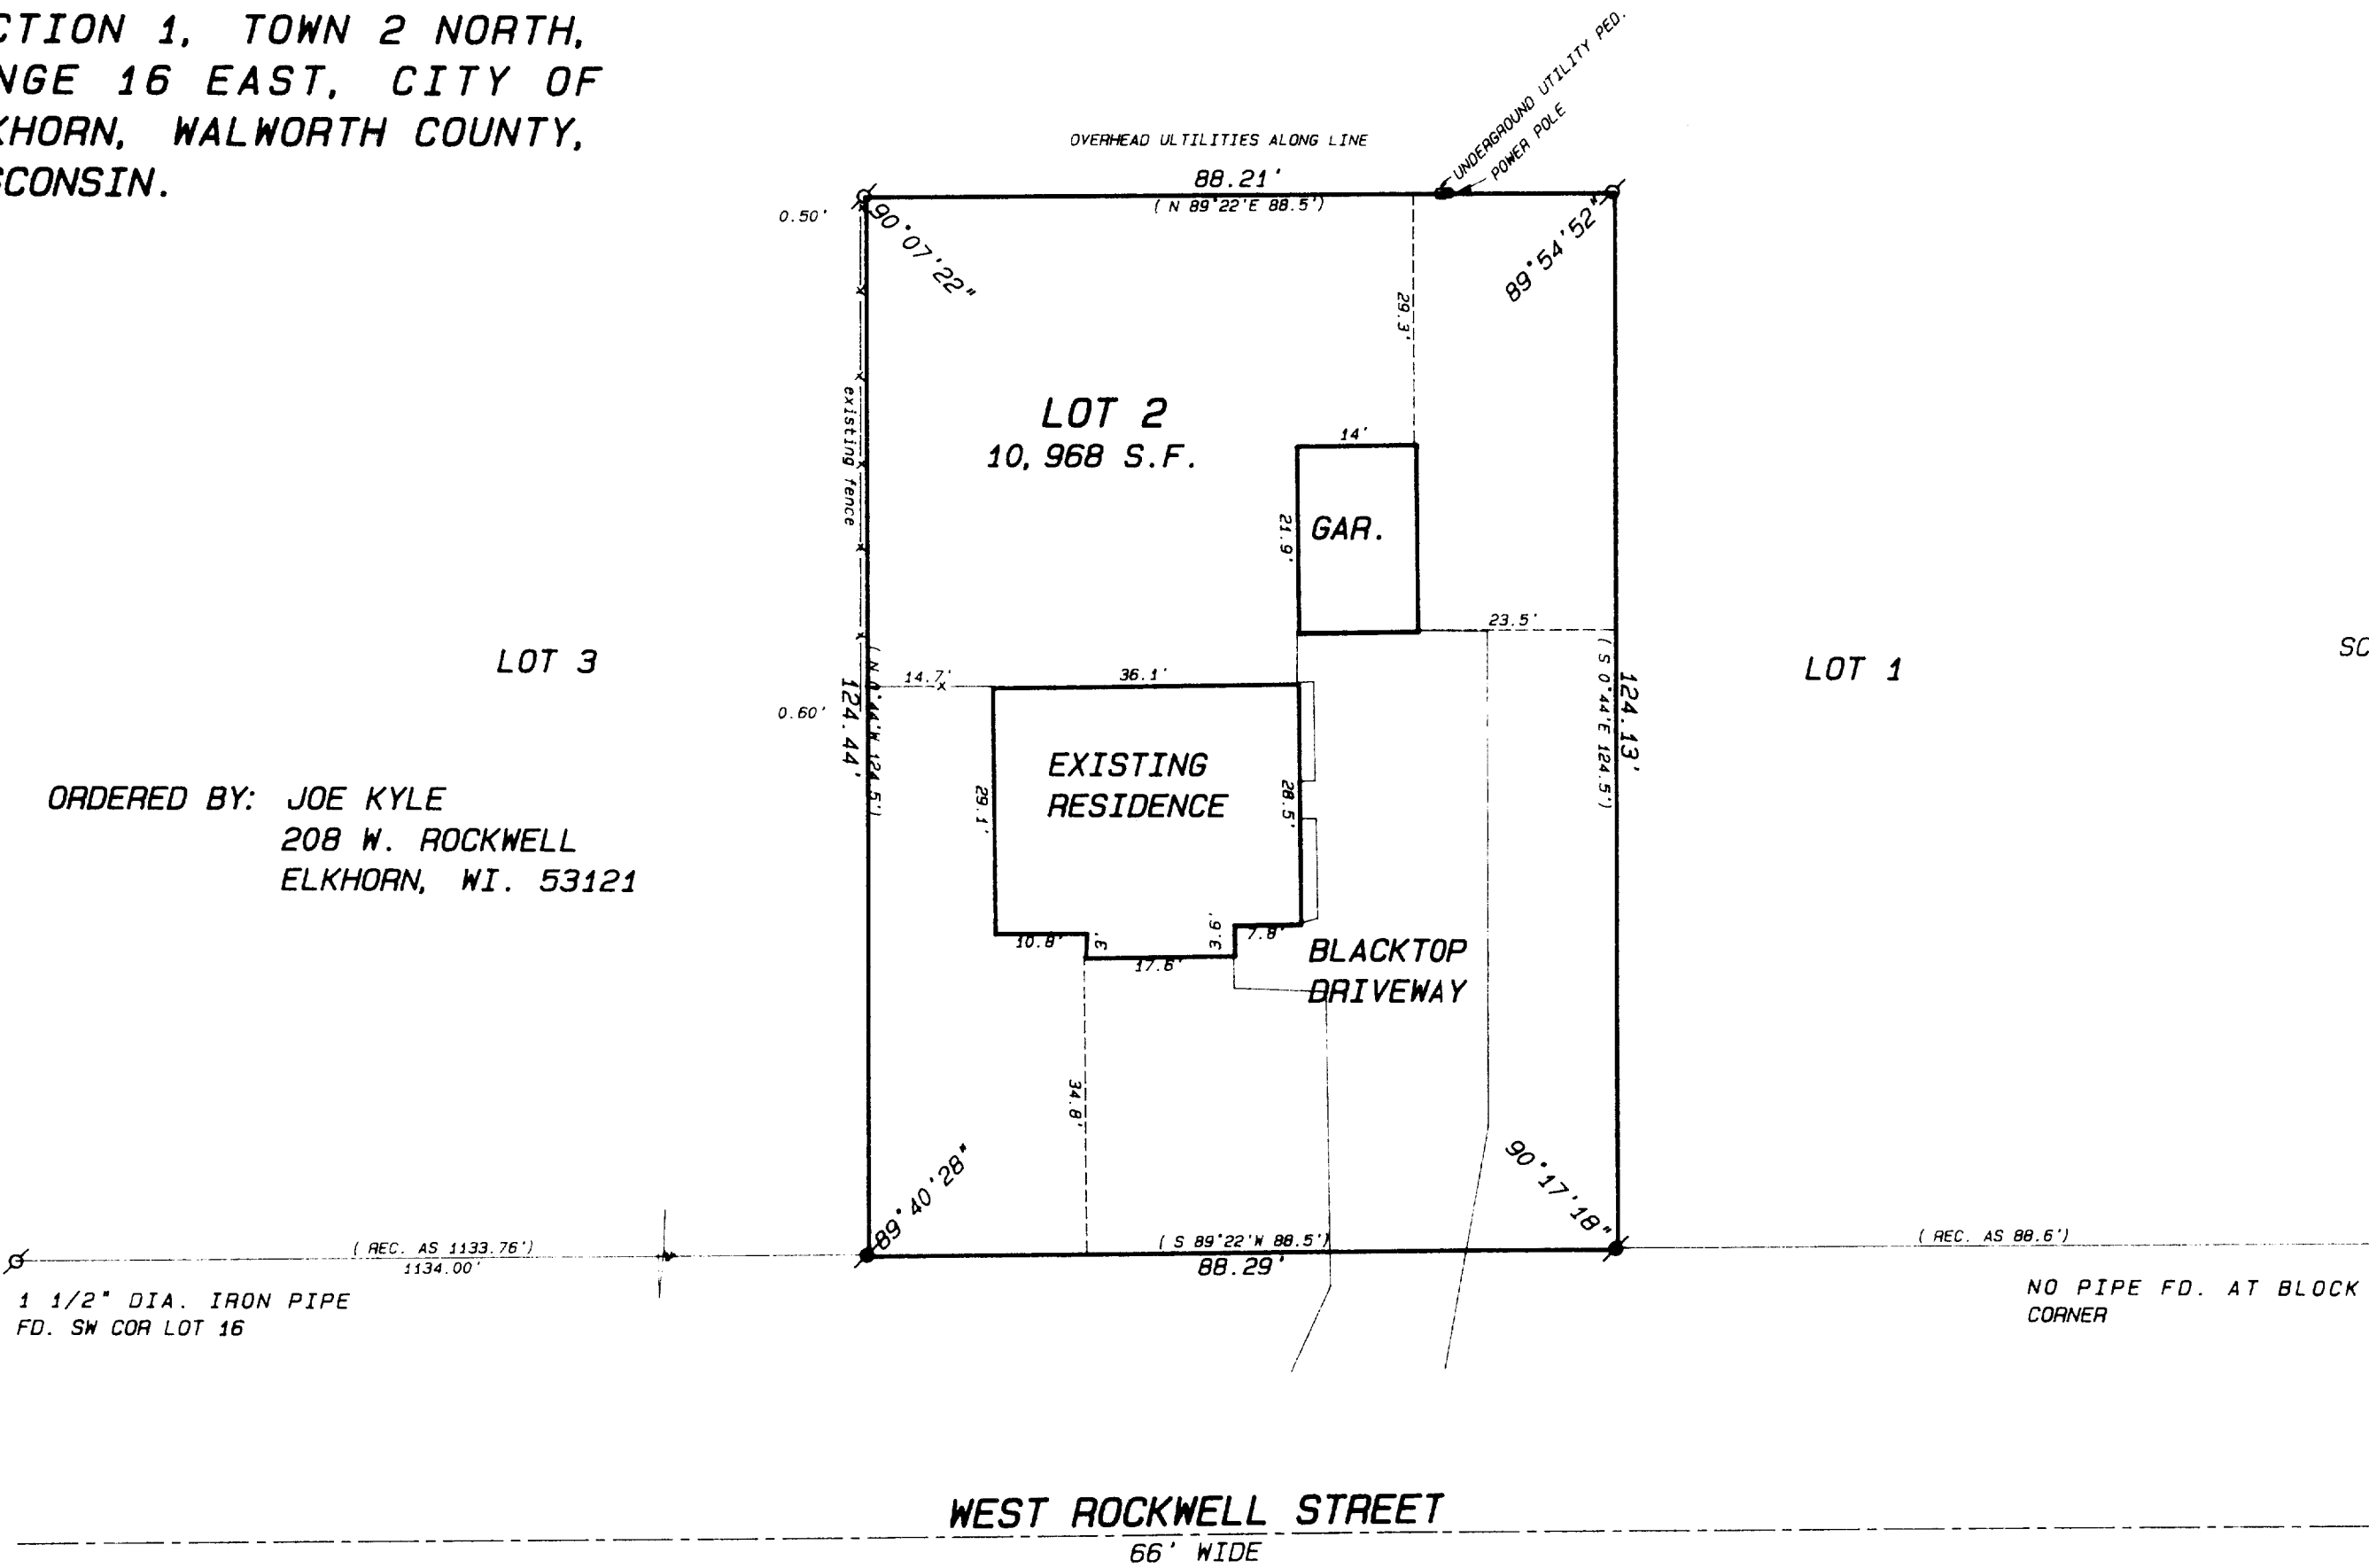

- Legend
- FOUND IRON PIPE
 - FOUND IRON ROD
 - FOUND BRASS CAPPED MONUMENT
 - FOUND CONCRETE MONUMENT
 - CHISEL CUT IN CONCRETE
 - SET IRON ROD, 24" LONG, WEIGHING 1.5 LBS. LINEAL FT., 3/4" DIA.
 - SET IRON ROD, 30" LONG, WEIGHING 4.5 LBS. LINEAL FT., 1 1/16" DIA.
 - RECORDED AS DIMENSION
 - EXISTING FENCE

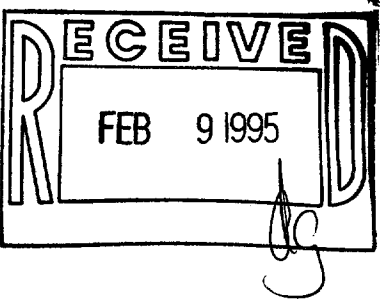

SCALE: 1" = 20 FEET

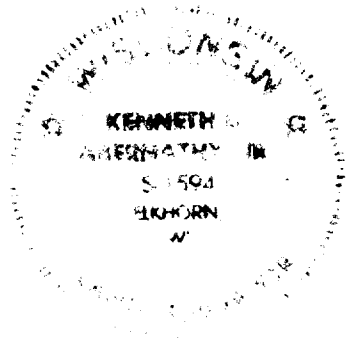

I hereby certify that the above described property has been surveyed by me in under my direction and that the above map is a true representation thereof and shows the size and location of the property, its exterior boundaries, the location of all visible structures and dimensions of all principal buildings thereon, boundary fences, apparent easements, roadways, and visible encroachments, if any.
This survey is made for the use of the present owners of the property and also those who purchase, mortgage, or guarantee the title thereto within and year from date hereof.

Kenneth B. Abernathy, Jr.
KENNETH B. ABERNATHY, JR.
WISCONSIN REGISTERED LAND SURVEYOR,
S-1594
Date: 1/26/95 Job No. 95.111

DESIGN PRODUCTS
004-902

YJA-2