


53-10

1129-1

RANDALL PLACE

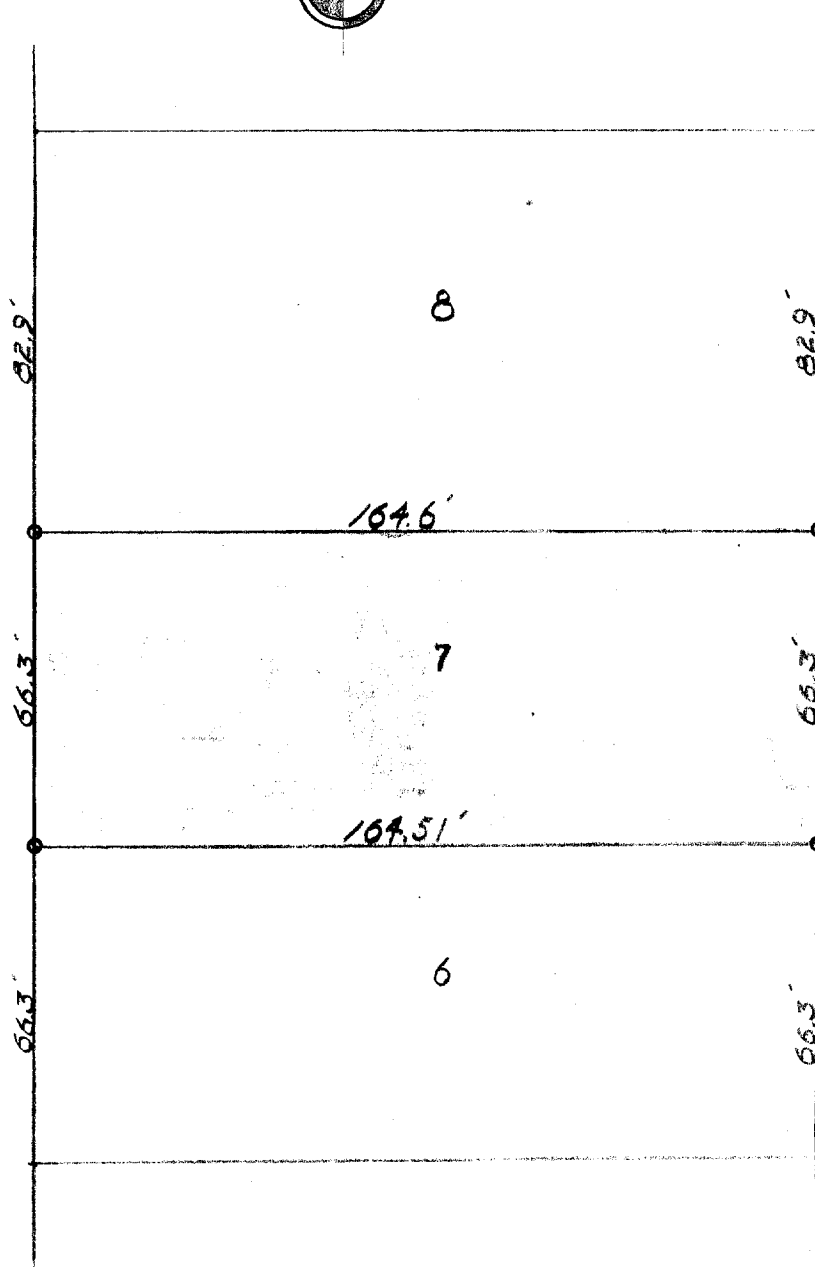

DESCRIPTION:

Lot 7, Block 1, Hodges Addition to the City of Elkhorn, Walworth County, Wisconsin.

CERTIFICATE:

I, hereby certify that I, have on this the 4th day of June, 1953, surveyed the above described property and that no encroachments exist.

SIGNED AND SEALED ON THIS THE 5TH DAY OF JUNE 1953.

Joseph M. Biagi
Joseph M. Biagi. Professional Engineer.
Elkhorn Wisconsin.

YH06

4-94 B