


PLAT OF SURVEY

LOT 43 OF JACKSON CREEK SUBDIVISION
LOCATED IN THE SW 1/4 SEC. 7, T. 2 N., R. 17 E.

CITY OF ELKHORN
WALWORTH COUNTY, WISCONSIN

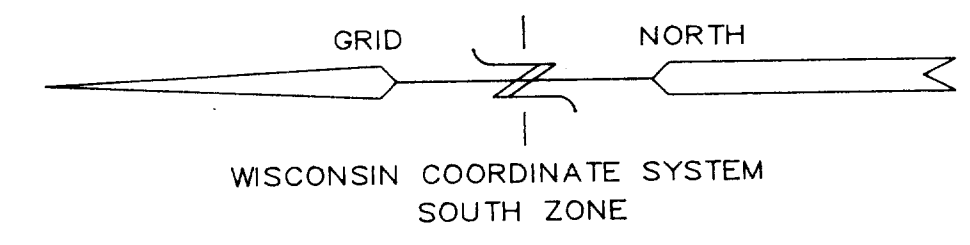



- = FOUND SOLID ROUND IRON BAR
STAKE 1 5/16 DIA.
- = FOUND IRON PIPE STAKE 1" DIA.
- = FOUND IRON REBAR STAKE 3/4" DIA.
- = FOUND CONCRETE COUNTY MONUMENT
- (XXX) = RECORDED AS

NOTE: COPIES OF THIS MAP TO WHICH THE FOLLOWING
CERTIFICATE WILL APPLY ARE BLUE LINE PRINTS
SHOWING SURVEYOR'S ORIGINAL SEAL AND SIGNATURE IN
BLACK INK. COPIES BY ANY OTHER MEANS MAY HAVE
ALTERATIONS WHICH DO NOT REPRESENT THE SURVEYOR'S
WORK PRODUCT.

I HEREBY CERTIFY THAT THE ABOVE DESCRIBED PROPERTY
HAS BEEN SURVEYED UNDER MY DIRECTION AND THAT THE
ABOVE MAP IS A TRUE REPRESENTATION THEREOF AND
SHOWS THE SIZE AND LOCATION OF THE PROPERTY, ITS
EXTERIOR BOUNDARIES. THIS SURVEY IS MADE FOR THE
USE OF THE PRESENT OWNERS OF THE PROPERTY, AND
ALSO THOSE WHO PURCHASE, MORTGAGE, OR GUARANTEE
THE TITLE THERETO WITHIN ONE YEAR FROM THE DATE
HEREOF.

DATED: 12-1-95

Peter S. Gordon
PETER S. GORDON R.L.S. 2101

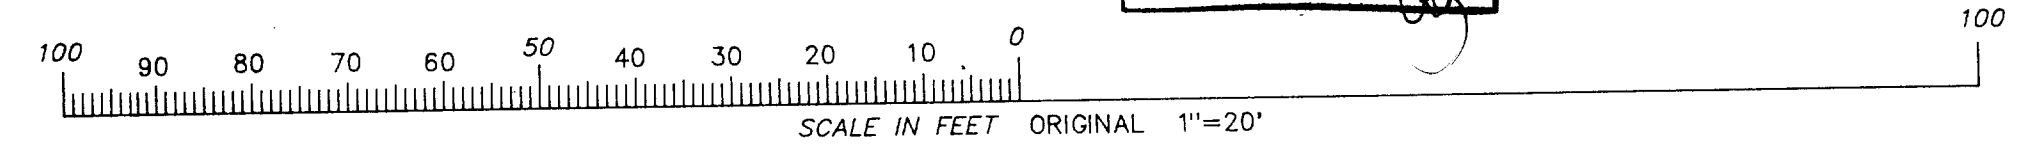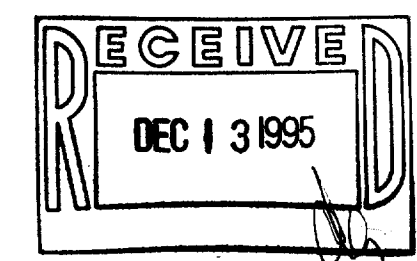

LOT 42


LOT 37

LOT 31

LOT 44

NORTH CREEK DRIVE
66' ROW

LOT 43
13265 SF

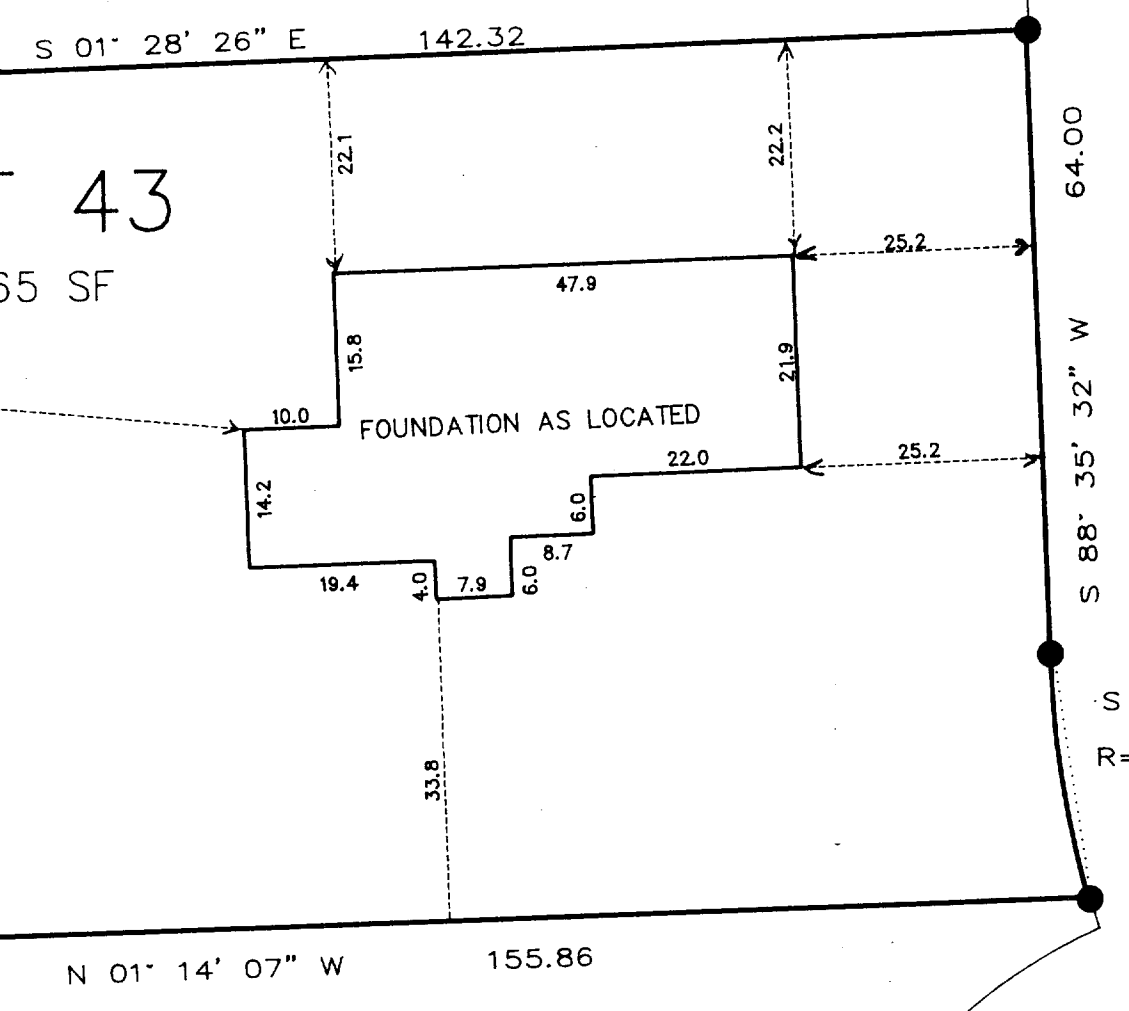

WETLANDS

10' UTILITY EASEMENT

YJC-43
04-962

WORK ORDER BY: JOE SHIRK
714 MADISON DRIVE
DELAWARE, WI. 53115

FARRIS, HANSEN & ASSOCIATES, INC.
Engineering, Architecture, Surveying
7 Ridgeway Court P.O. Box 437
ELKHORN, WISCONSIN 53121
Office: (414) 723-2098
Fax: (414) 723-5886

REVISIONS	
PROJECT NO.	4055, 43
DATE	11/30/95
SHEET NO.	1 OF 1