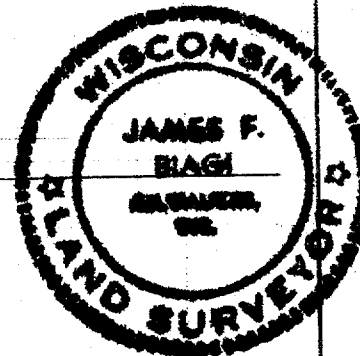
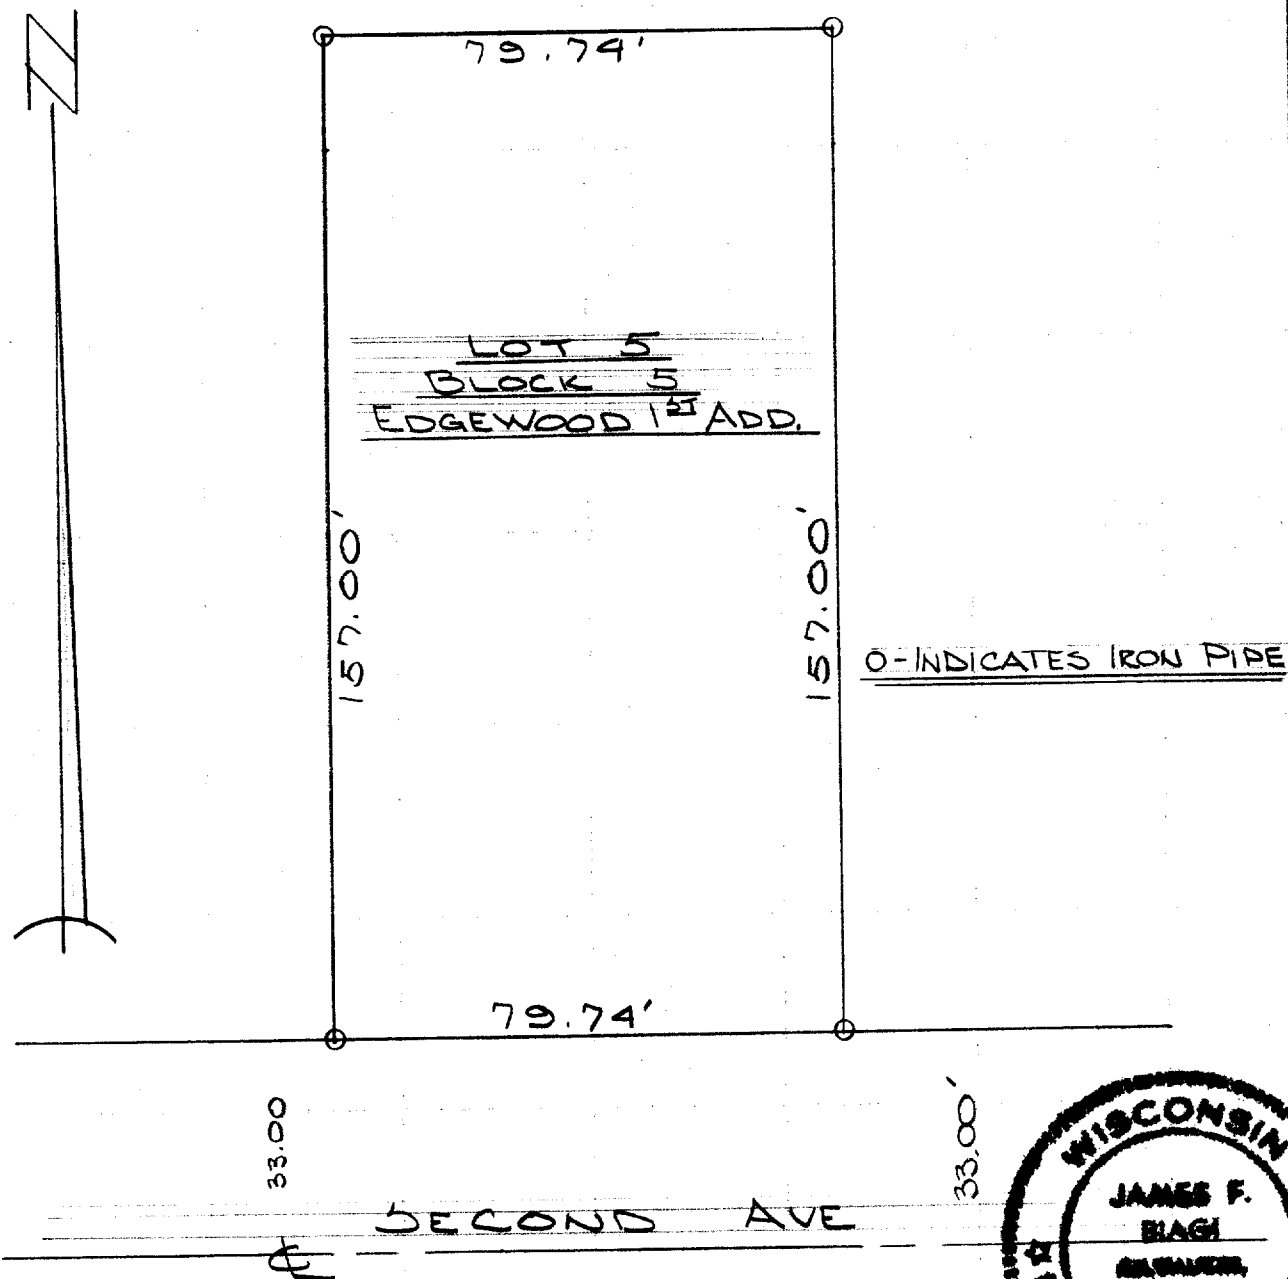


Description:

Lot 5 of Block 5 of Edgewood 1st Addition, Subdivision
located in the City of Elkhorn, Walworth County
Wisconsin.

Certificate:

I, James F. Biagi, surveyor, do hereby certify
that I have surveyed the property hereon described.

March 28, 1970

James F. Biagi
James F. Biagi, R.L.S. 272

YEA 6-20

4-9B