
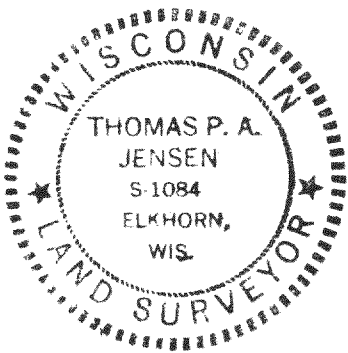


# PLAT OF SURVEY

OF

LOT 4, BLOCK 2, TREE TOWNS SUBDIVISION,  
 LOCATED IN THE NW $\frac{1}{4}$  OF THE NW $\frac{1}{4}$  OF SECTION 31,  
 T3N R19E, CITY OF ELKHORN, WALKWORTH COUNTY,  
 WISCONSIN.

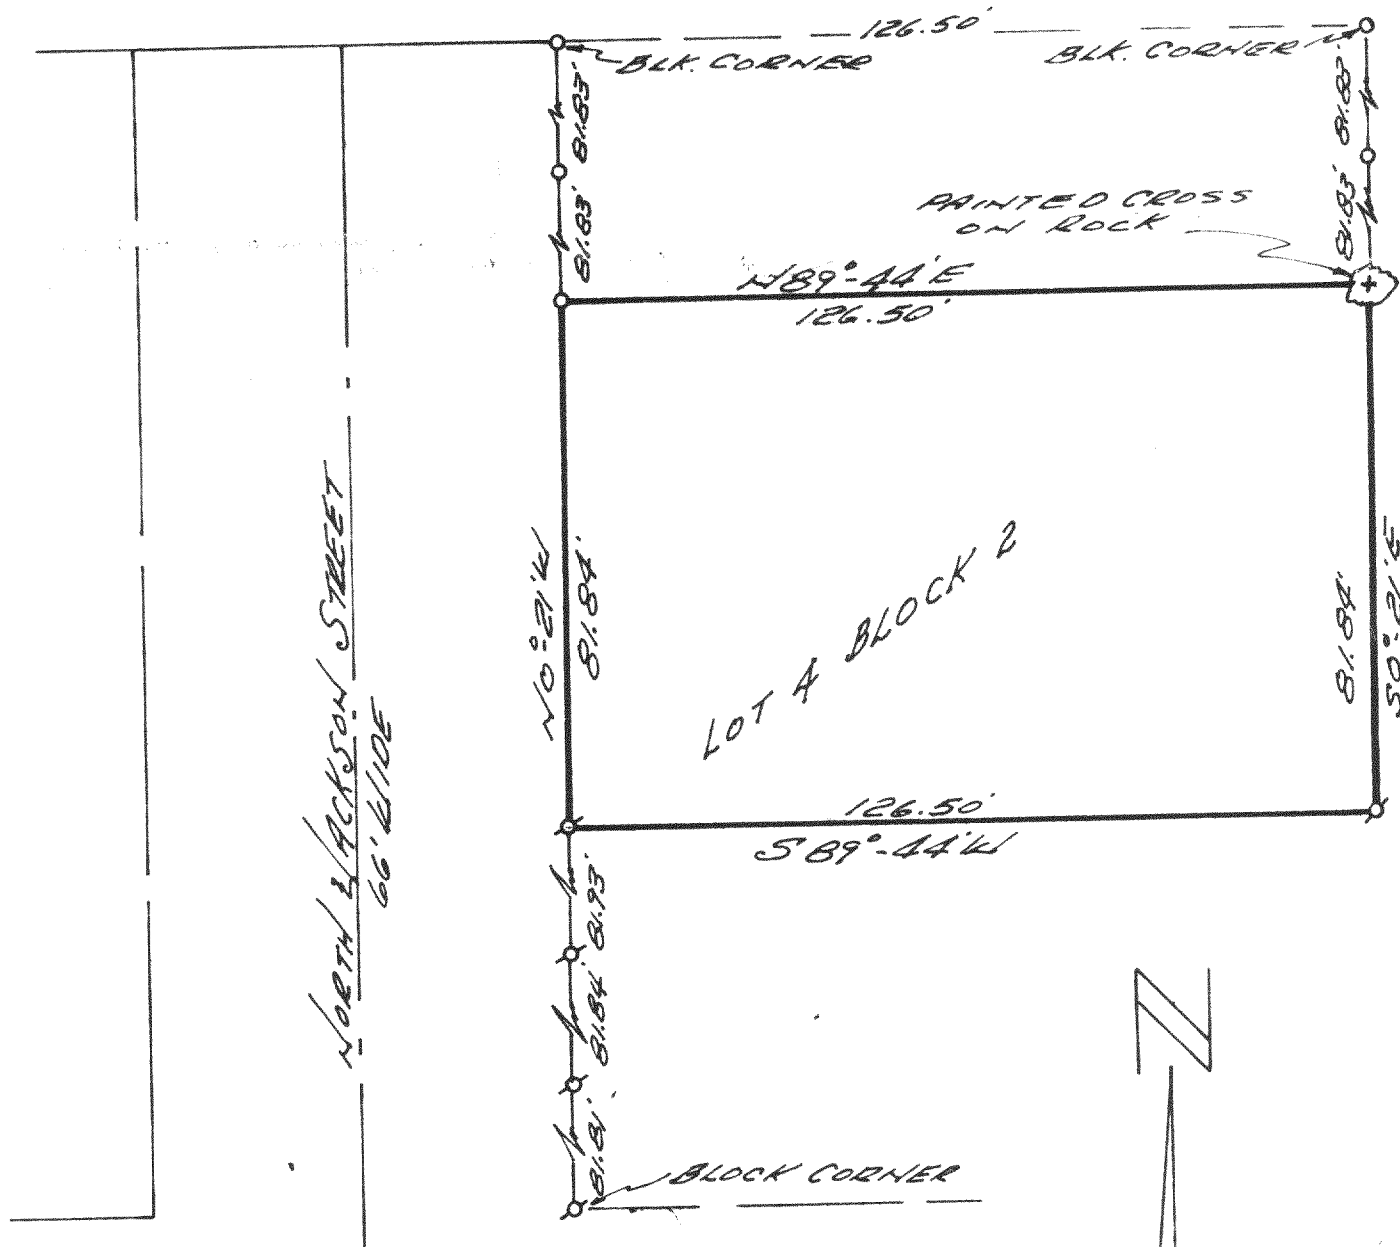

SURVEY AND PLAT BY  
**JENSEN & JOHNSON, INC.**  
 CIVIL ENGINEERS AND SURVEYORS

Elkhorn, Wisconsin

**LEGEND**

- — Iron Pipe SET
- — Concrete Monument
- Scale 1" = 30'
- ⊕ — IRON PIPE FOUND

WE CERTIFY: That we have surveyed the above described property and that the plat shown hereon is an accurate survey and a true representation thereof and correctly shows the exterior boundary lines and all divisions of said property.

Date 4 JULY 25, 1974 Thomas P. A. Jensen

Wisconsin Registered Land Surveyor, No. S-1084