


59-29

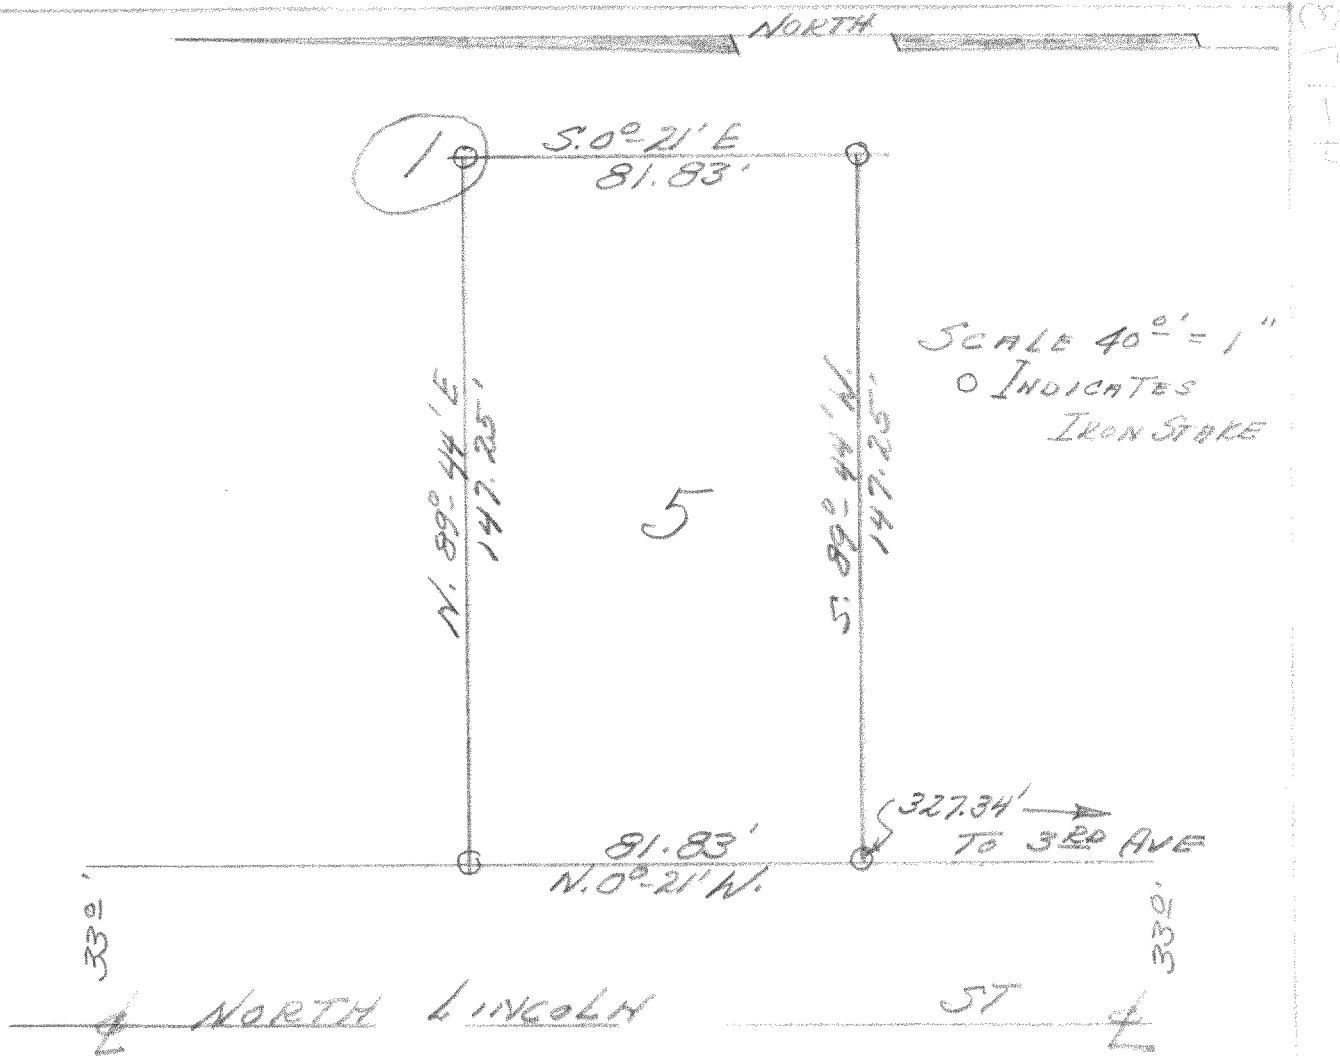

DESCRIPTION:

Lot 5 Blk 1 Tree Towns Subdivision in the City of Elkhorn, Walworth County, Wisconsin.

CERTIFICATE: I, James F. Biagi, Surveyor, do hereby certify that I have surveyed and staked the above described property, and that the measurements and bearings on the boundary lines are in accordance with official records on file in the Register of Deeds Office in and for the County of Walworth, Wisconsin.

Signed and Sealed this 15th day of April 1959.

James F. Biagi
James F. Biagi, (RLS 272)

YTT5-5, YTT5-6

4-173