


PLAT OF SURVEY

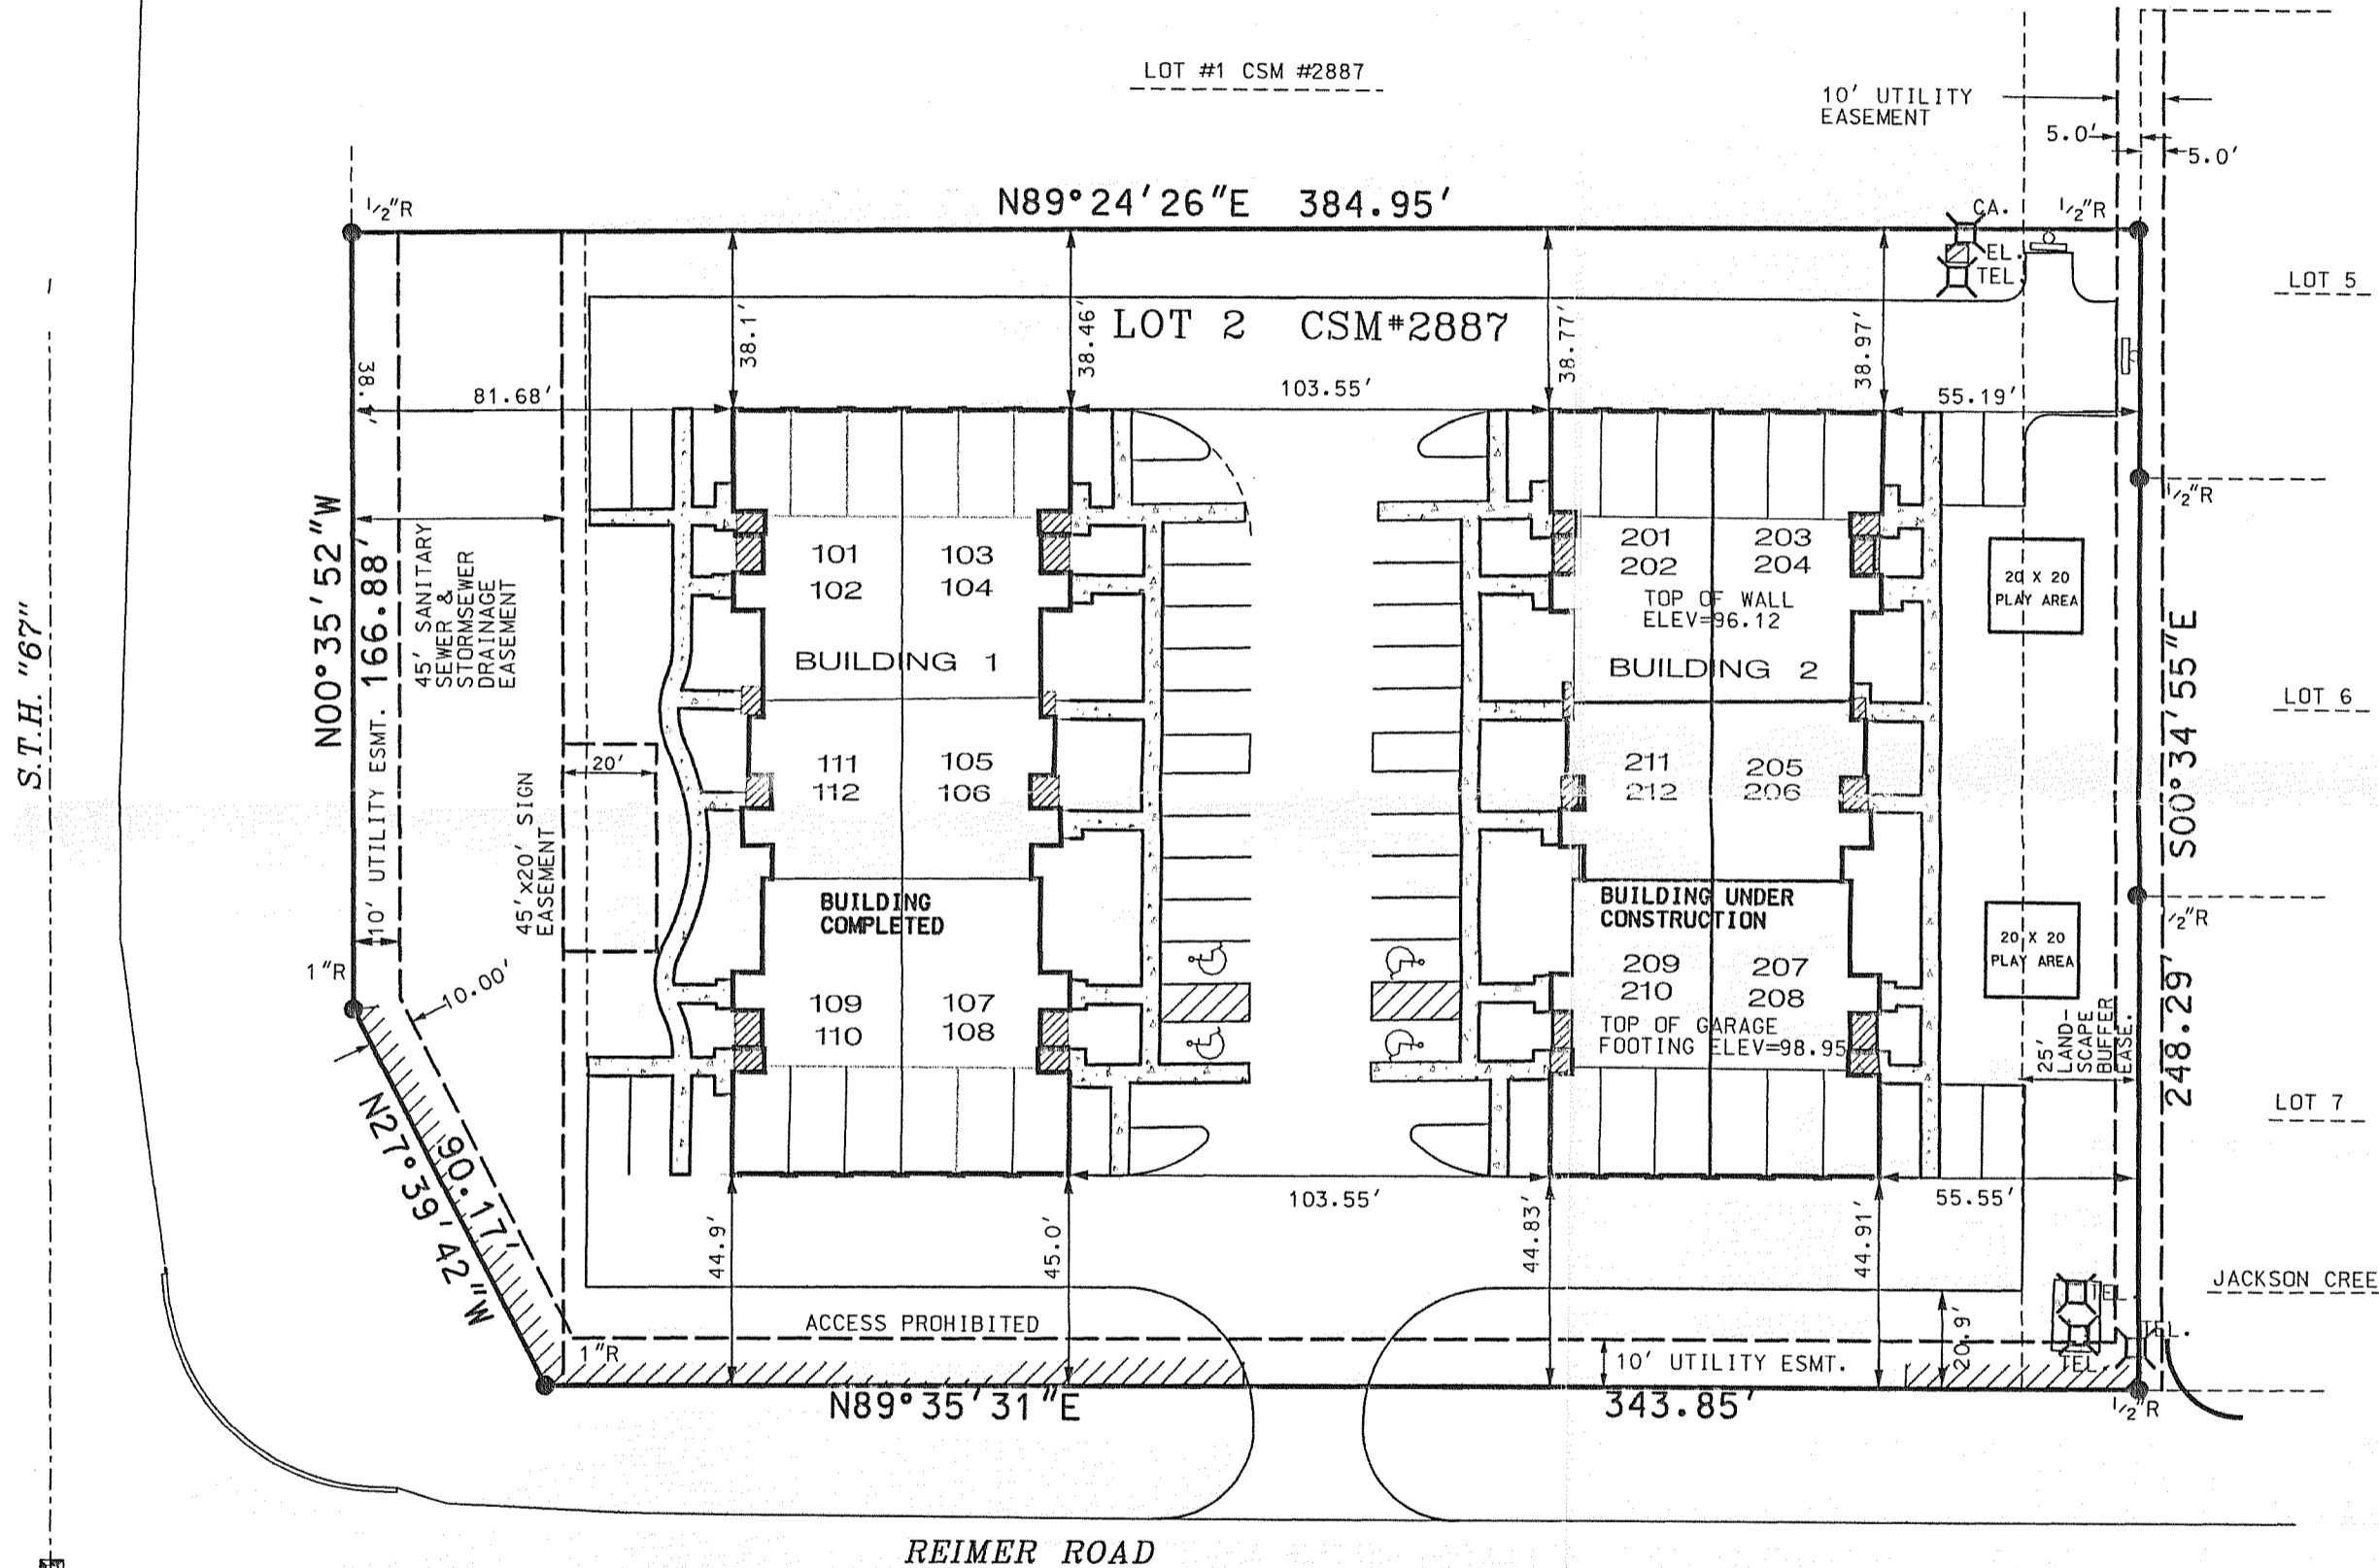

LEGEND

- \bullet 1/2" R FOUND IRON ROD
- \bullet 1" R FOUND IRON ROD
- CA TEL CABLE & TELEPHONE PEDISTAL
- \square POWER POLE
- EL ELECTRICAL PEDISTAL
- WM PROPOSED WATER METER
- EM/GM PROPOSED ELECTRIC AND GAS METER

RECERTIFICATION DATE: 02/14/2005

PLAT OF SURVEY

FOR: SCOTT SIMON GROUP
 DATE: 11/02/2004
 PROJECT NO. 03182

N

Scale 1" = 40'

LEGAL DESCRIPTION:

LOT 2 OF C.S.M. NO. 2887, BEING A DIVISION OF OUTLOT 1 OF JACKSON CREEK SUBDIVISION LOCATED IN THE SW¹/₄ OF THE SW¹/₄ OF SECTION 7, TOWN 2 NORTH, RANGE 17 EAST, CITY OF ELKHORN, WALWORTH COUNTY, WISCONSIN.


I PAUL H. VAN HENKELUM R.L.S. # 1931 HEREBY CERTIFY THAT THIS SURVEY WAS MADE IN ACCORDANCE WITH THE MINIMUM STANDARDS FOR PROPERTY SURVEYS (CHAPTER A-E7) STATE OF WISCONSIN AND HAS BEEN PREPARED UNDER MY DIRECTION AND CONTROL AND IS CORRECT TO THE BEST OF MY KNOWLEDGE AND BELIEF.

PAUL H. VAN HENKELUM, R.L.S. # 1931

NO.	REVISIONS	BY	DATE

RSV
ENGINEERING, INC.
 Engineers Land Surveyors Environmental Scientists
 801 MAIN STREET MUKWONAGO, WISCONSIN 53149 (262)363-2004

RECEIVED
 MAY 31 2005

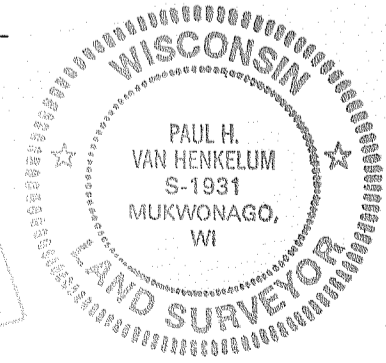

YJCVI-106 YJCVI-201 YJCVI-202 YJCVI-203 YJCVI-205
 YJCVI-101 YJCVI-102 YJCVI-104 YJCVI-204 YJCVI-206
 YJCVI-103 YJCVI-105

004-1980

RSVDAT46/BRADTD503/03182/03182PLAT3.DGN 11/2/04 10/22/2004 02/14/2005