



PREPARED FOR
TOM MARTIN
KEEFE REAL ESTATE
ELKHORN, WI.

PLAT OF SURVEY


- OF -

PATHFINDER SURVEYING INC.
(formerly)
J.K. SURVEYING INC.
N3705 WILLOWBEND LANE
LAKE GENEVA, WI, 53147
262-248-8303

THE SOUTH 68.00 FEET OF LOT 5, BLOCK 1, TREE TOWN SUBDIVISION,
LOCATED IN THE NE 1/4 OF SECTION 31, TOWNSHIP 3 NORTH, RANGE 16
EAST OF THE FOURTH PRINCIPAL MERIDIAN, CITY OF ELKHORN, COUNTY
OF WALWORTH AND STATE OF WISCONSIN.

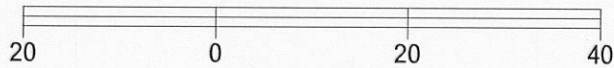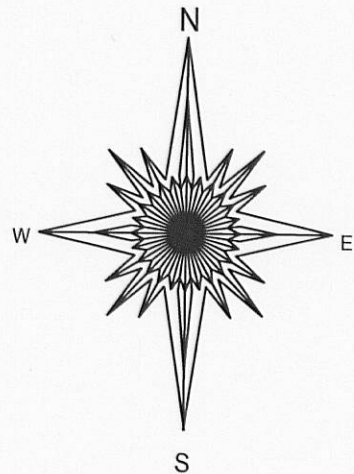

N. LINCOLN STREET

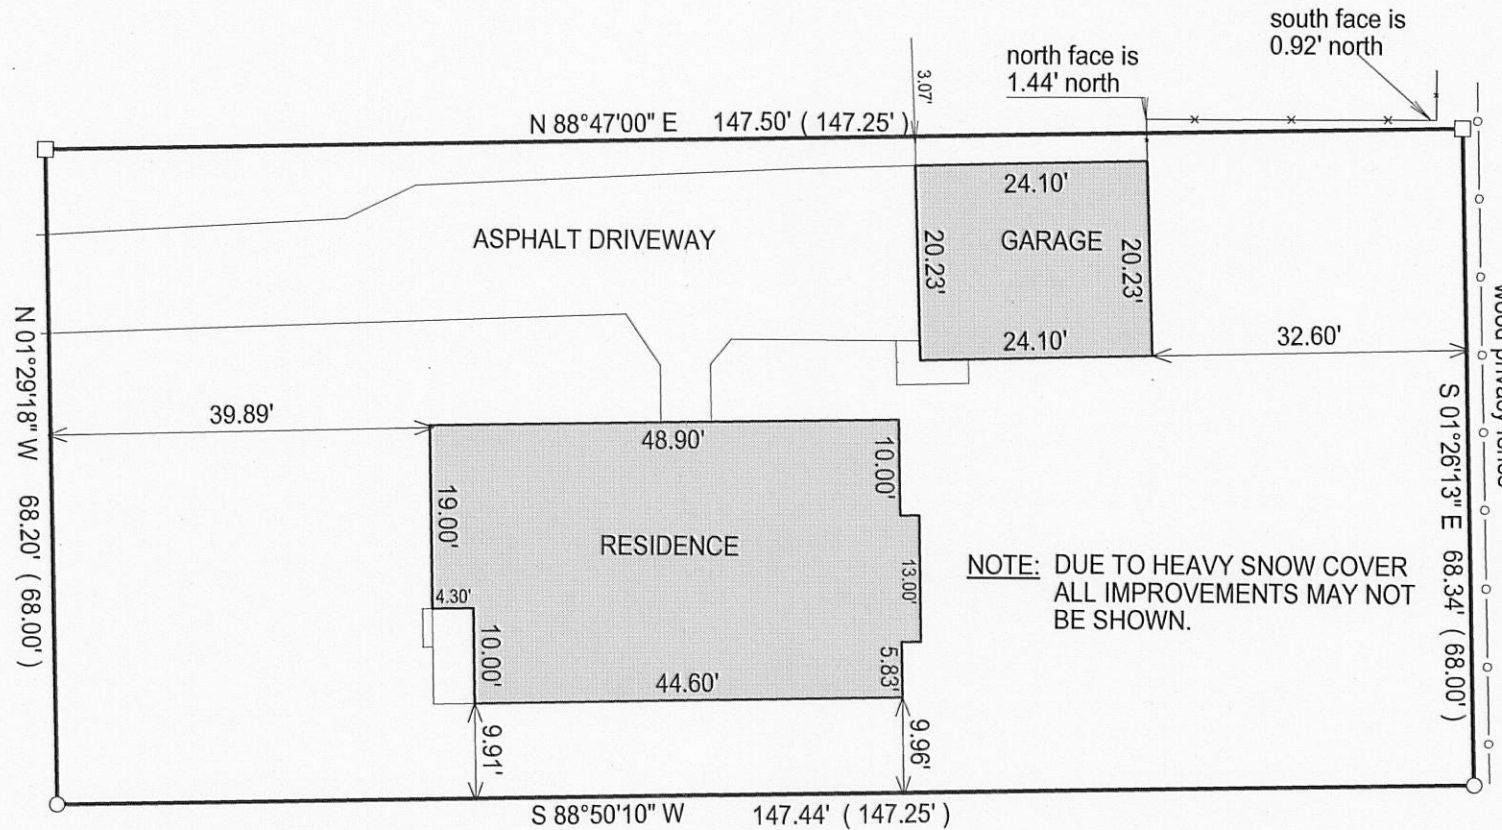

- () = recorded as
- = found iron bar
- = found iron pipe
- = set iron pipe
- = set iron bar

SCALE 1" = 20'

JOB # 10-21

TAX ID # YTTS 00005



BASIS OF BEARING OF THIS PLAT: THE NORTH LINE OF THE SOUTH 68.00 FEET OF LOT 5 BLOCK 1 WAS ASSUMED TO BEAR N88°47'00"E.

COMPARE LEGAL DESCRIPTION ABOVE AND DRAWING WITH DEED. FOR BUILDING RESTRICTIONS AND EASEMENTS NOT SHOWN, REFER TO DEED, ABSTRACT SOURCES AND LOCAL MUNICIPAL CODES. NOTIFY THE SURVEYOR IMMEDIATELY OF ANY DISCREPANCY.

"I hereby certify that I have surveyed the above described property and that the above map is a true representation thereof and shows the size and location of all visible structures, apparent easements and encroachments if any."

This survey is made for the present owners of the property, and those who purchase, mortgage, or guarantee the title thereto, within one year from the date hereof.

DATED THIS 20TH DAY OF FEBRUARY, 2010.

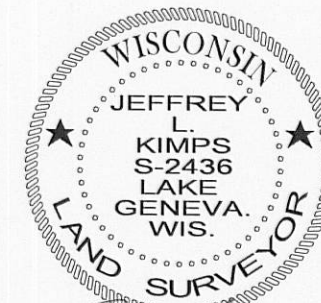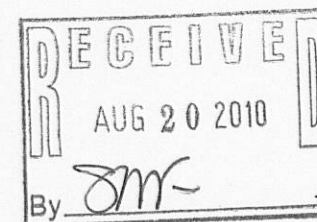

JEFFREY L KIMPS S - 2436
Wisconsin Registered Land Surveyor
(original if signed in red)

1022-700