


98-62


4 9203

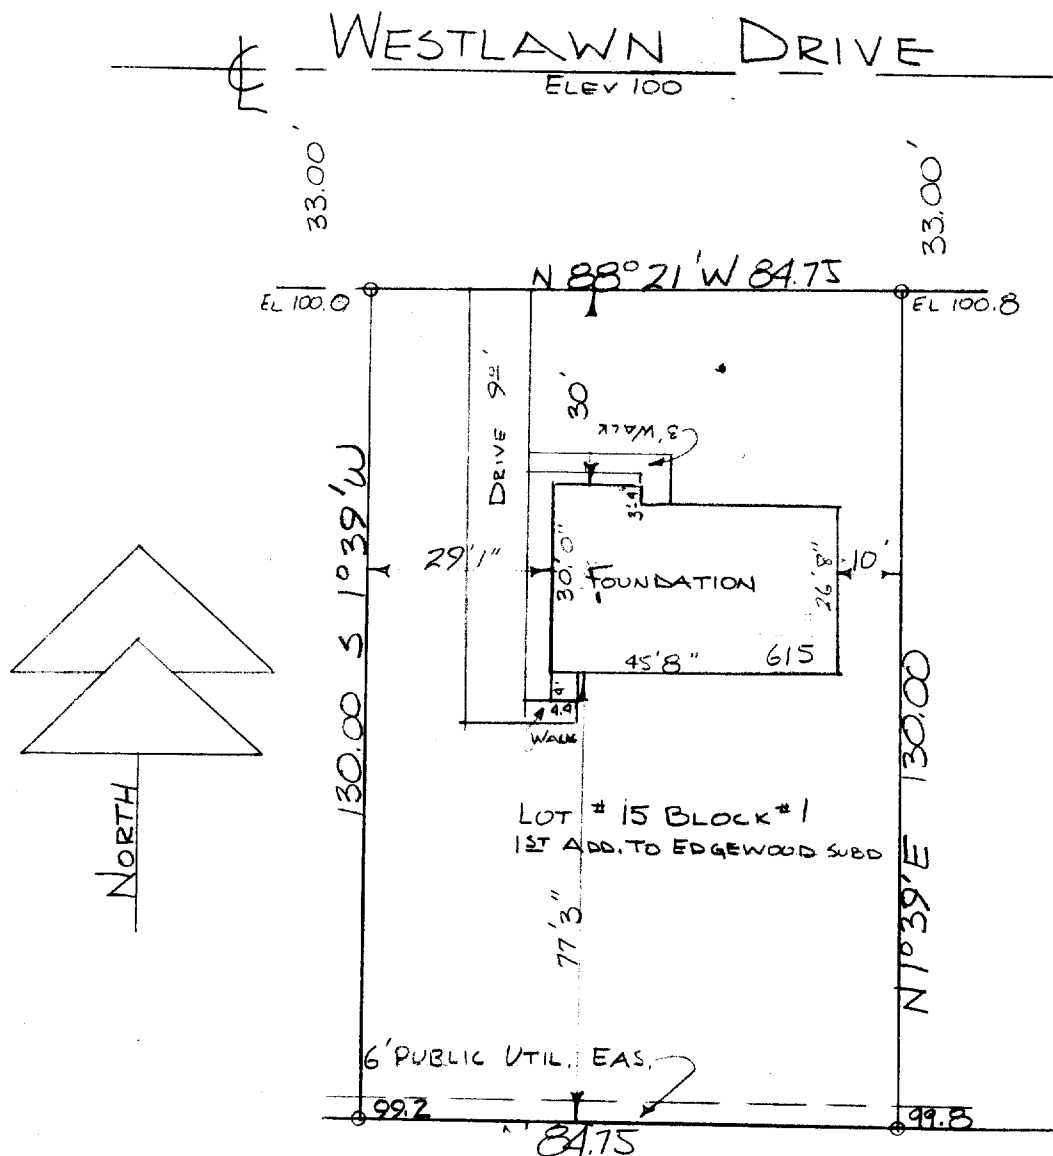

DESCRIPTION: ~~Lot 15 of Block # 1, Edgewood Subd. Addition in the~~
City of Elkhorn, Walworth County, Wisconsin.

CERTIFICATE: I, James F. Biagi, surveyor, do hereby certify that
I have surveyed the property hereon described, and that the location
of all the improvements are as shown on the drawing above.

January 15, 1962

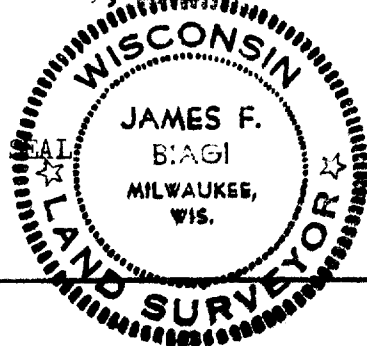

James F. Biagi
James F. Biagi RLS 272

YEA 1-12