




# D Cooper & CO., INC

Rt 4 Box 508B • Elkhorn WI 53121

Plat of Survey of Lot 4, Block 2 of Tree Towns Subdivision being a subdivision located in the City of Elkhorn, Walworth County, Wis.

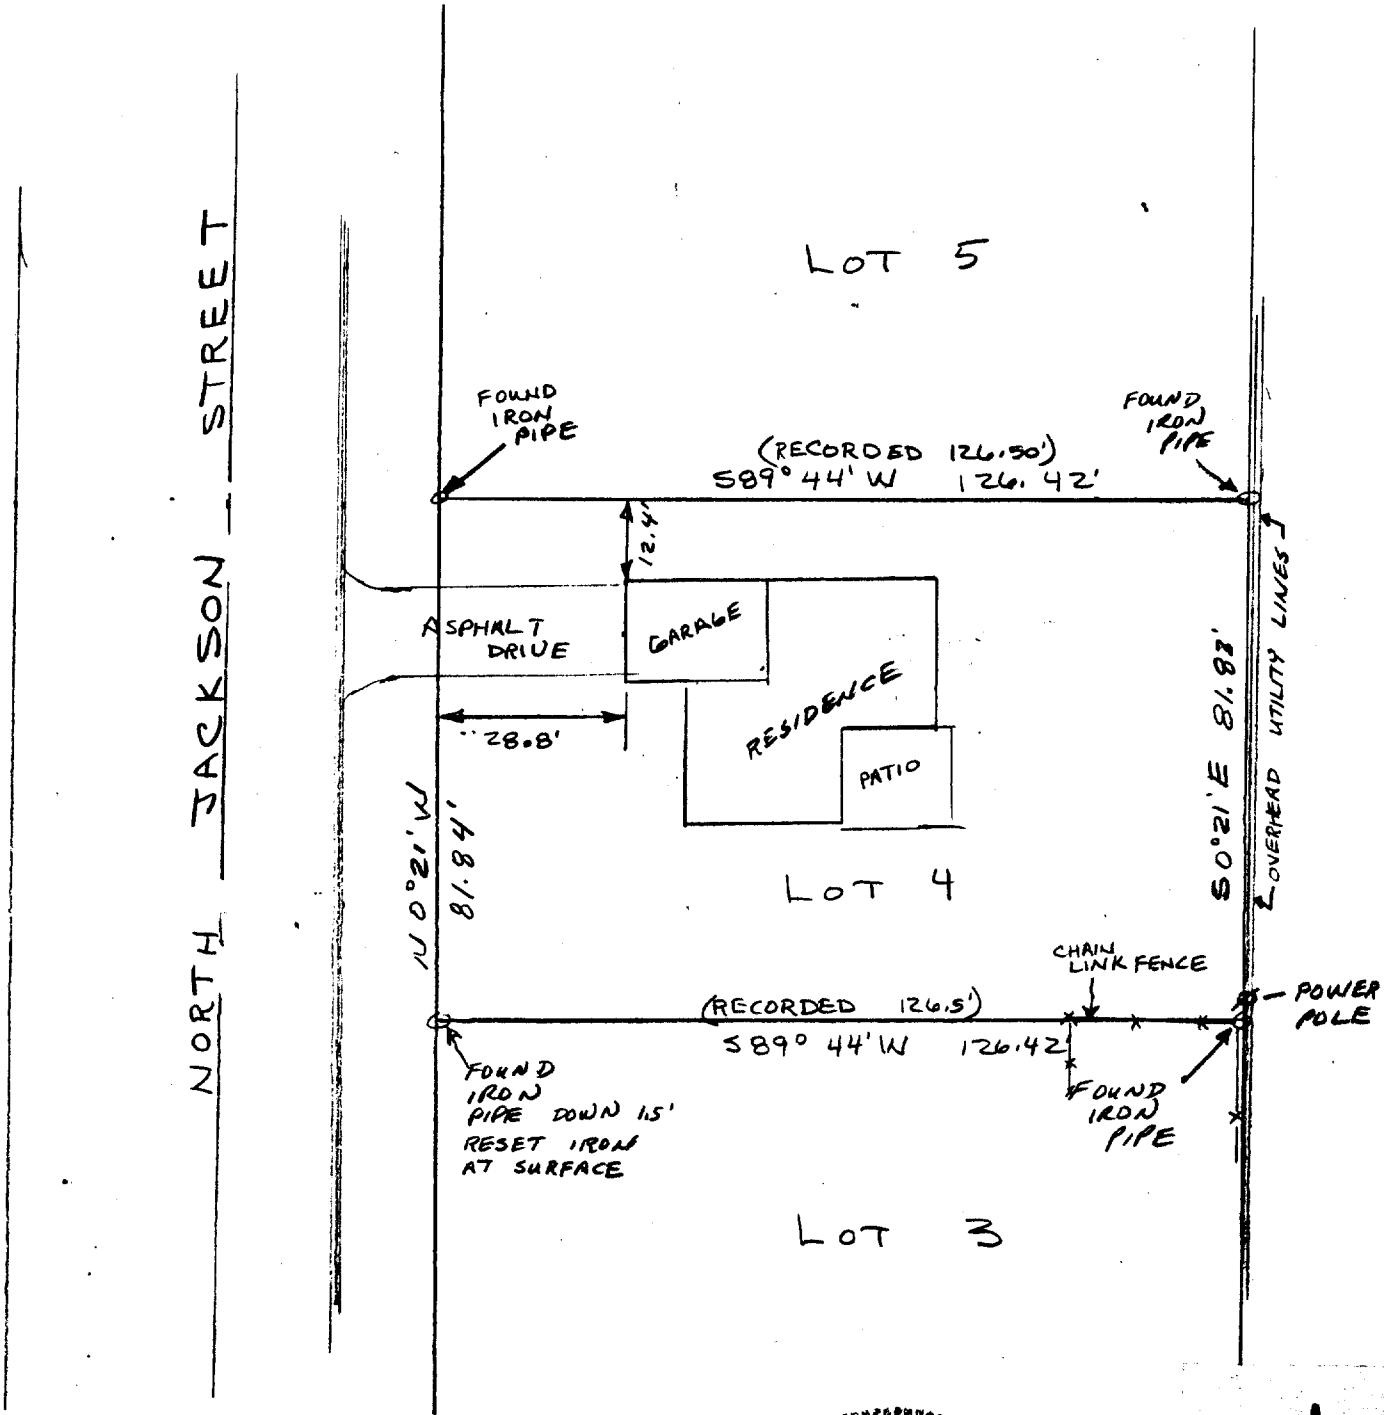

Survey ordered by Modern Realty- Elkhorn

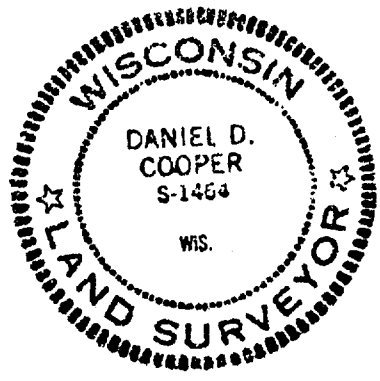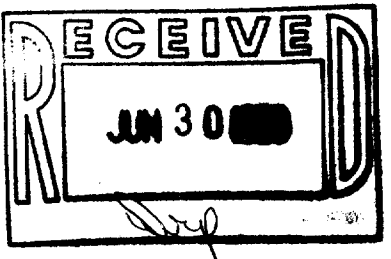

SCALE 1"=30'

I hereby certify that I have surveyed the property described hereon and that the map shown hereon is a true and accurate representation thereof to the best of my professional knowledge and belief.

Dated this 14 day of JUNE, 1988

YTT-16 *Daniel D Cooper*

4-824  
DRAWING NO. 3267