



BOUNDARY SURVEY W/ IMPROVEMENTS

WORK ORDERED BY:  
ERA CORNER REALTY  
5362 STATE ROAD "11"  
ELKHORN, WISCONSIN 53121




FARRIS, HANSEN & ASSOCIATES, INC.  
Engineering, Architecture, Surveying  
7 Ridgeway Court P.O. Box 437  
ELKHORN, WISCONSIN 53121  
Office: (414) 723-2098  
Fax: (414) 723-5586

REVISIONS

PROJECT NO.  
4862  
DATE:  
10/21/97  
SHEET NO.  
1 OF 1

# PLAT OF SURVEY


LOT 6, BLOCK 2, TREE TOWNS SUBDIVISION,  
LOCATED IN THE NORTHWEST 1/4 OF THE  
NORTHWEST 1/4 OF  
SECTION 31, TOWN 3 NORTH, RANGE 17 EAST,  
CITY OF ELKHORN, WALWORTH COUNTY, WISCONSIN

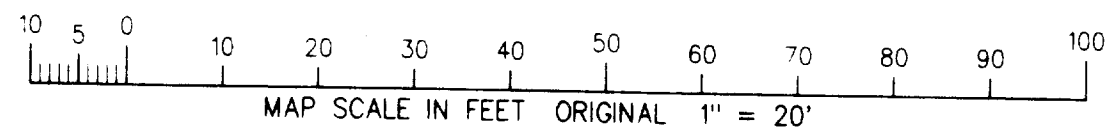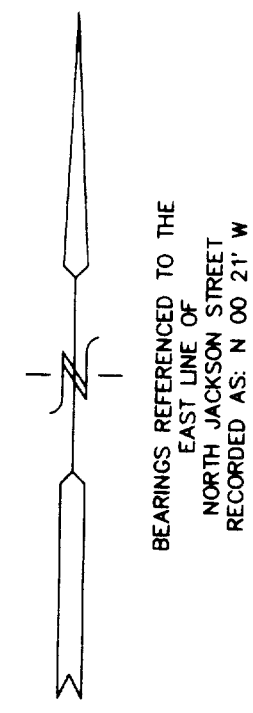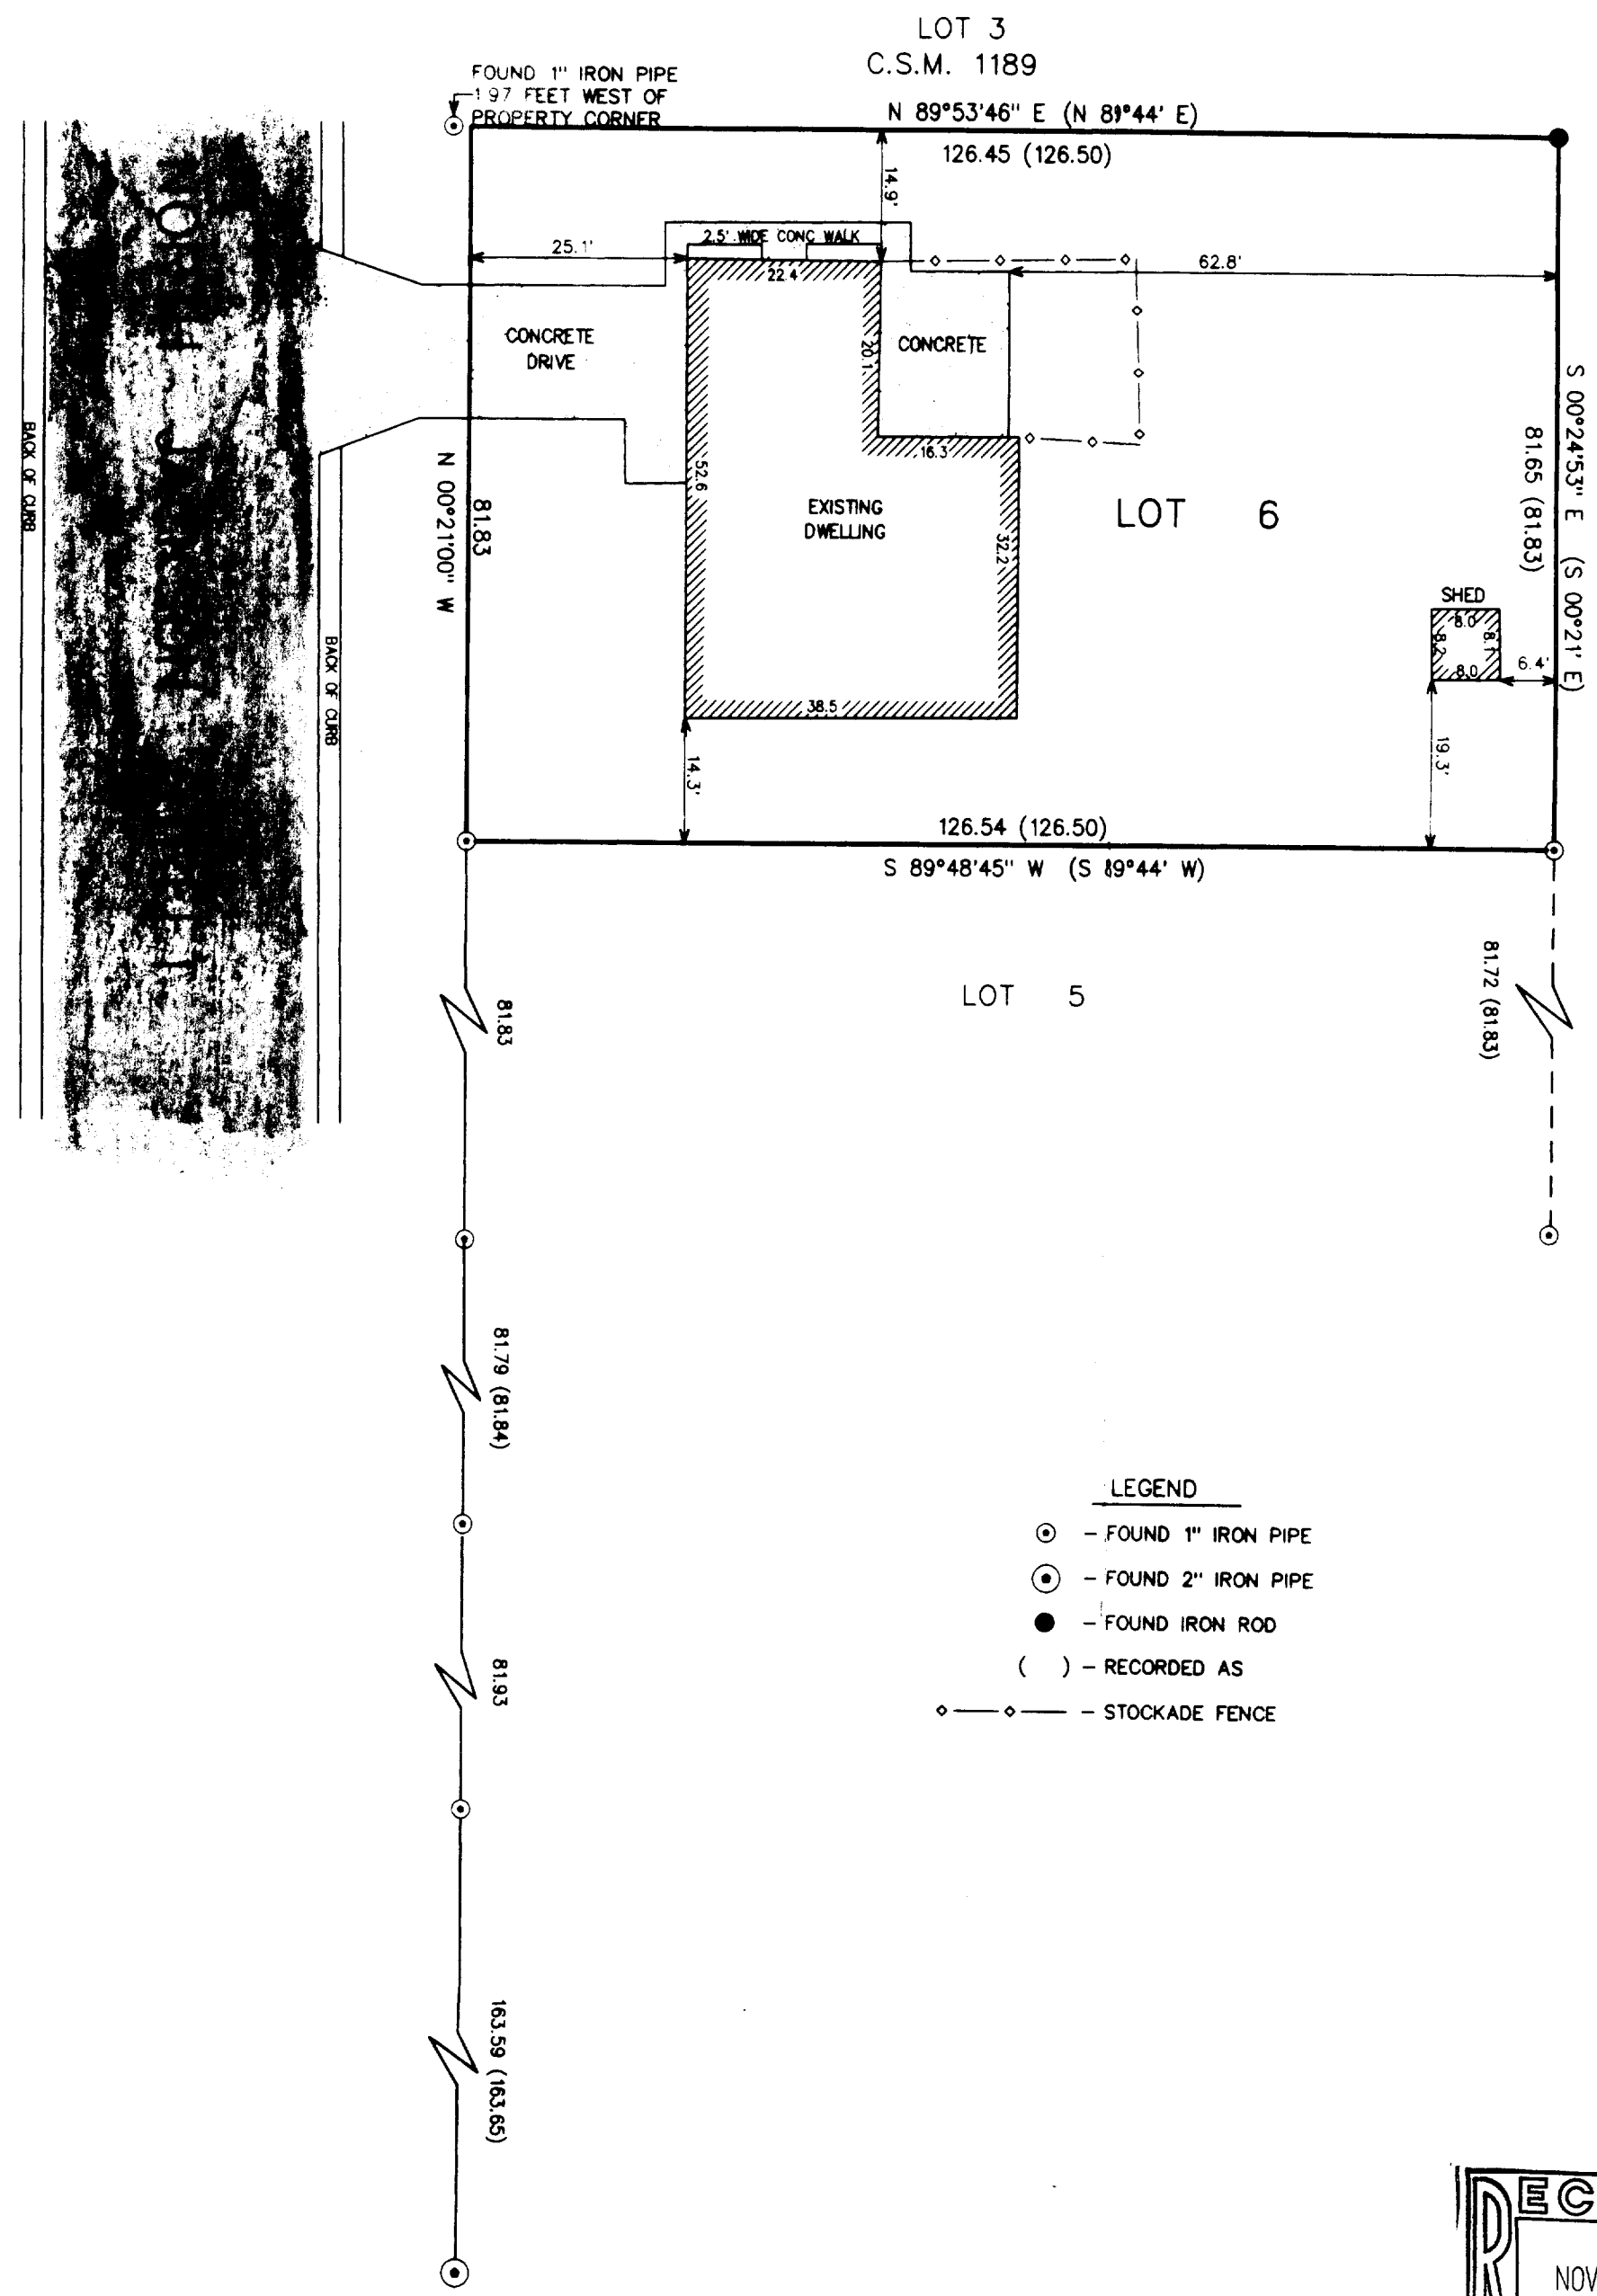


NOTE: COPIES OF THIS MAP TO WHICH THE FOLLOWING CERTIFICATE WILL APPLY ARE BLUE LINE PRINTS SHOWING SURVEYOR'S ORIGINAL SEAL AND SIGNATURE IN BLACK INK. COPIES BY ANY OTHER MEANS MAY HAVE ALTERATIONS WHICH DO NOT REPRESENT THE SURVEYOR'S WORK PRODUCT.

I HEREBY CERTIFY THAT THE ABOVE DESCRIBED PROPERTY HAS BEEN SURVEYED UNDER MY DIRECTION AND THAT THE ABOVE MAP IS A TRUE REPRESENTATION THEREOF AND SHOWS THE SIZE AND LOCATION OF THE PROPERTY AND ITS EXTERIOR BOUNDARIES. THIS SURVEY IS MADE FOR THE USE OF THE PRESENT OWNERS OF THE PROPERTY, AND ALSO THOSE WHO PURCHASE, MORTGAGE, OR GUARANTEE THE TITLE THERETO WITHIN ONE YEAR FROM THE DATE HEREOF.

DATED: 10/21/97

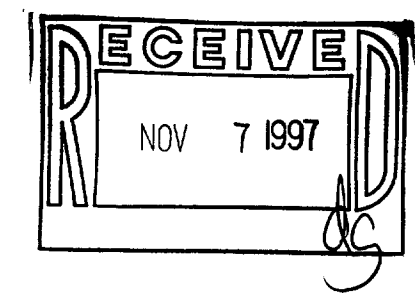

PETER S. GORDON  
R.L.S. 2101

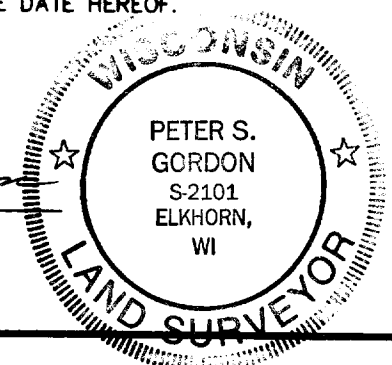

004-1074  
YTT-18