

Wisconsin Registered Land Surveyor S-1594

Rt. 3, Box 273 Elkhorn, Wisconsin 53121 Phone: (414) 723-4260 (office) (414) 723 7209 (FAX)

## PLAT OF SURVEY

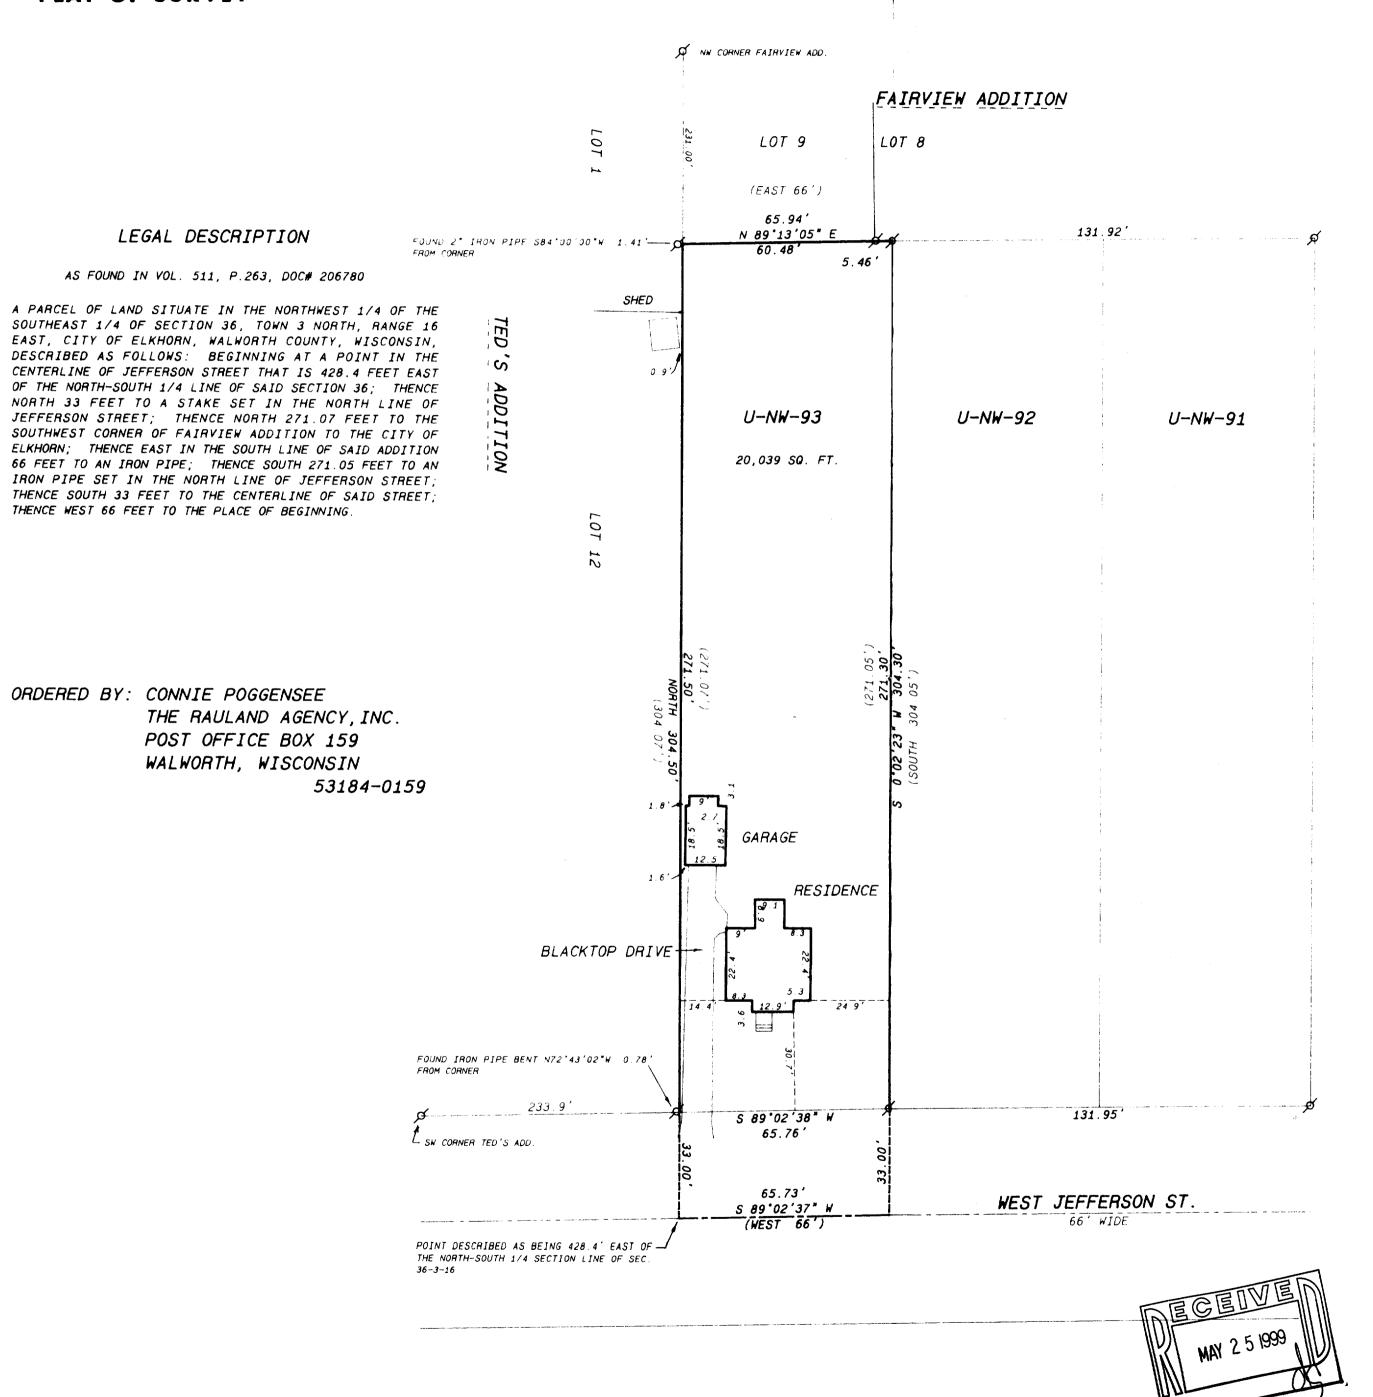

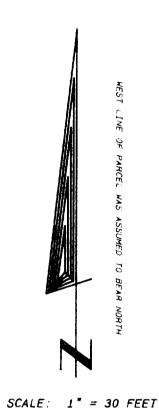

## Legend

- FOUND IRON PIPE FOUND IRON ROD
- FOUND BRASS CAPPED MONUMENT
- \* FOUND CONCRETE MONUMENT + CHISEL CUT IN CONCRETE
- SET IRON ROD, 24' LONG, WEIGHING 1.5 LBS LINEAL FT. 3 4 DIA
- SET IRON ROD, 30' LONG, WEIGHING 4.5 LBS LINEAL FT., 1-11-16" DIA

(KX) RECORDED AS DIMENSION EXISTING FENCE

SCALE: 1"= 30 FEET



i hereby certify that the above described property has been surveyed "I hirrory certify that the above described property has been surveyed by me or under my direction and that the above map is a true expresentation thereof and shows the size and location of the property its exterior boundaries the location of all principal buildings thereon boundary fences applianced assembles roadways and visible encroachments if any."

"This survey is made for the use of the present owners of the property and also those who purchase, mortgage, or guarantee the title thereto within one year from date hereof."

KENNETH B. ABERNATHY, JR WISCONSIN REGISTERED LAND SURVEYOR,

S-1594 Job No. 99.315