
PLAT OF SURVEY

LOT 90, HARVEST POINTE, being a part of lot 4 of certified survey map No. 2083, and a part of the Northeast 1/4, Northwest 1/4, Southeast 1/4 and the Southwest 1/4 of the Southwest 1/4 of Section 30, Town 3 North, Range 17 East, City of Elkhorn, Walworth County, Wisconsin.

Surveyed for: Bielinski Brothers Builders.



o FOUND 1º IRON PIPE

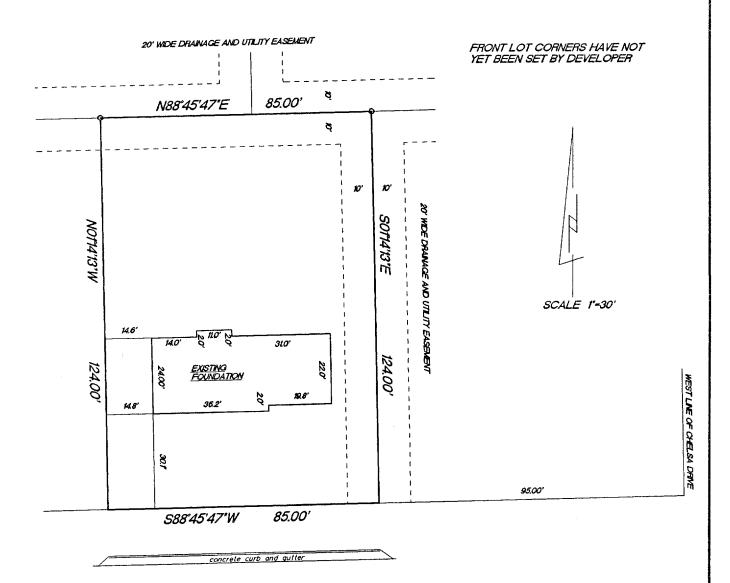

- MORNINGSIDE - STREET

66' WIDE

"I hereby certify that I have surveyed the above described property and that the above map is a true representation thereof and shows the size and location of the property, its exterior boundaries, the location of all visible structures and dimension of all principal buildings thereon, boundary fences, apparent easements, roadways and encroachments if any."

"This survey is made for the use of the present owners of the property, and also those who purchase, mortgage or guarantee the title thereto within one year from date hereof."

e thereto within one year from date hereof."

REV. 3/31/99

2/8/99

DATE

FIELD WORK BY



W362 S10227 Lewin Lane Eagle, Wisconsin 53119 Terrance E.Pisarek R.L.S.



(414) 594-3484 fax (414) 594-5904

THIS IS NOT AN ORIGINAL SURVEY UNLESS THE SEAL IS RED.

TE BRAWN BY

9828JOB NUMBER

YHP-90

004-1148