


59-16


4-112B

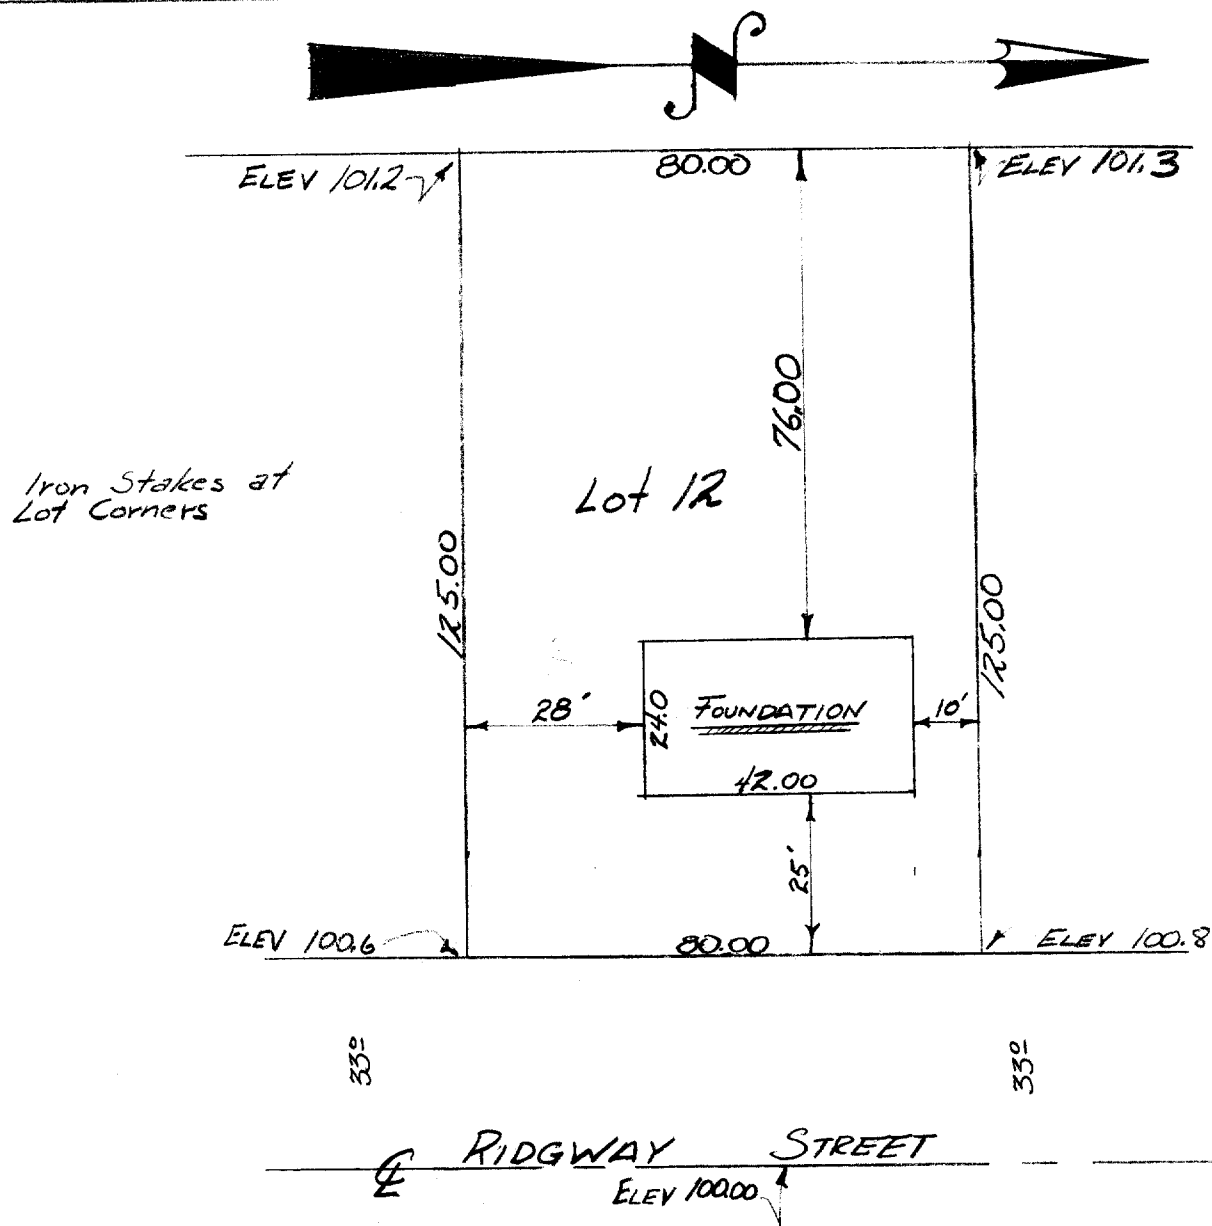

DESCRIPTION: Lot 12 of the Landmark Subdivision in the City of Elkhorn, Wisconsin.

CERTIFICATE: I James F. Biagi, Surveyor do hereby certify that I have surveyed the property hereon described and that the location of the improvements are as shown on the drawing above.

SIGNED AND SEALED THIS 2ND DAY OF JUNE 195

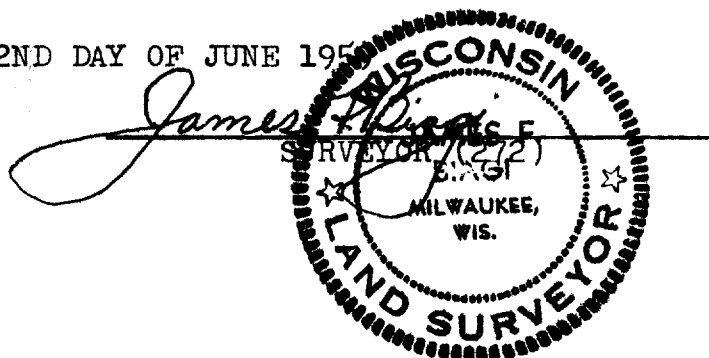

4-115B

4-112B

YLS-12